

OUTSIDE

1919

VOL. 2

A-C



Digitized by the Internet Archive
in 2019 with funding from
Sacramento County

<https://archive.org/details/SacCountyMapBook1919A-C>

Bk 2 a to C vol 2

Assessors Map Book
of
SACRAMENTO COUNTY
(Outside City Limits)
Accompanying Assessors Roll
for
1919

I hereby certify that the following is a true and correct Map of the lands embraced within the boundaries of **SACRAMENTO COUNTY (Outside City Limits)** exclusive of Sacramento City as drawn and compiled by me from official data and surveys of record.

Sacramento March 1st 191

County Surveyor.

Black Ink-1919 Ownership
Red Ink-1920 Ownership

being
Sec's 19 & 24 Rancho Del Paso
Scale: 1"=800'

Robt. S. II. Center S. D.

[illegible]

Mapped.

Lots 1 to 144 - 0th A. unless otherwise noted.

" 145 to 216 - 0th A.

" 217 to 296 - 1st A.

ACME ACRES

being the
N.E. 1/4 Sec. 10 Rancho Del Poso

Scale: 1"=400'

Black Ink-1919 Ownership

Red Ink-1920 Ownership

Blanks to Acme Realty Co. ✓

Robt. S. II
DRY GROVE S.D.

N. E. R. R.

200	201	202	203	204	205	206	207	208	209	210	211	212	213	214	215	216
✓	✓	✓	✓	✓	✓	✓	✓	✓	✓	✓	✓	✓	✓	✓	✓	✓
199	202	203	206	207	210	211	214	215								
✓	✓	✓	✓	✓	✓	✓	✓	✓	✓	✓	✓	✓	✓	✓	✓	✓

198	197	196	195	194	193	192	191	190								
✓	✓	✓	✓	✓	✓	✓	✓	✓	✓	✓	✓	✓	✓	✓	✓	✓
181	182	183	184	185	186	187	188	189								
✓	✓	✓	✓	✓	✓	✓	✓	✓	✓	✓	✓	✓	✓	✓	✓	✓

180	179	178	177	176	175	174	173	172								
✓	✓	✓	✓	✓	✓	✓	✓	✓	✓	✓	✓	✓	✓	✓	✓	✓
163	164	165	166	167	168	169	170	171								
✓	✓	✓	✓	✓	✓	✓	✓	✓	✓	✓	✓	✓	✓	✓	✓	✓

162	161	160	159	158	157	156	155	154								
✓	✓	✓	✓	✓	✓	✓	✓	✓	✓	✓	✓	✓	✓	✓	✓	✓
145	146	147	148	149	150	151	152	153								
✓	✓	✓	✓	✓	✓	✓	✓	✓	✓	✓	✓	✓	✓	✓	✓	✓

Joseph B. Jordan

Joseph B. Jordan

144	143	142	141	140	139	138	137	136								
✓	✓	✓	✓	✓	✓	✓	✓	✓	✓	✓	✓	✓	✓	✓	✓	✓
129	130	131	132	133	134	135	136	137								
✓	✓	✓	✓	✓	✓	✓	✓	✓	✓	✓	✓	✓	✓	✓	✓	✓

135	134	133	132	131	130	129	128	127								
✓	✓	✓	✓	✓	✓	✓	✓	✓	✓	✓	✓	✓	✓	✓	✓	✓
118	119	120	121	122	123	124	125	126								
✓	✓	✓	✓	✓	✓	✓	✓	✓	✓	✓	✓	✓	✓	✓	✓	✓

128	127	126	125	124	123	122	121	120								
✓	✓	✓	✓	✓	✓	✓	✓	✓	✓	✓	✓	✓	✓	✓	✓	✓
73	74	75	76	77	78	79	80	81								
✓	✓	✓	✓	✓	✓	✓	✓	✓	✓	✓	✓	✓	✓	✓	✓	✓

99	98	97	96	95	94	93	92	91								
✓	✓	✓	✓	✓	✓	✓	✓	✓	✓	✓	✓	✓	✓	✓	✓	✓
82	83	84	85	86	87	88	89	90								
✓	✓	✓	✓	✓	✓	✓	✓	✓	✓	✓	✓	✓	✓	✓	✓	✓

72	71	70	69	68	67	66	65	64								
✓	✓	✓	✓	✓	✓	✓	✓	✓	✓	✓	✓	✓	✓	✓	✓	✓
37	38	39	40	41	42	43	44	45								
✓	✓	✓	✓	✓	✓	✓	✓	✓	✓	✓	✓	✓	✓	✓	✓	✓

✓	✓	✓	✓	✓	✓	✓	✓	✓	✓	✓	✓	✓	✓	✓	✓	✓
223	226	239	242	255	258	271	274	287	290							
✓	✓	✓	✓	✓	✓	✓	✓	✓	✓	✓	✓	✓	✓	✓	✓	✓

Ella D. Covert

224	225	240	241	256	257	272	273	288	289							
✓	✓	✓	✓	✓	✓	✓	✓	✓	✓	✓	✓	✓	✓	✓	✓	✓
224	225	240	241	256	257	272	273	288	289							
✓	✓	✓	✓	✓	✓	✓	✓	✓	✓	✓	✓	✓	✓	✓	✓	✓

Clarence & Myrtle G.
Helms.

W. E. Wunsch

Black Ink=1919 Ownership

Red Ink=1920 Ownership

ALLUVIAL ACRES


located in

Sec. 8-17-18-19 & 20 T. 5 N. R. 5 E.

Scale: 1"=8 Chains

Може ли да се види

Blanks to Alluvial Farms Co. ✓✓
All Lots 20 Acres unless otherwise noted.

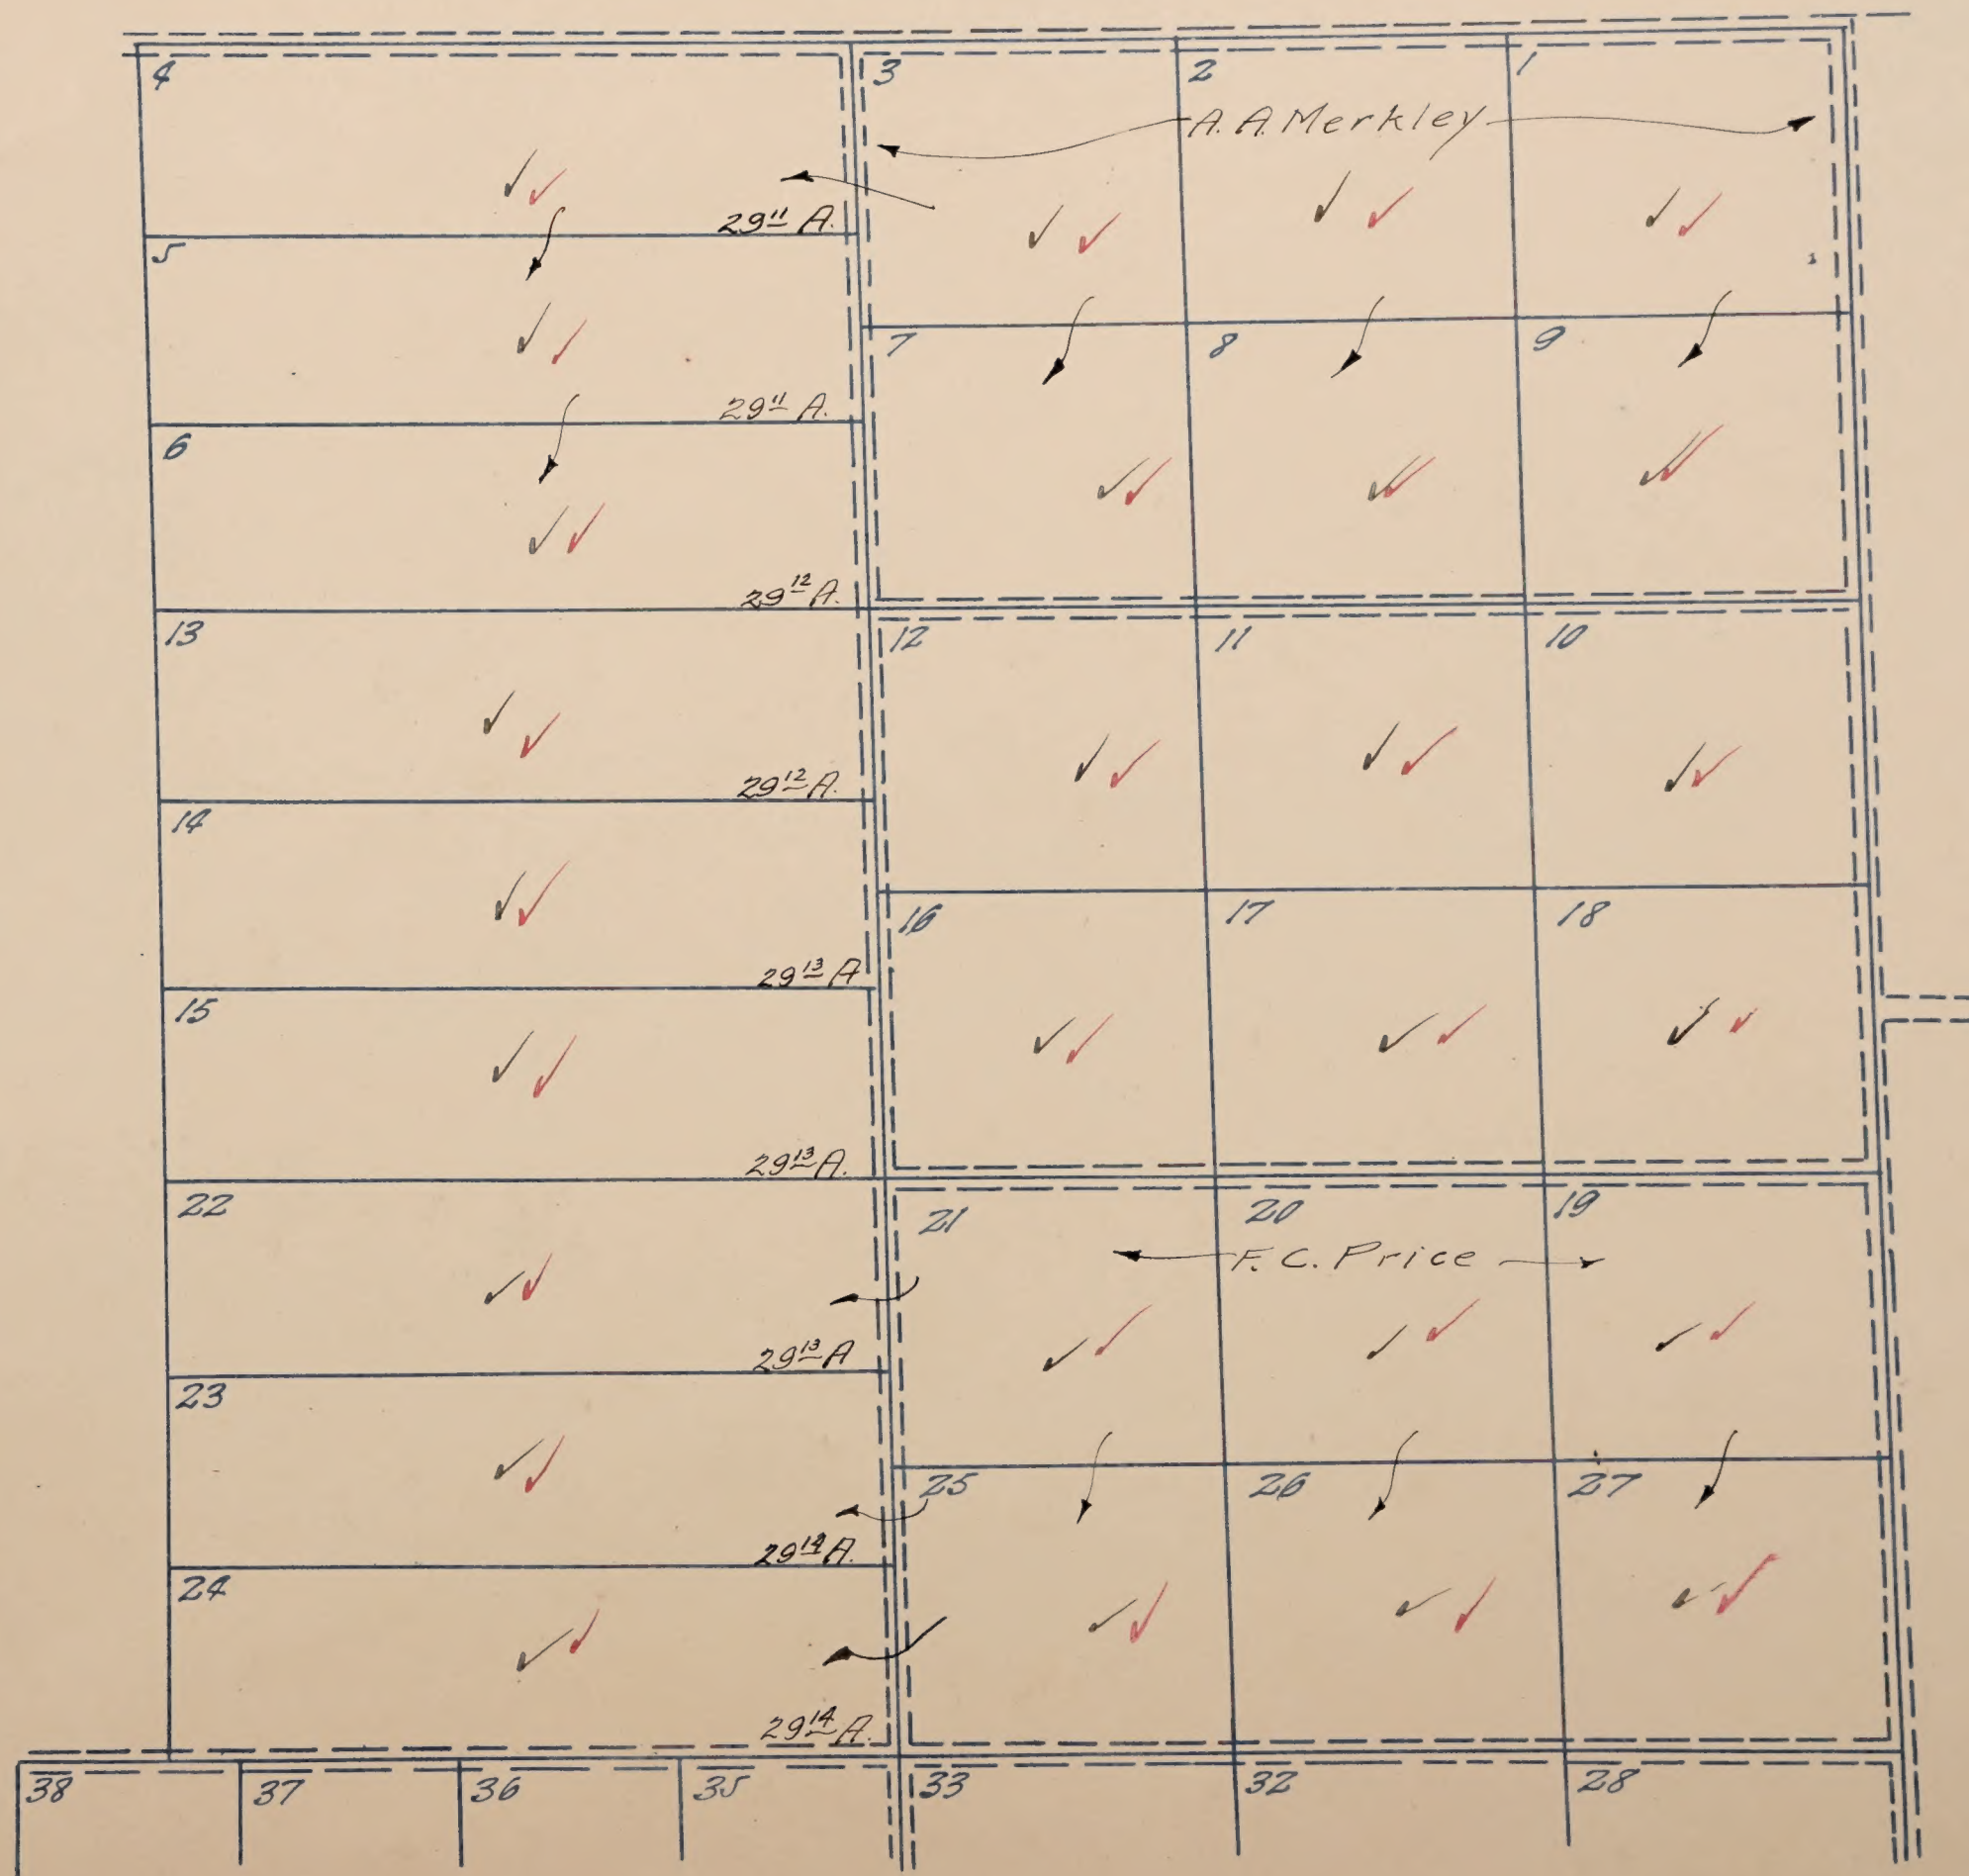

Maped.

Black Ink-1919 Ownership
Red Ink-1920 Ownership

ALLUVIAL ACRES

located in

Sec. 8-17-18-19&20 T5N R5E.

Scale: 1"=8 Chains

Blanks to Alluvial Farms Co. ✓✓ Mokolunne S.D.
All Lots 20 Acres unless otherwise noted.



Mapped.

ALMONDA

OR

BROOKE REALTY CO. SUBD. N^o 122


LOCATED IN THE

W. 1/2 of S.E. 1/4 of Sec. 21, T. 10 N., R. 6 E.

Scale: 200' = 1"

Black Ink-1919 Ownership
Red Ink-1920 Ownership

Dry Creek S. II.

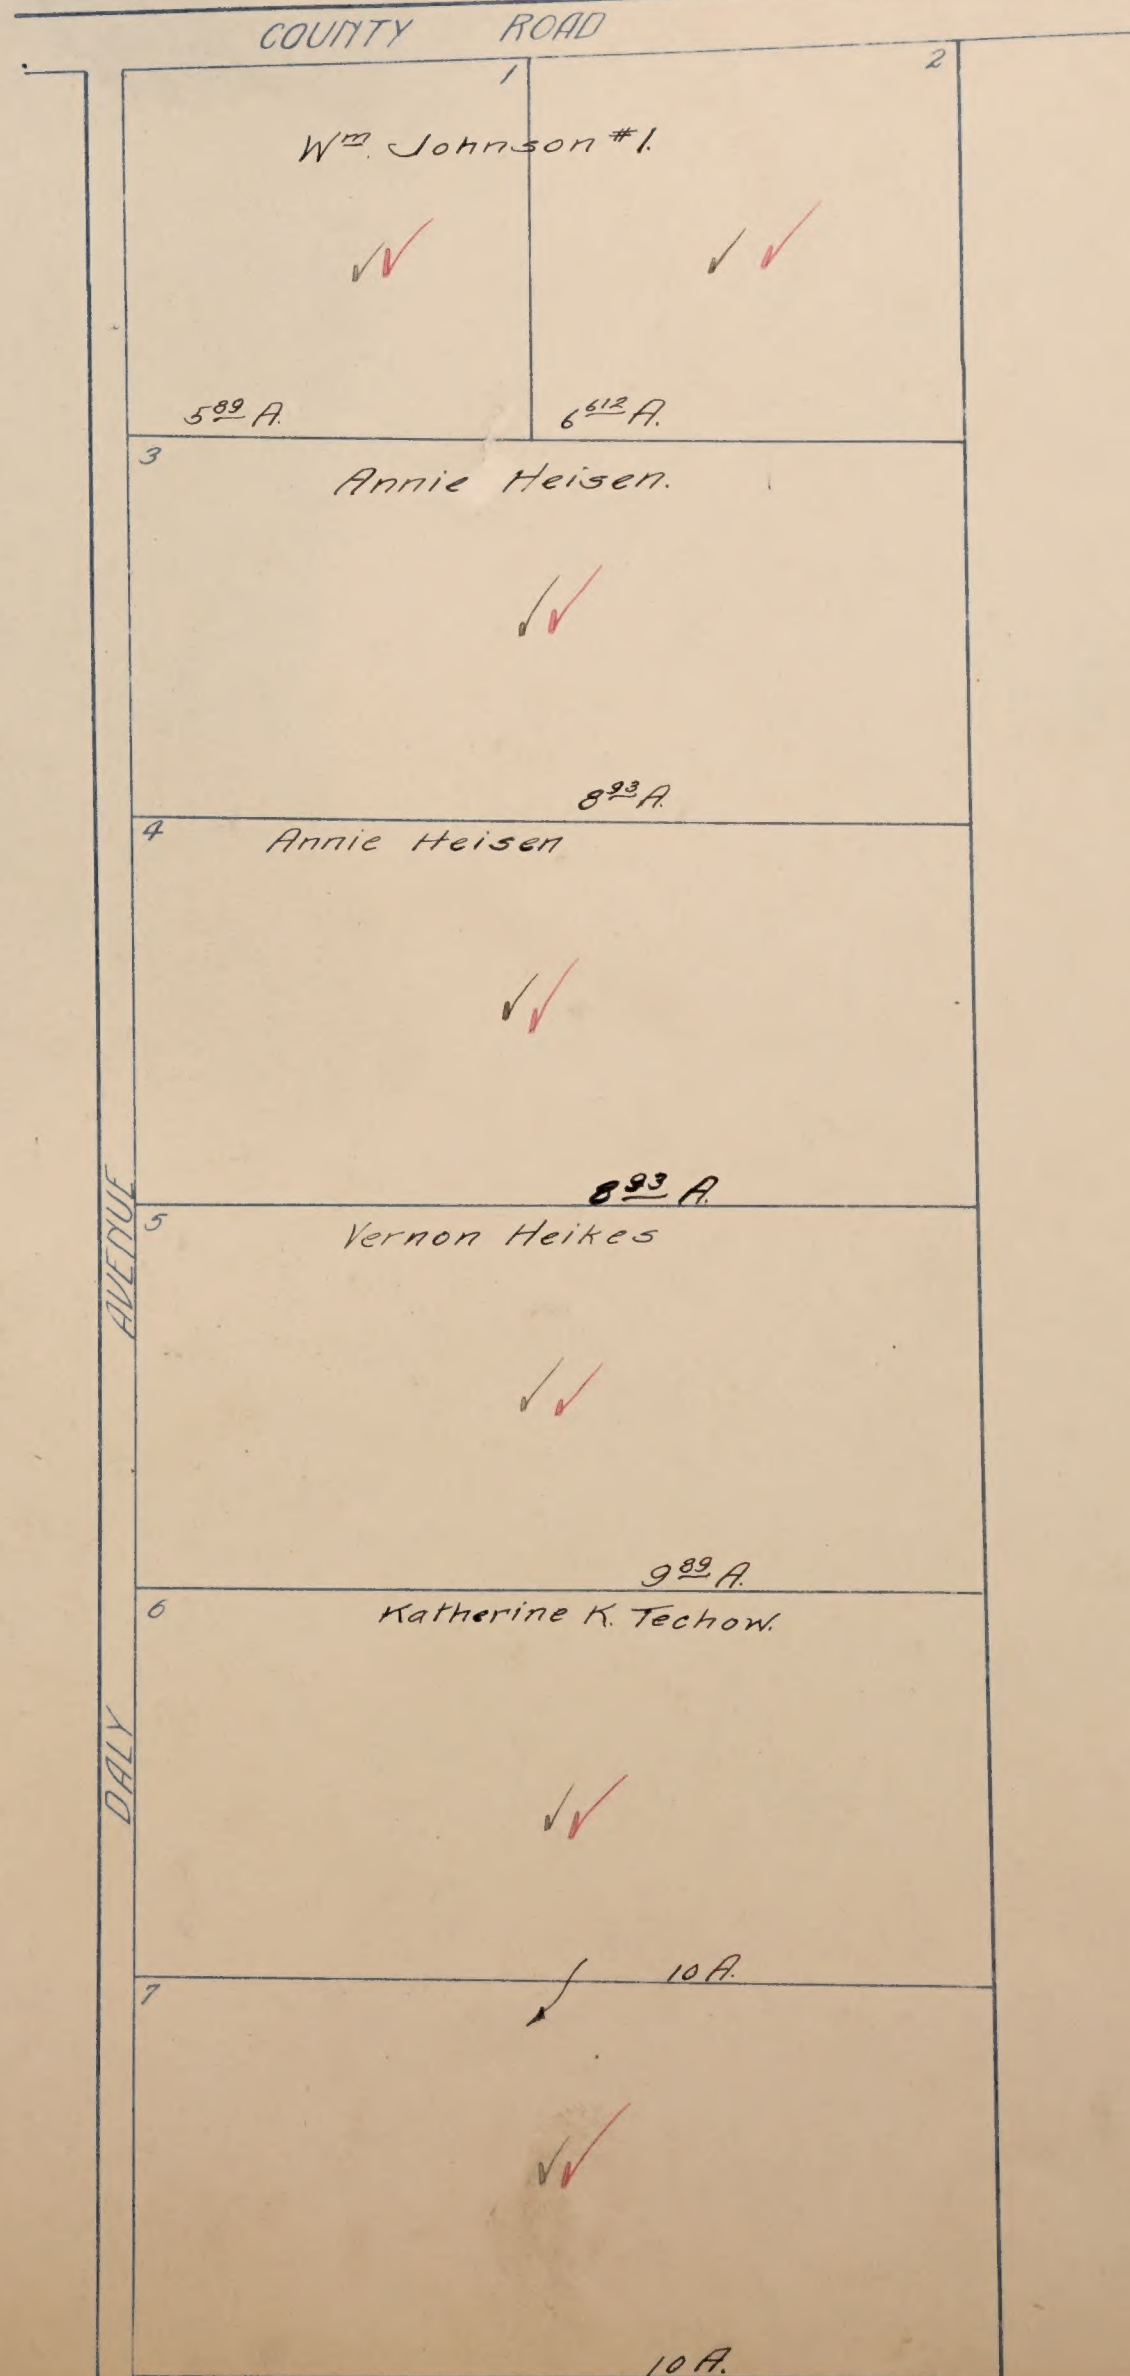

AVENUE

DAILY

ALMONDA

Mapped.

Black Ink=1919 Ownership

Red Ink=1920 Ownership

ALTA MESA TRACT

LOCATED IN


SECTION 4 OF T.6N.R.7E.

Lee. S.H.

All lots 1 Acre each

All blanks in Blk A to

James W. Graham

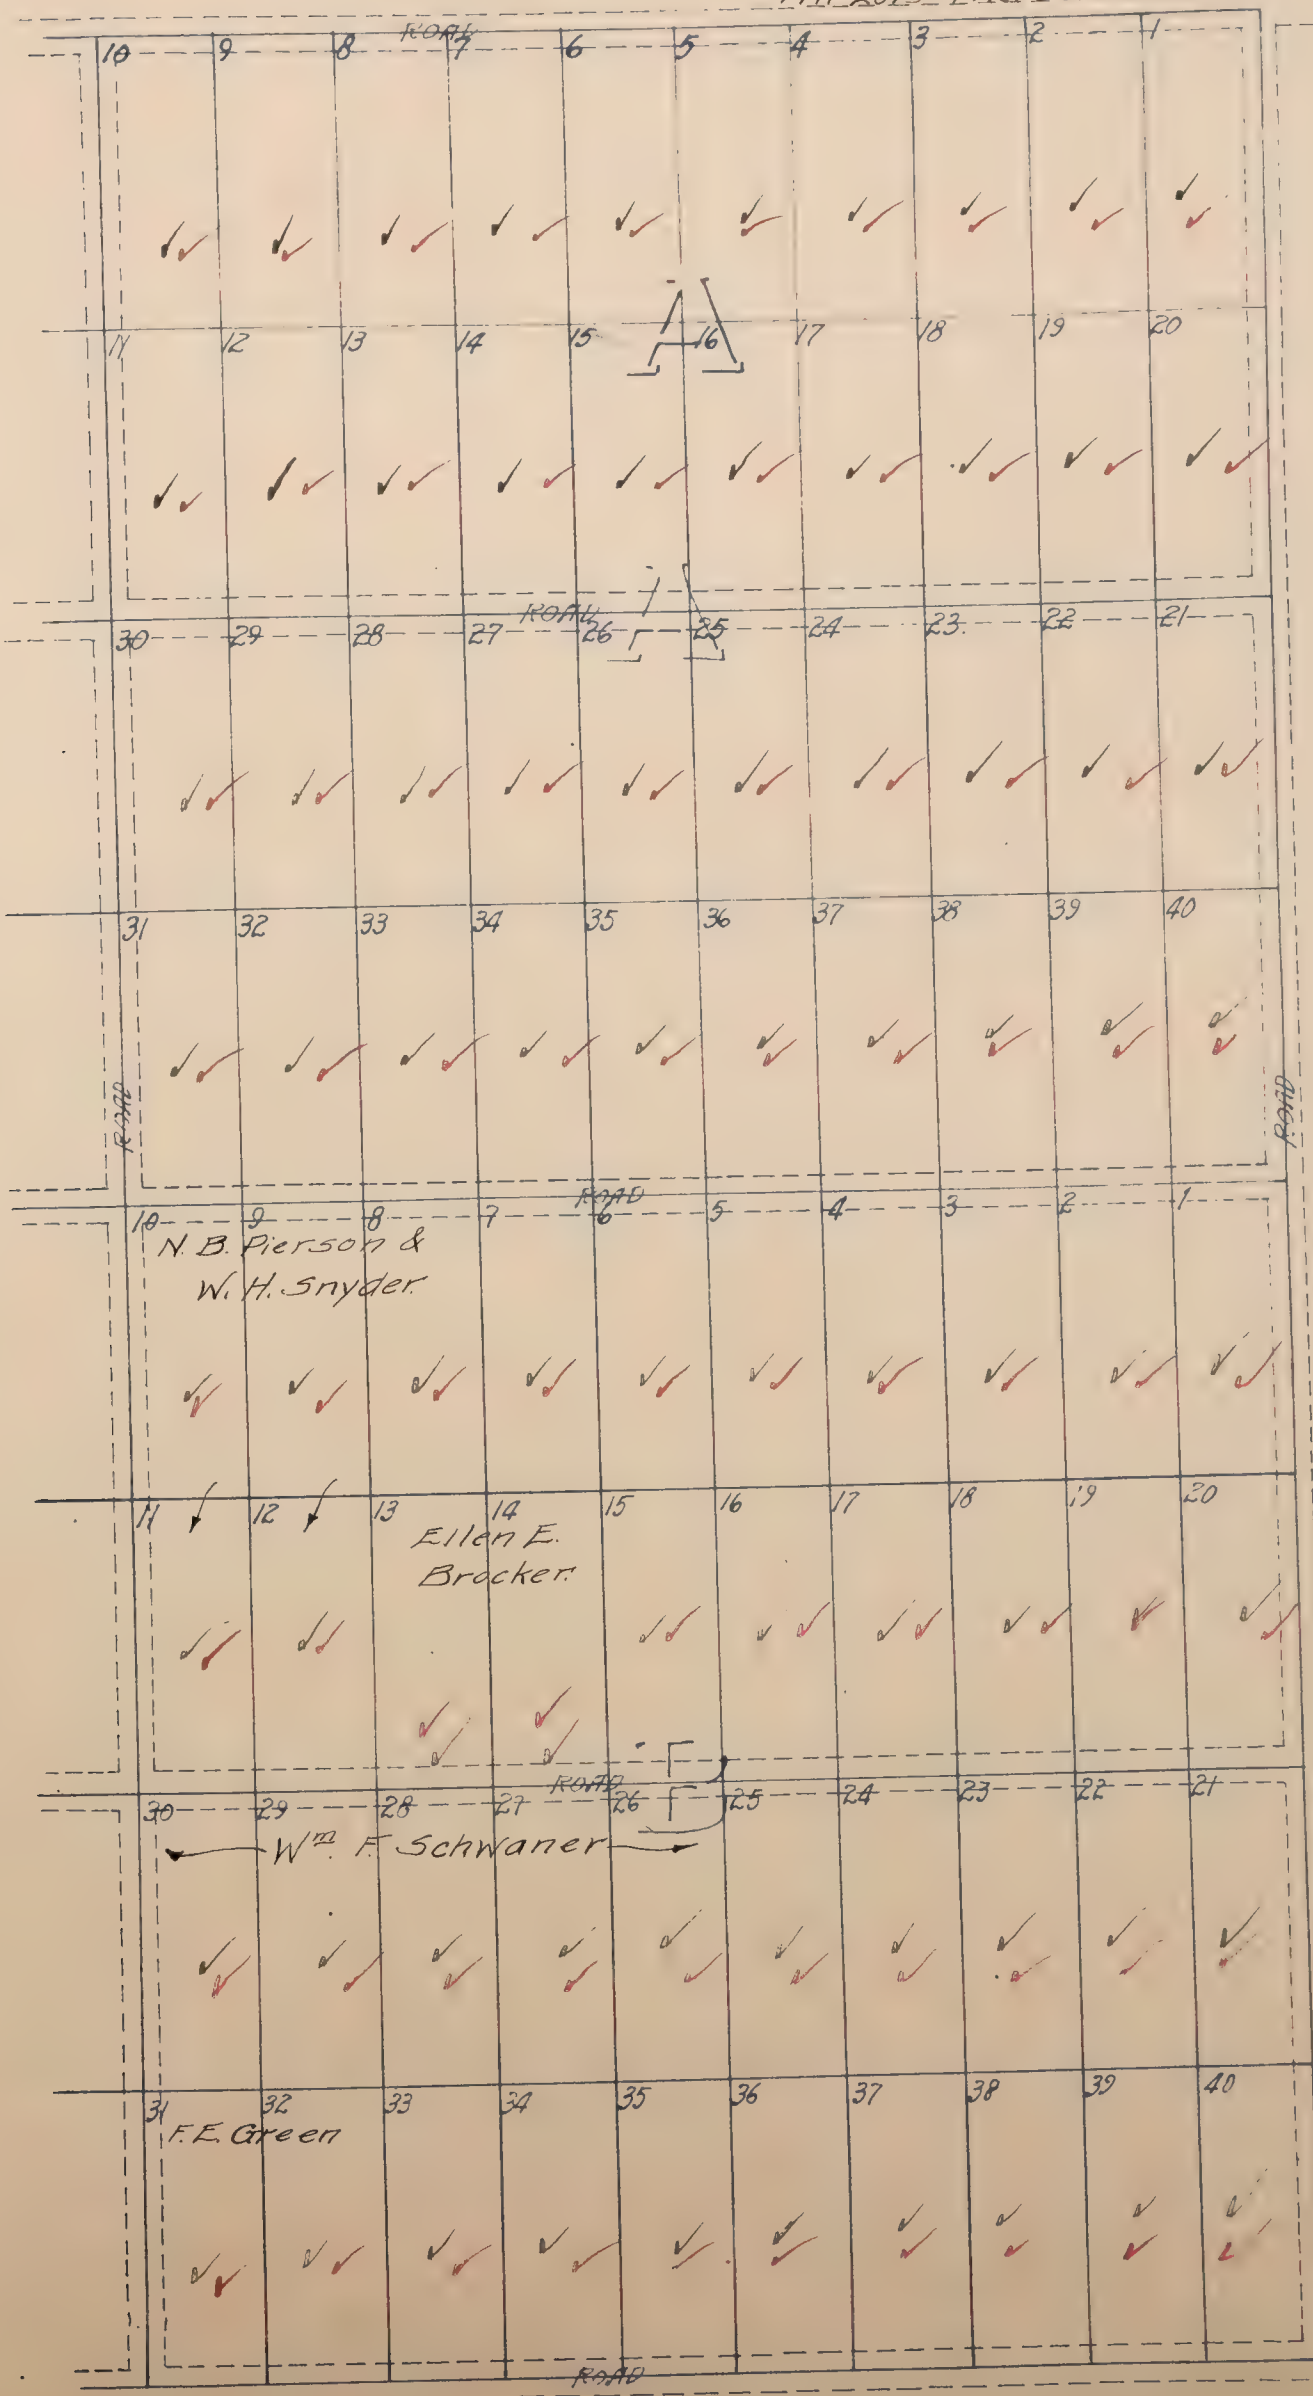

ALTA MESA

ALTA MESA TRACT

LOCATED IN
SECTION 4 OF T.6N.R.7E.

Black Ink-1919 Ownership
Red Ink-1920 Ownership

Lee S. II

Blanks in blocks E-F & G to Alta Mesa Land & Vineyard Co. ✓✓ All lots 1 Acre each

10	9	8	7	6	5	4	3	2	1	10	9	8	7	6	5	4	3	2	1
✓	✓	✓	✓	✓	✓	✓	✓	✓	✓	✓	✓	✓	✓	✓	✓	✓	✓	✓	✓
✓	✓	✓	✓	✓	✓	✓	✓	✓	✓	✓	✓	✓	✓	✓	✓	✓	✓	✓	✓
11	12	13	14	15	16	17	18	19	20	11	12	13	14	15	16	17	18	19	20
✓	✓	✓	✓	✓	✓	✓	✓	✓	✓	✓	✓	✓	✓	✓	✓	✓	✓	✓	✓
✓	✓	✓	✓	✓	✓	✓	✓	✓	✓	✓	✓	✓	✓	✓	✓	✓	✓	✓	✓
30	29	28	27	26	25	24	23	22	21	30	29	28	27	26	25	24	23	22	21
✓	✓	✓	✓	✓	✓	✓	✓	✓	✓	✓	✓	✓	✓	✓	✓	✓	✓	✓	✓
✓	✓	✓	✓	✓	✓	✓	✓	✓	✓	✓	✓	✓	✓	✓	✓	✓	✓	✓	✓
31	32	33	34	35	36	37	38	39	40	31	32	33	34	35	36	37	38	39	40
✓	✓	✓	✓	✓	✓	✓	✓	✓	✓	✓	✓	✓	✓	✓	✓	✓	✓	✓	✓
✓	✓	✓	✓	✓	✓	✓	✓	✓	✓	✓	✓	✓	✓	✓	✓	✓	✓	✓	✓
10	9	8	7	6	5	4	3	2	1	10	9	8	7	6	5	4	3	2	1
✓	✓	✓	✓	✓	✓	✓	✓	✓	✓	✓	✓	✓	✓	✓	✓	✓	✓	✓	✓
✓	✓	✓	✓	✓	✓	✓	✓	✓	✓	✓	✓	✓	✓	✓	✓	✓	✓	✓	✓
11	12	13	14	15	16	17	18	19	20	11	12	13	14	15	16	17	18	19	20
✓	✓	✓	✓	✓	✓	✓	✓	✓	✓	✓	✓	✓	✓	✓	✓	✓	✓	✓	✓
✓	✓	✓	✓	✓	✓	✓	✓	✓	✓	✓	✓	✓	✓	✓	✓	✓	✓	✓	✓
30	29	28	27	26	25	24	23	22	21	30	29	28	27	26	25	24	23	22	21
✓	✓	✓	✓	✓	✓	✓	✓	✓	✓	✓	✓	✓	✓	✓	✓	✓	✓	✓	✓
✓	✓	✓	✓	✓	✓	✓	✓	✓	✓	✓	✓	✓	✓	✓	✓	✓	✓	✓	✓
31	32	33	34	35	36	37	38	39	40	31	32	33	34	35	36	37	38	39	40
✓	✓	✓	✓	✓	✓	✓	✓	✓	✓	✓	✓	✓	✓	✓	✓	✓	✓	✓	✓
✓	✓	✓	✓	✓	✓	✓	✓	✓	✓	✓	✓	✓	✓	✓	✓	✓	✓	✓	✓

Blanks in block D to

James W. Graham ✓


Black Ink-1919 Ownership
Red Ink-1920 Ownership

AMERICAN RIVER

Scale, 600 feet = 1 inch

N. Sack, S.D.


AMERICAN

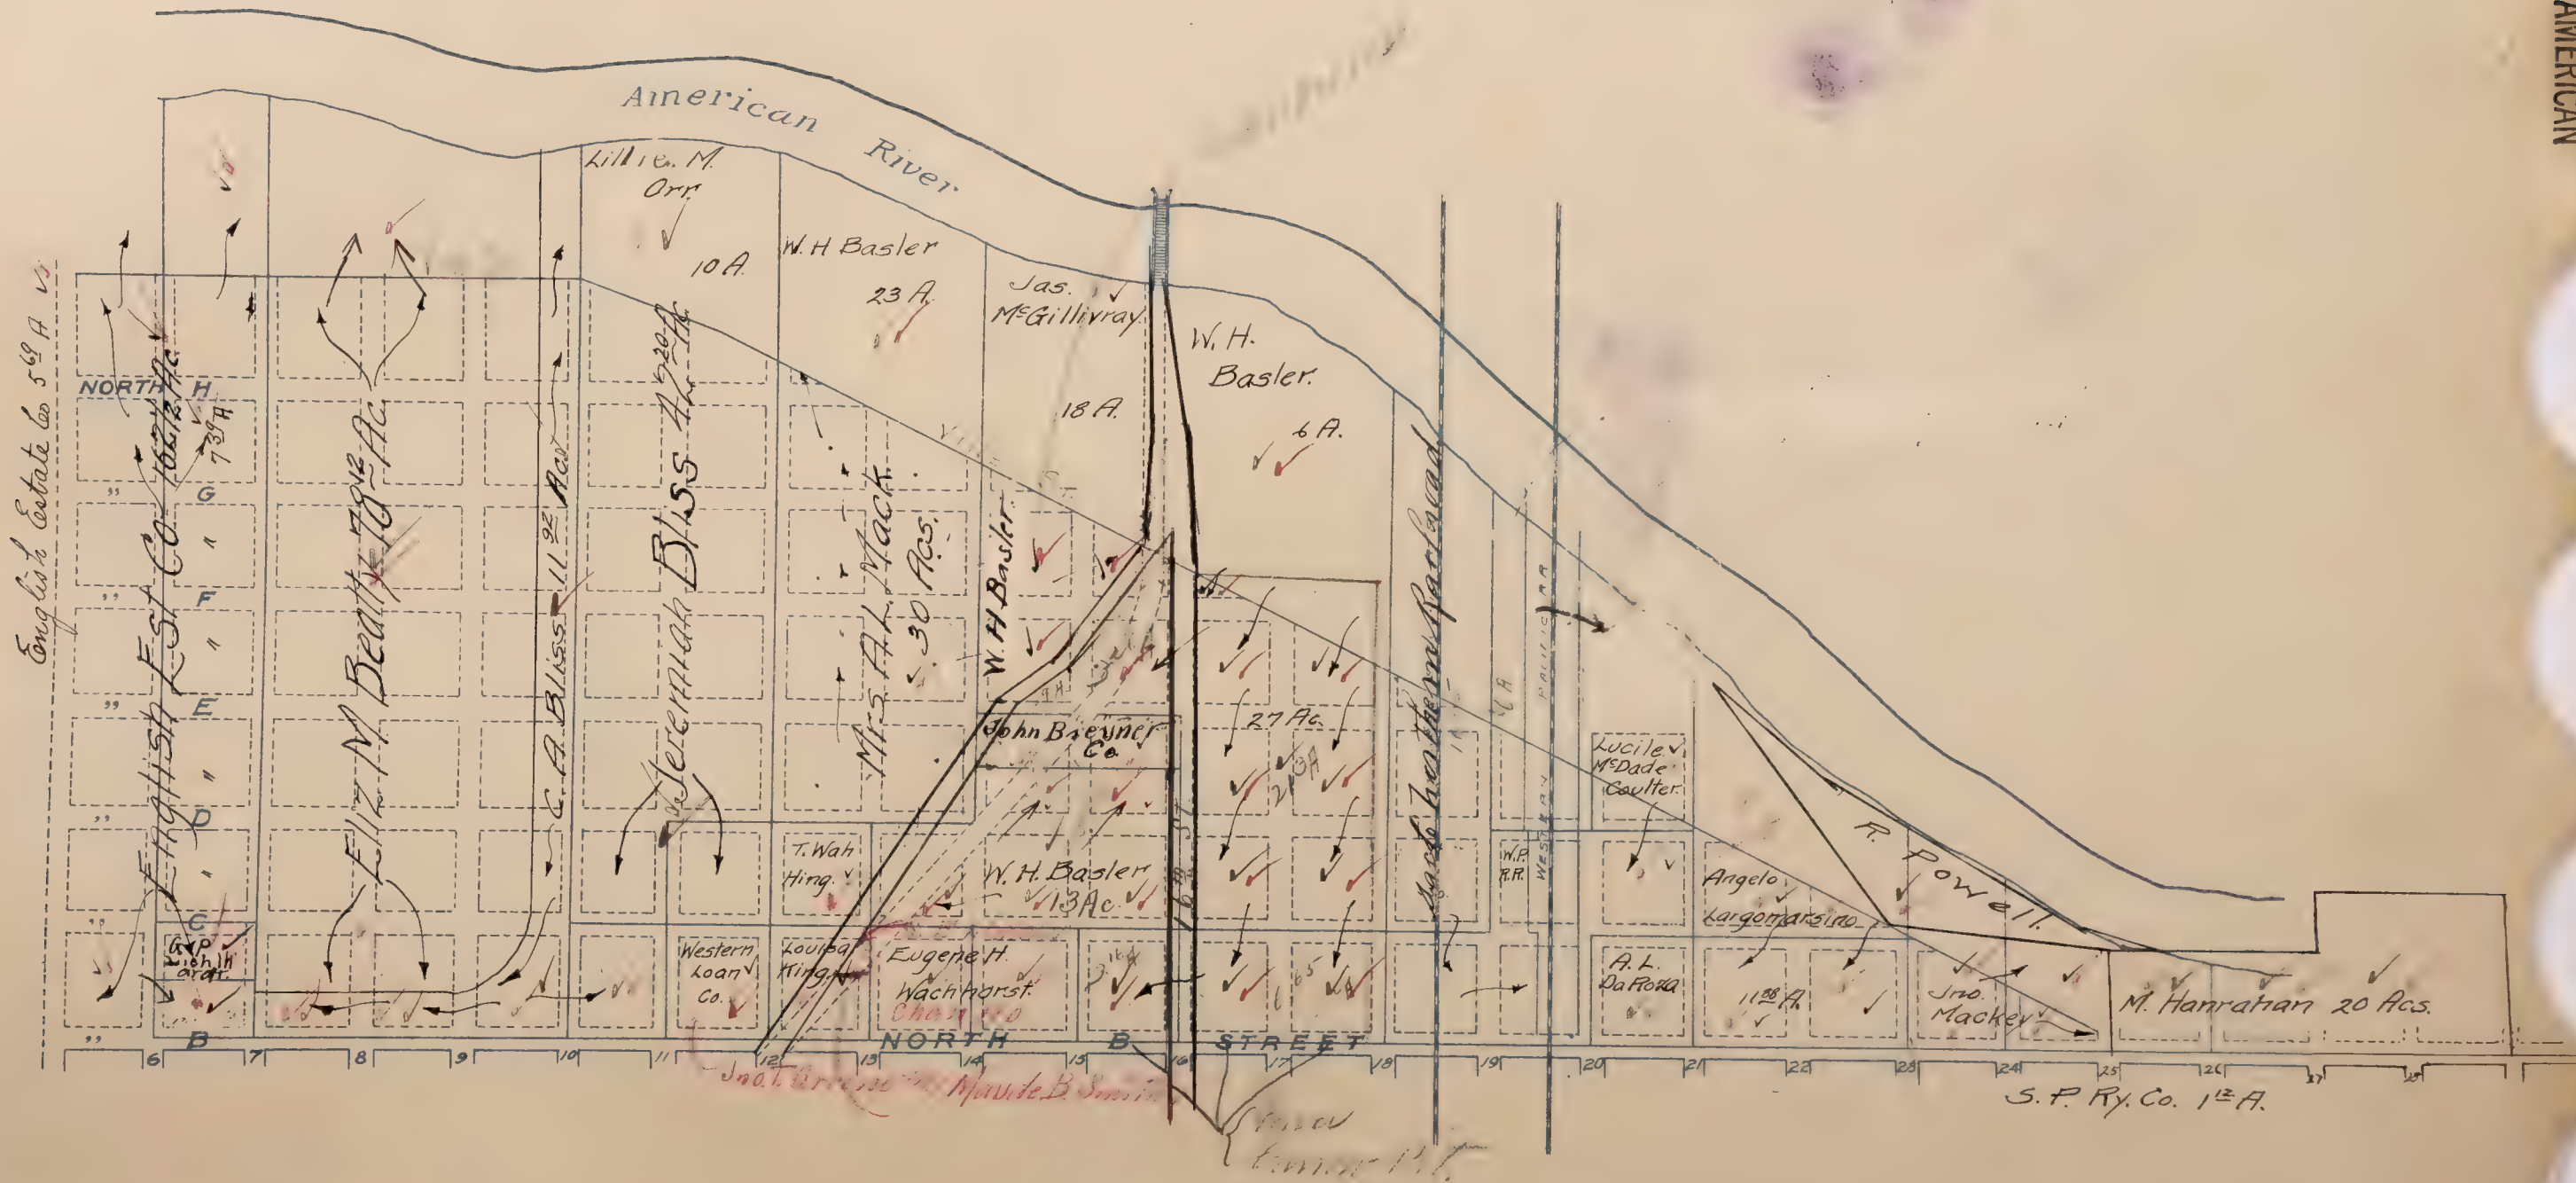

Black Ink-1919 Ownership
Red Ink-1920 Ownership
ANDERSON TRACT

LOCATED IN SEC. 29 T.8N.R.6E.
Scale, 8 chains = 1 inch

ENTERPRISE S. D.

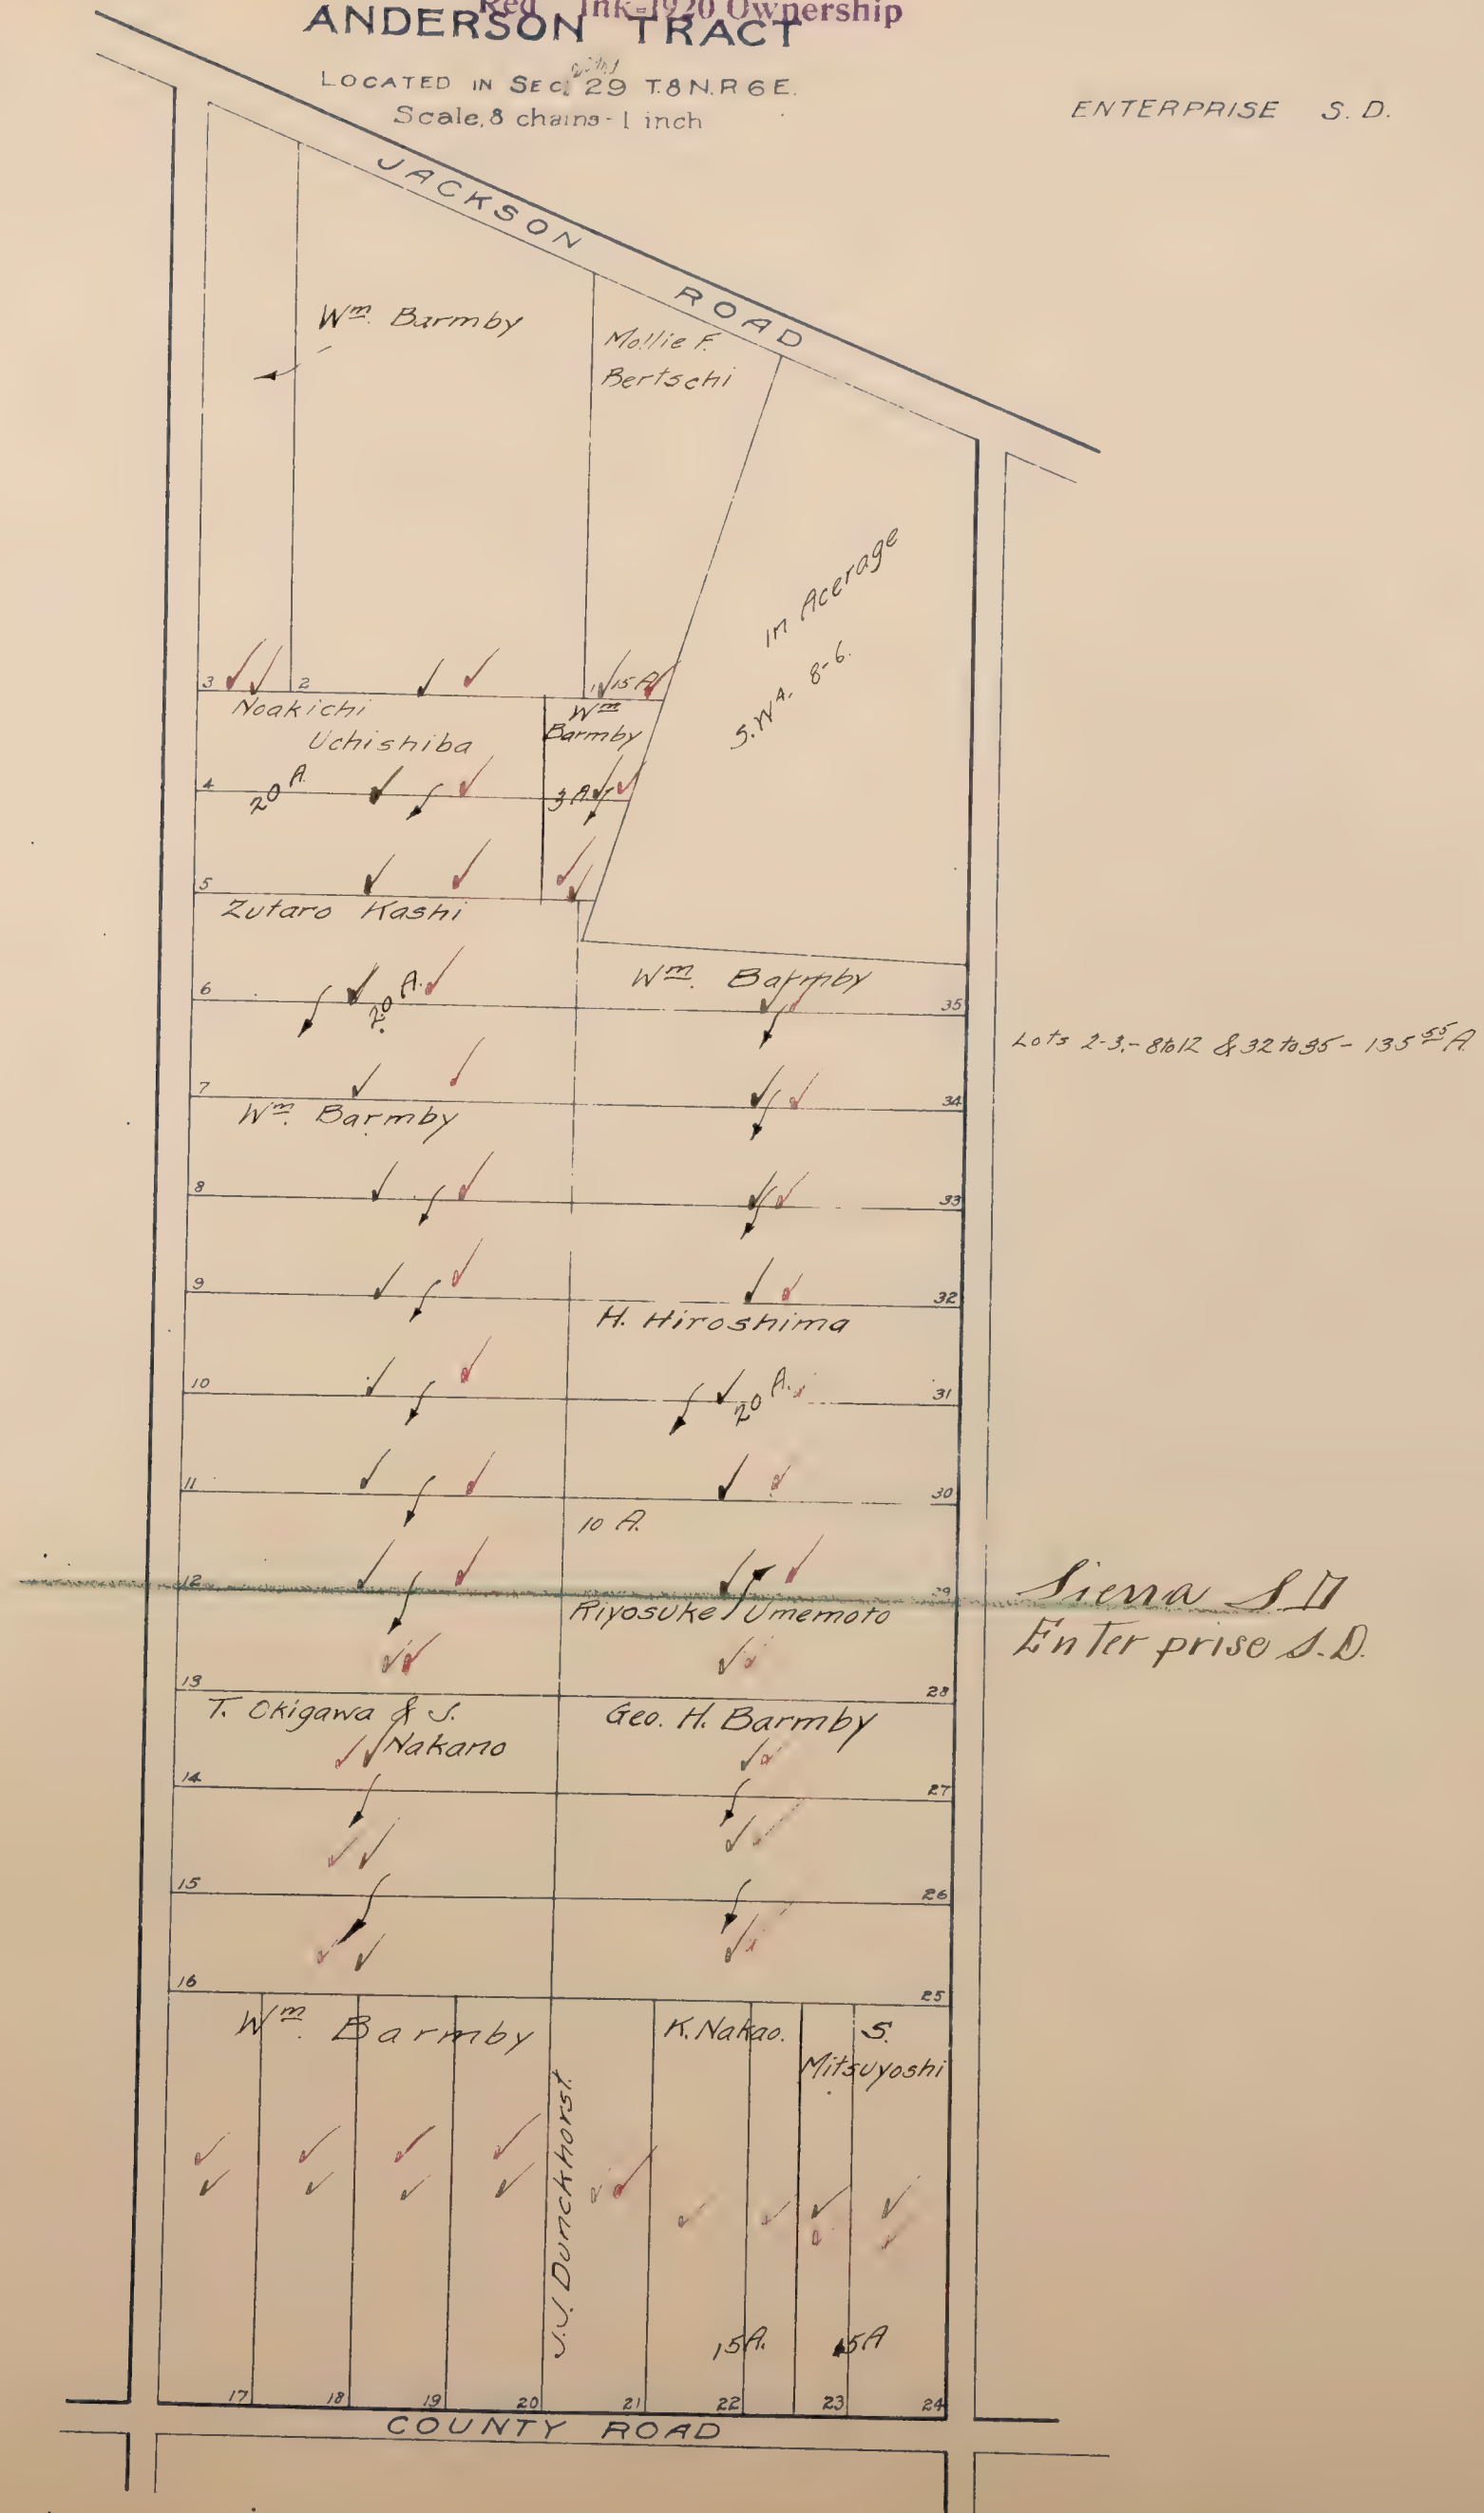

ANDERSON



DRY CREEK JT. S. D.

DEPOT

CENTRAL PACIFIC R. R.

FRONT

ST.

Exhibit 3 to Nor. Cal. Baptist Church

1	2	3	4
Edw.			
✓	Lauppe.	✓	→
✓	✓	✓	✓
✓	✓	✓	↗

1	2	3	4
C.W. & F. Laupe	E. A. A. & D. Astill	J. D. Laupe & C. W. Laupe.	
8'	0'	3'	11'

W ²² F ¹ Lewis.	2	3	4
	J. D. Lauppe.		
✓	✓	✓	✓

1	2	3	4
W ²² F. Lewis			
✓	✓	✓	✓

A handwritten diagram on a 4x4 grid. The top row contains four arrows pointing downwards. The second row contains four checkmarks. The third row contains the numbers 8, 7, 6, and 5 from left to right. The fourth row contains the text 'do.' in the second column and checkmarks in the first, third, and fourth columns.

J. D. & C. W. Lauppe			
✓	✓	✓	✓
8	7	6	5

J. D & C. W. Lauppe			Wm. C. Cavitt & Ida B. Butler
8	7	6	5

✓	✓	✓	✓
8	7	6	5

SECOND


ST.

ANTELOPE

Black Ink-1919 Ownership
Red Ink-1920 Ownership

located in
Sec's 32-39-40-45-46 Rancho Del Paso
Scale 1" = 400ft

Blanks to Arcade Park Co. ✓ Arcade SD

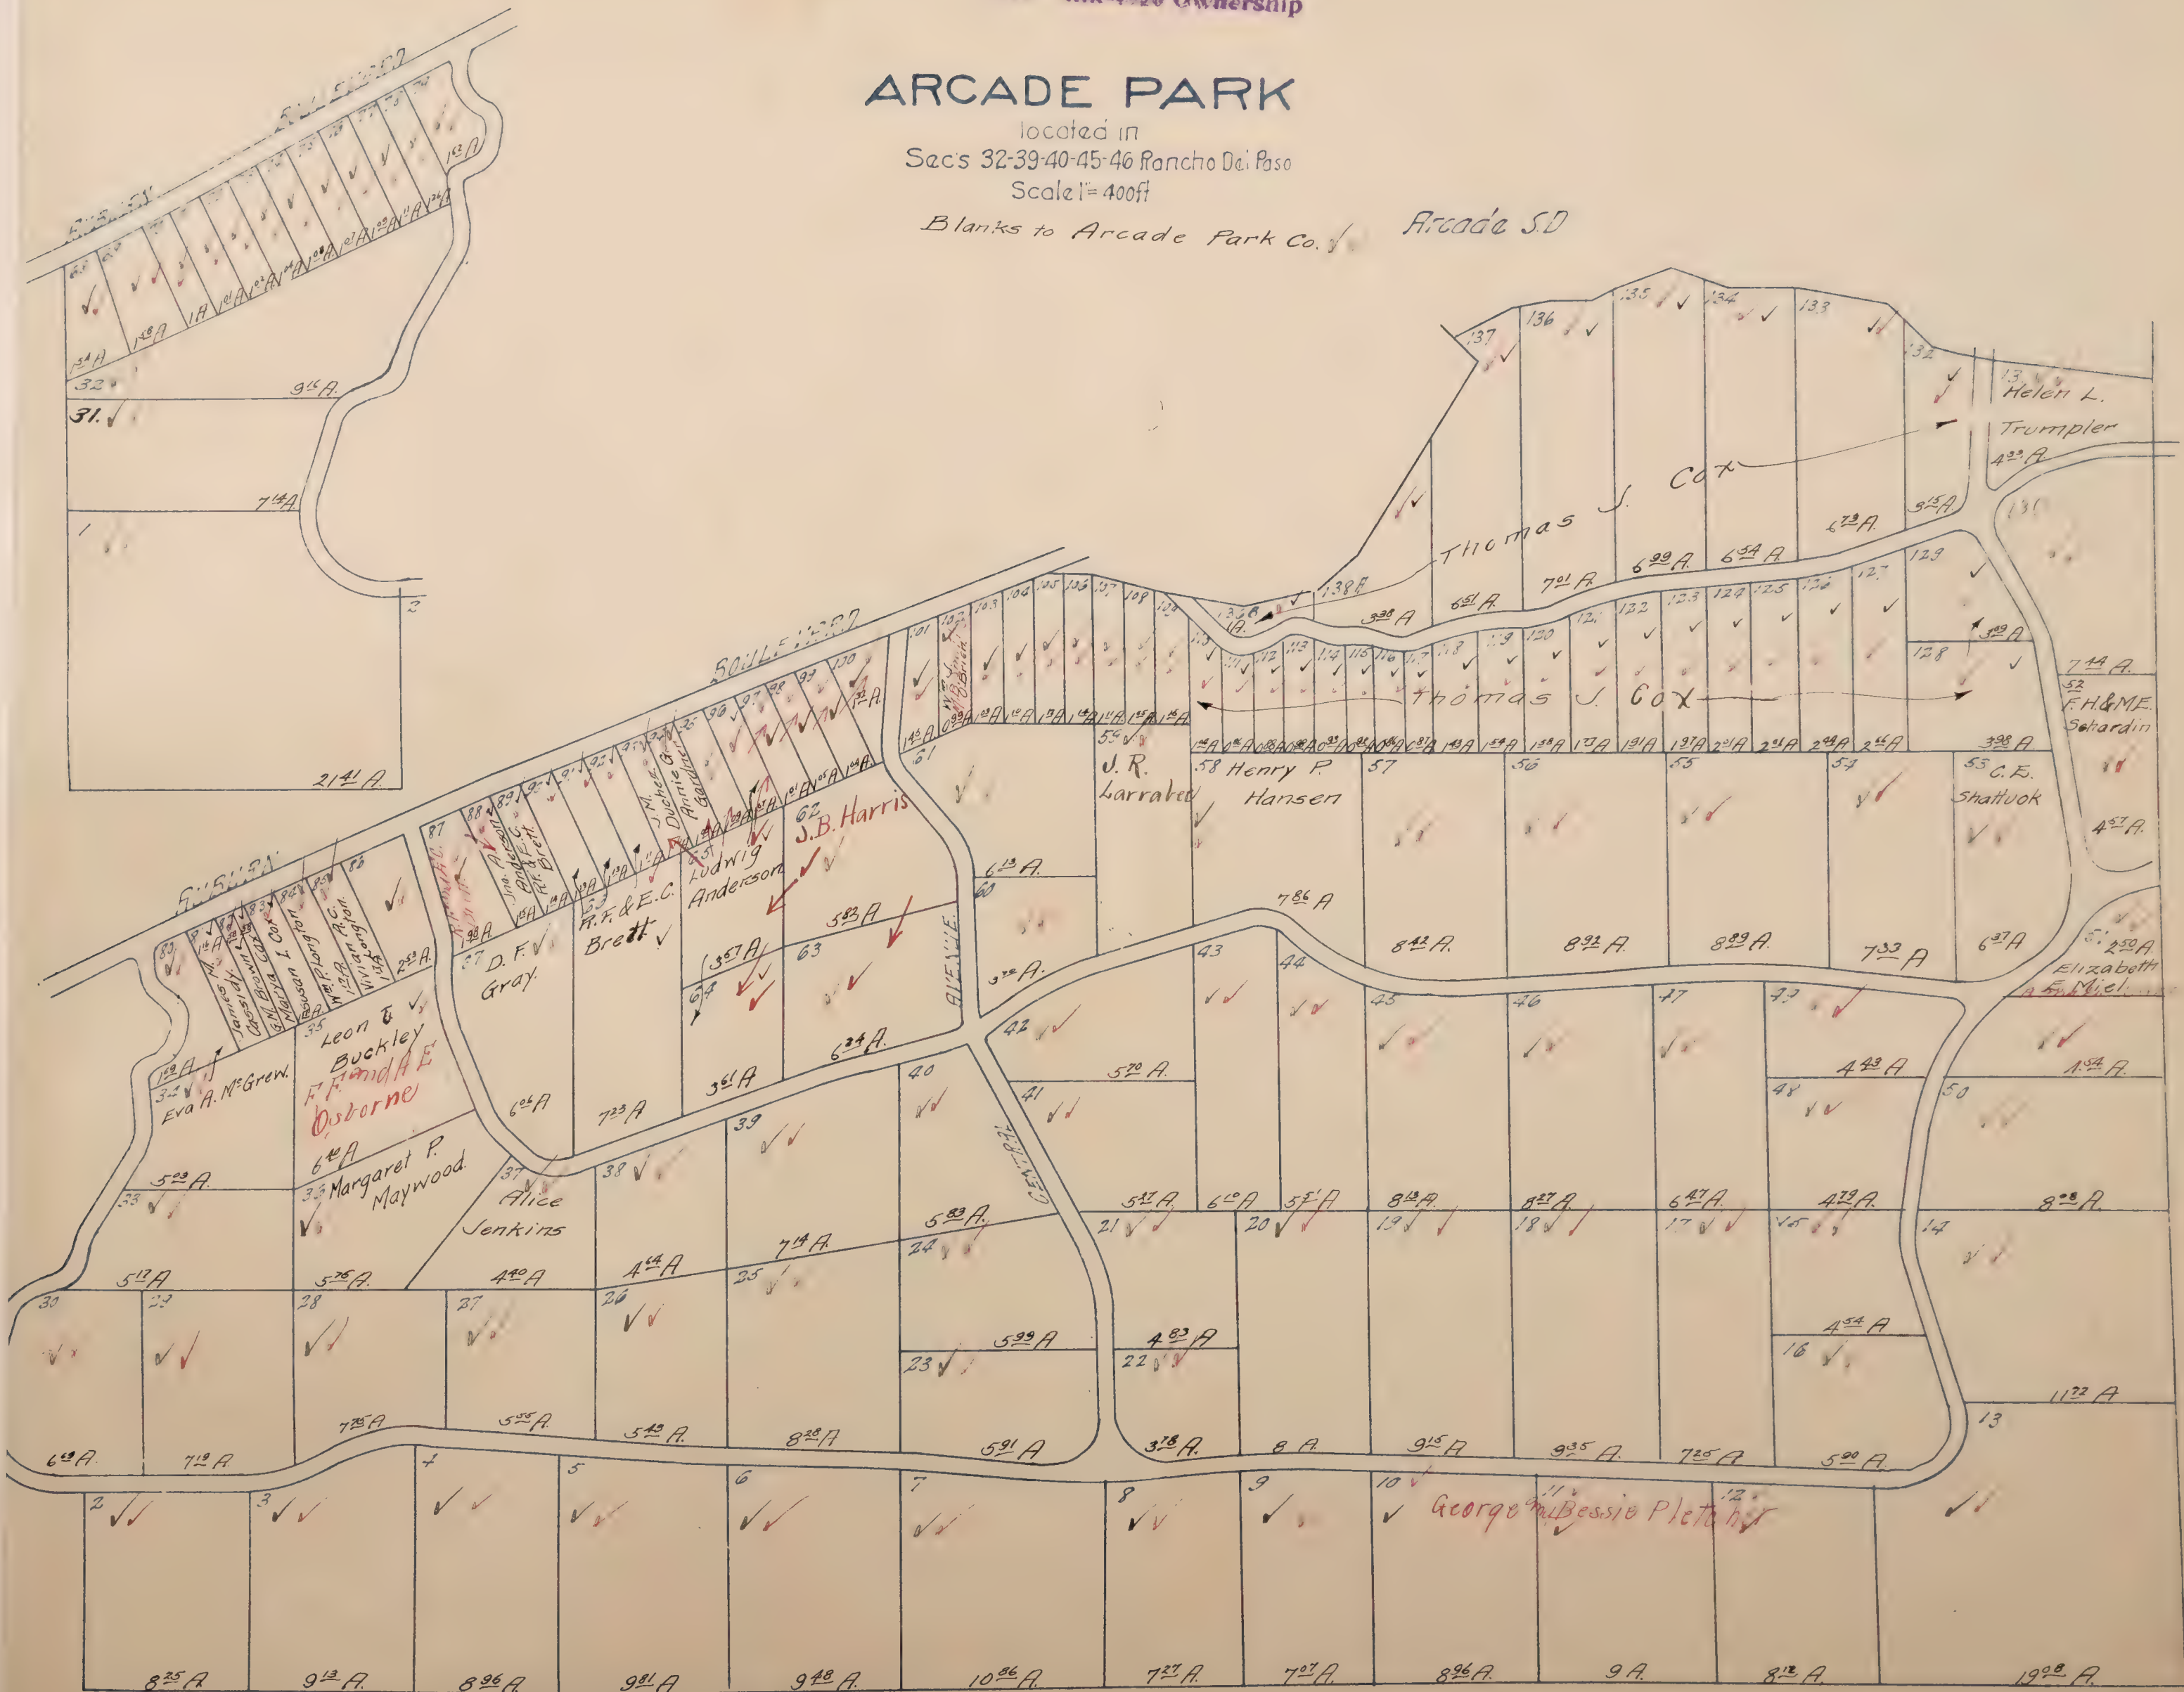

ARCADE

Blanks to Arcade Park Co. ✓



Mapped.

ARCADE PARK

located in
Section 32-39 Rancho Del Paso
Scale 1"=400 ft

Black Ink-1919 Ownership
Red Ink-1920 Ownership

ArCADE S.D.

Blanks to Arcade Park Co. ✓✓




Black Ink-1919 Ownership
Red Ink-1929 Ownership

ARDMORE HEIGHTS

LOCATED IN
S.E. 1/4 of Section 12 T.10N R.4E.
Scale: 200 feet = 1 inch.

Lincoln S.D.

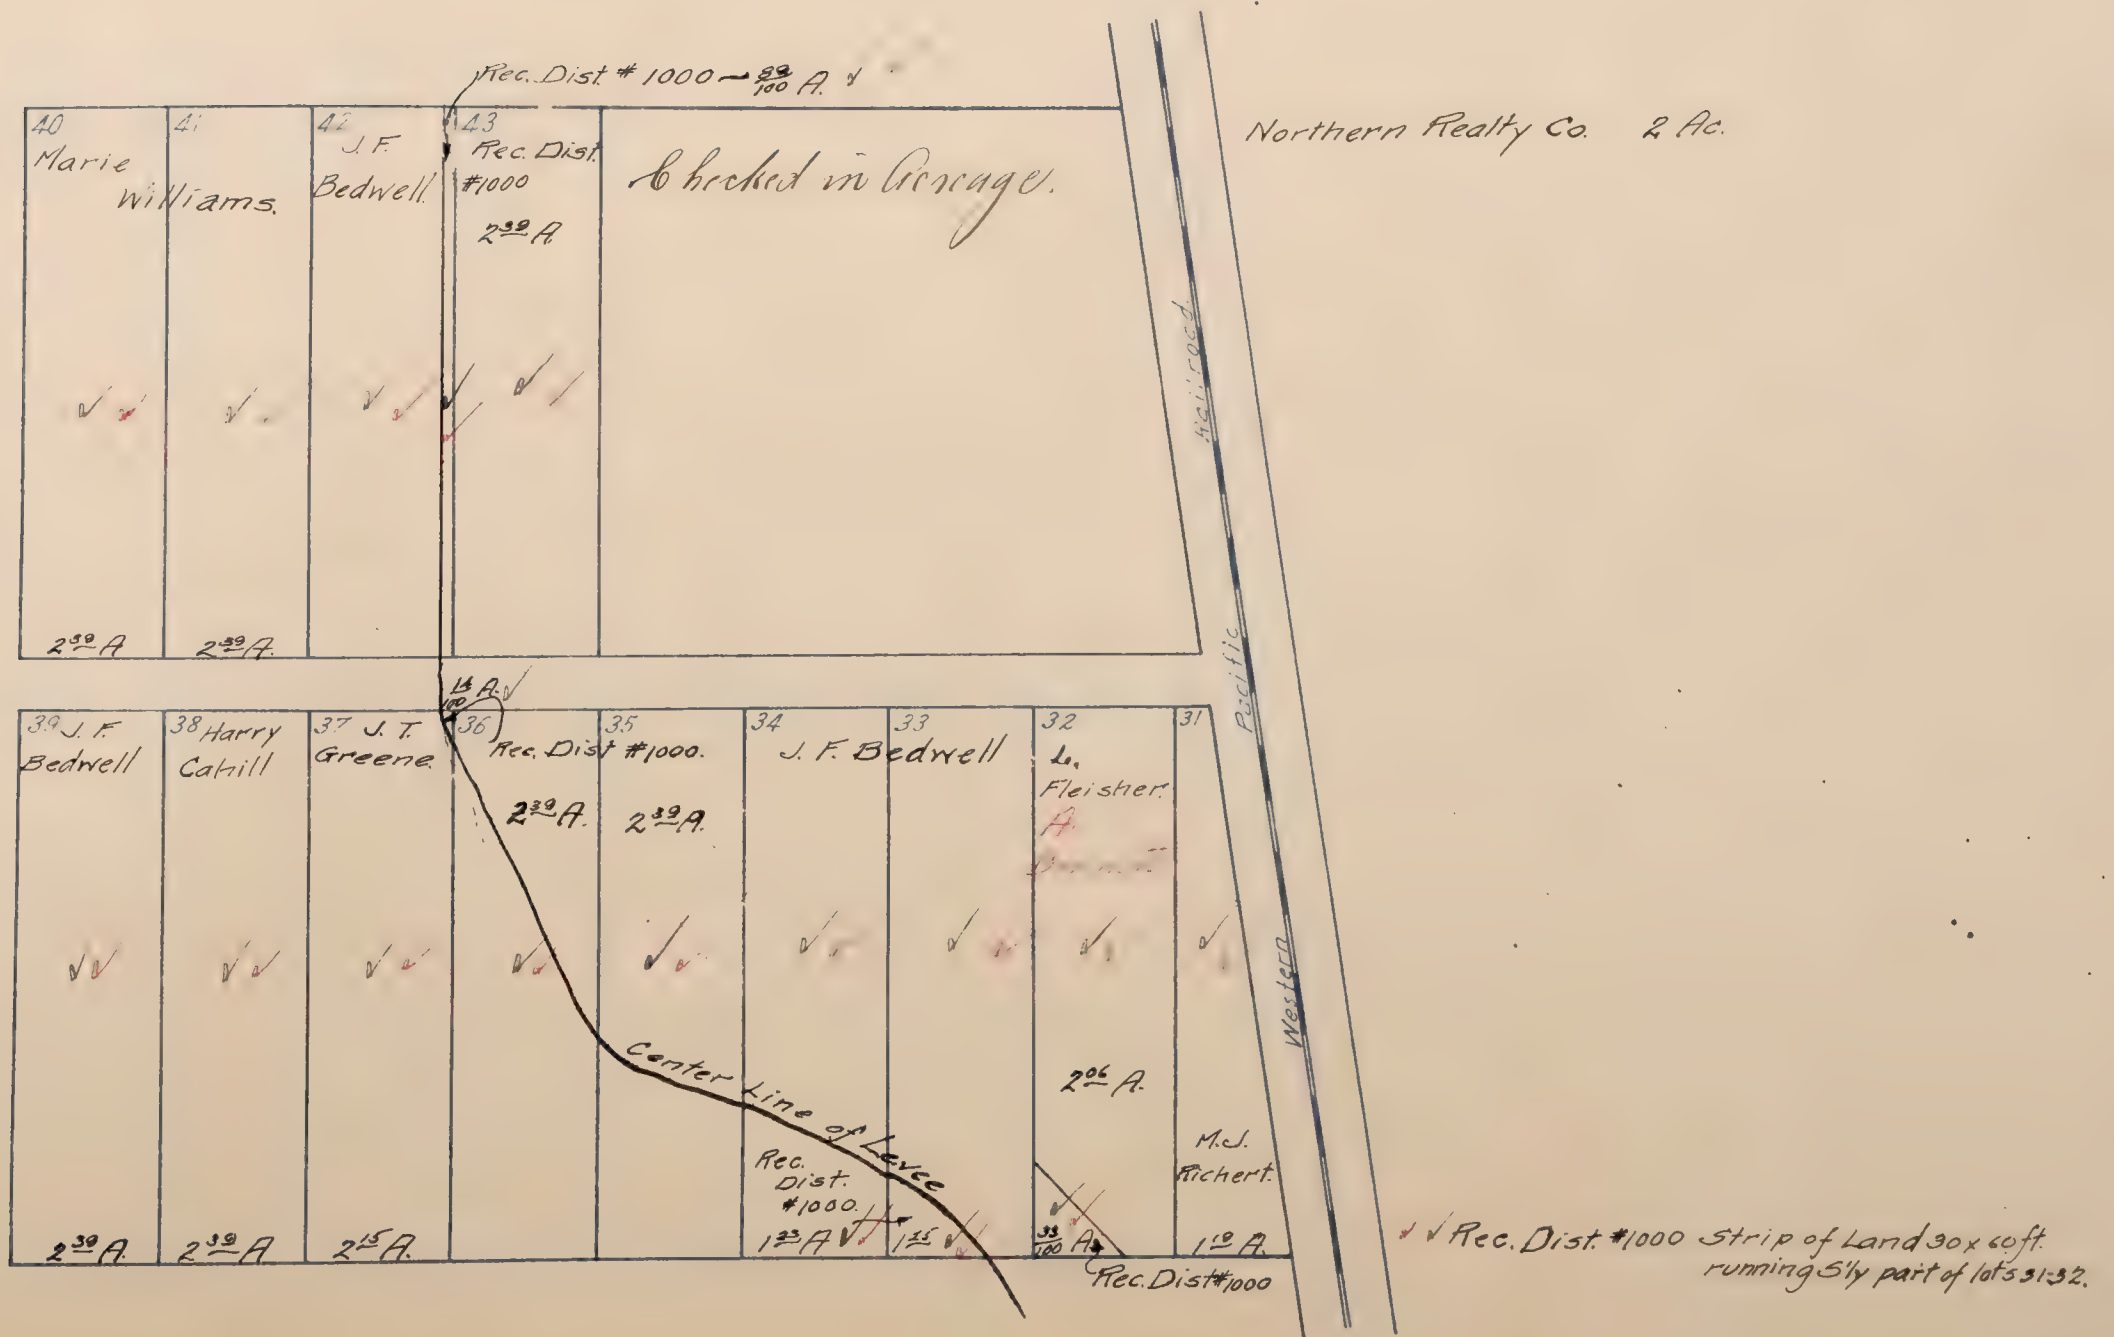


Mapped.
Blanks assessed to J.F. Bedwell.

ARDMORE HEIGHTS

LOCATED IN
SE. 1/4 of Section 12 T.10 N. R. 4 E
Scale: 100 feet = 1 inch.

Black Ink=1919 Ownership
Red Ink=1920 Ownership
Lincoln SD.

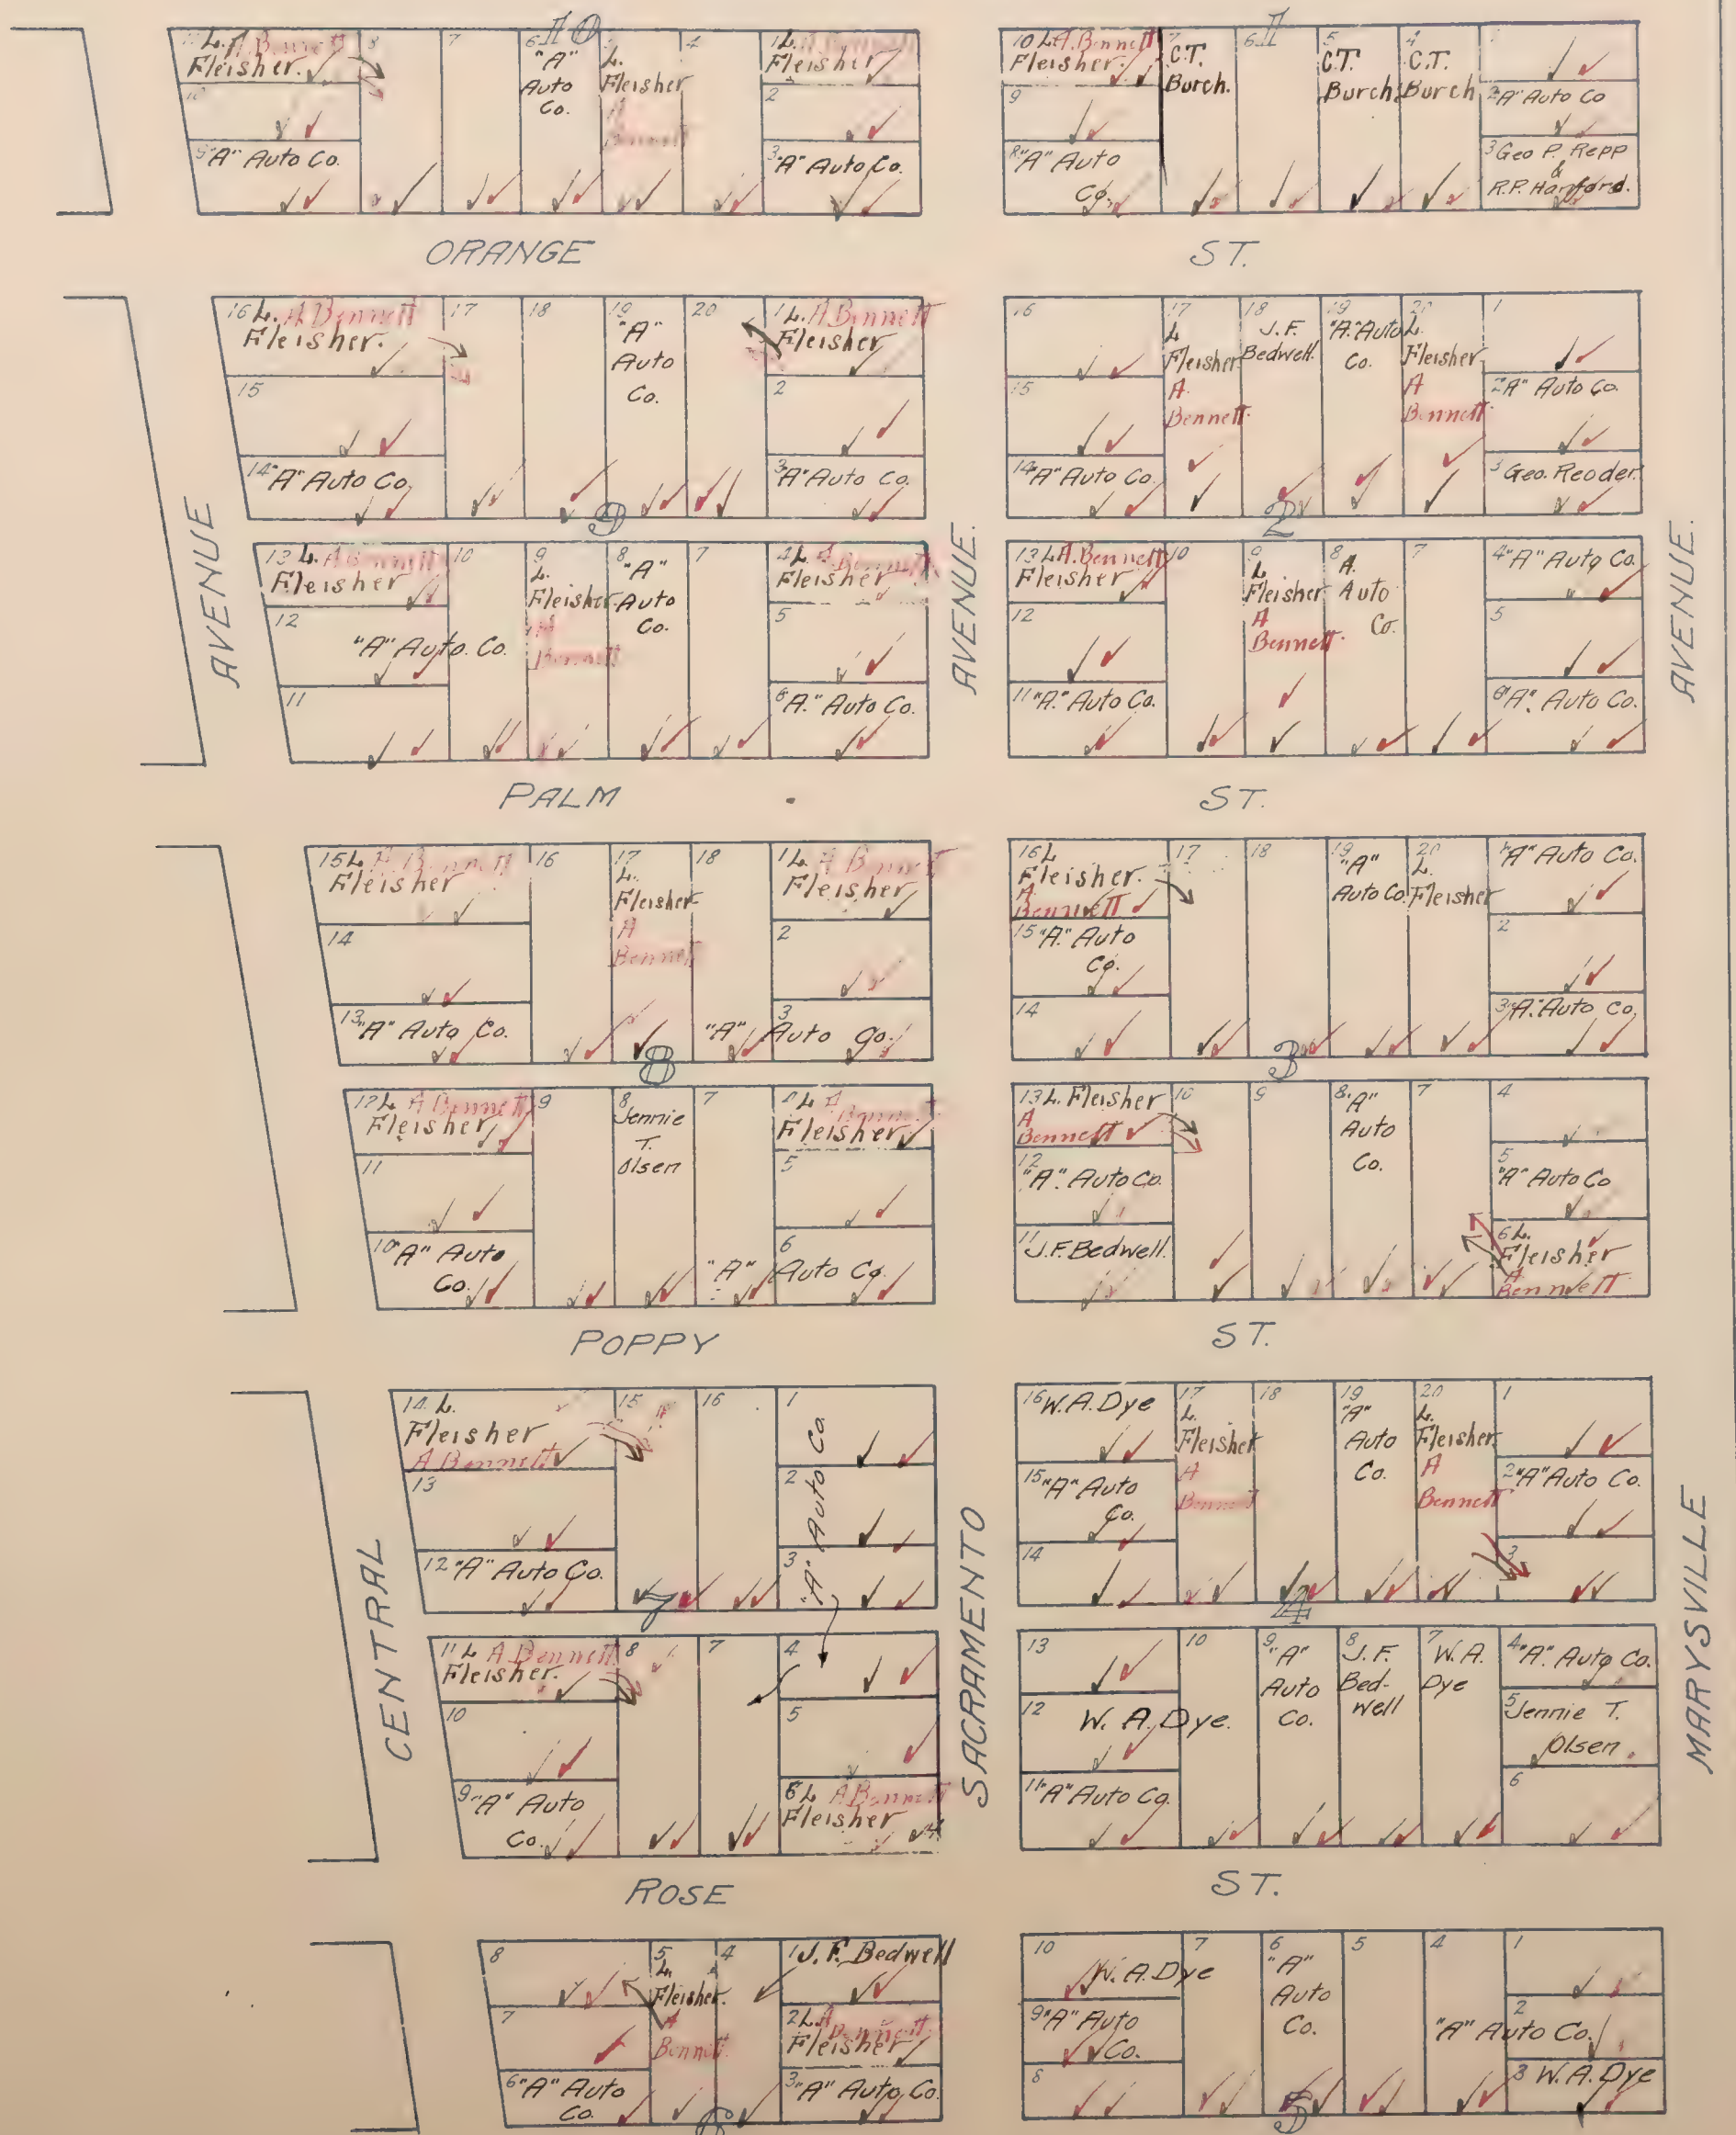


Black Ink-1919 Ownership
Red Ink-1920 Ownership

Blanks to "A" Auto Co. of Calif.

ARDMORE HEIGHTS

LOCATED IN
S.E. 1/4 of Section 12 T.10N.R.4E.
Scale: 50 feet=1 inch.

Lincoln S.D.

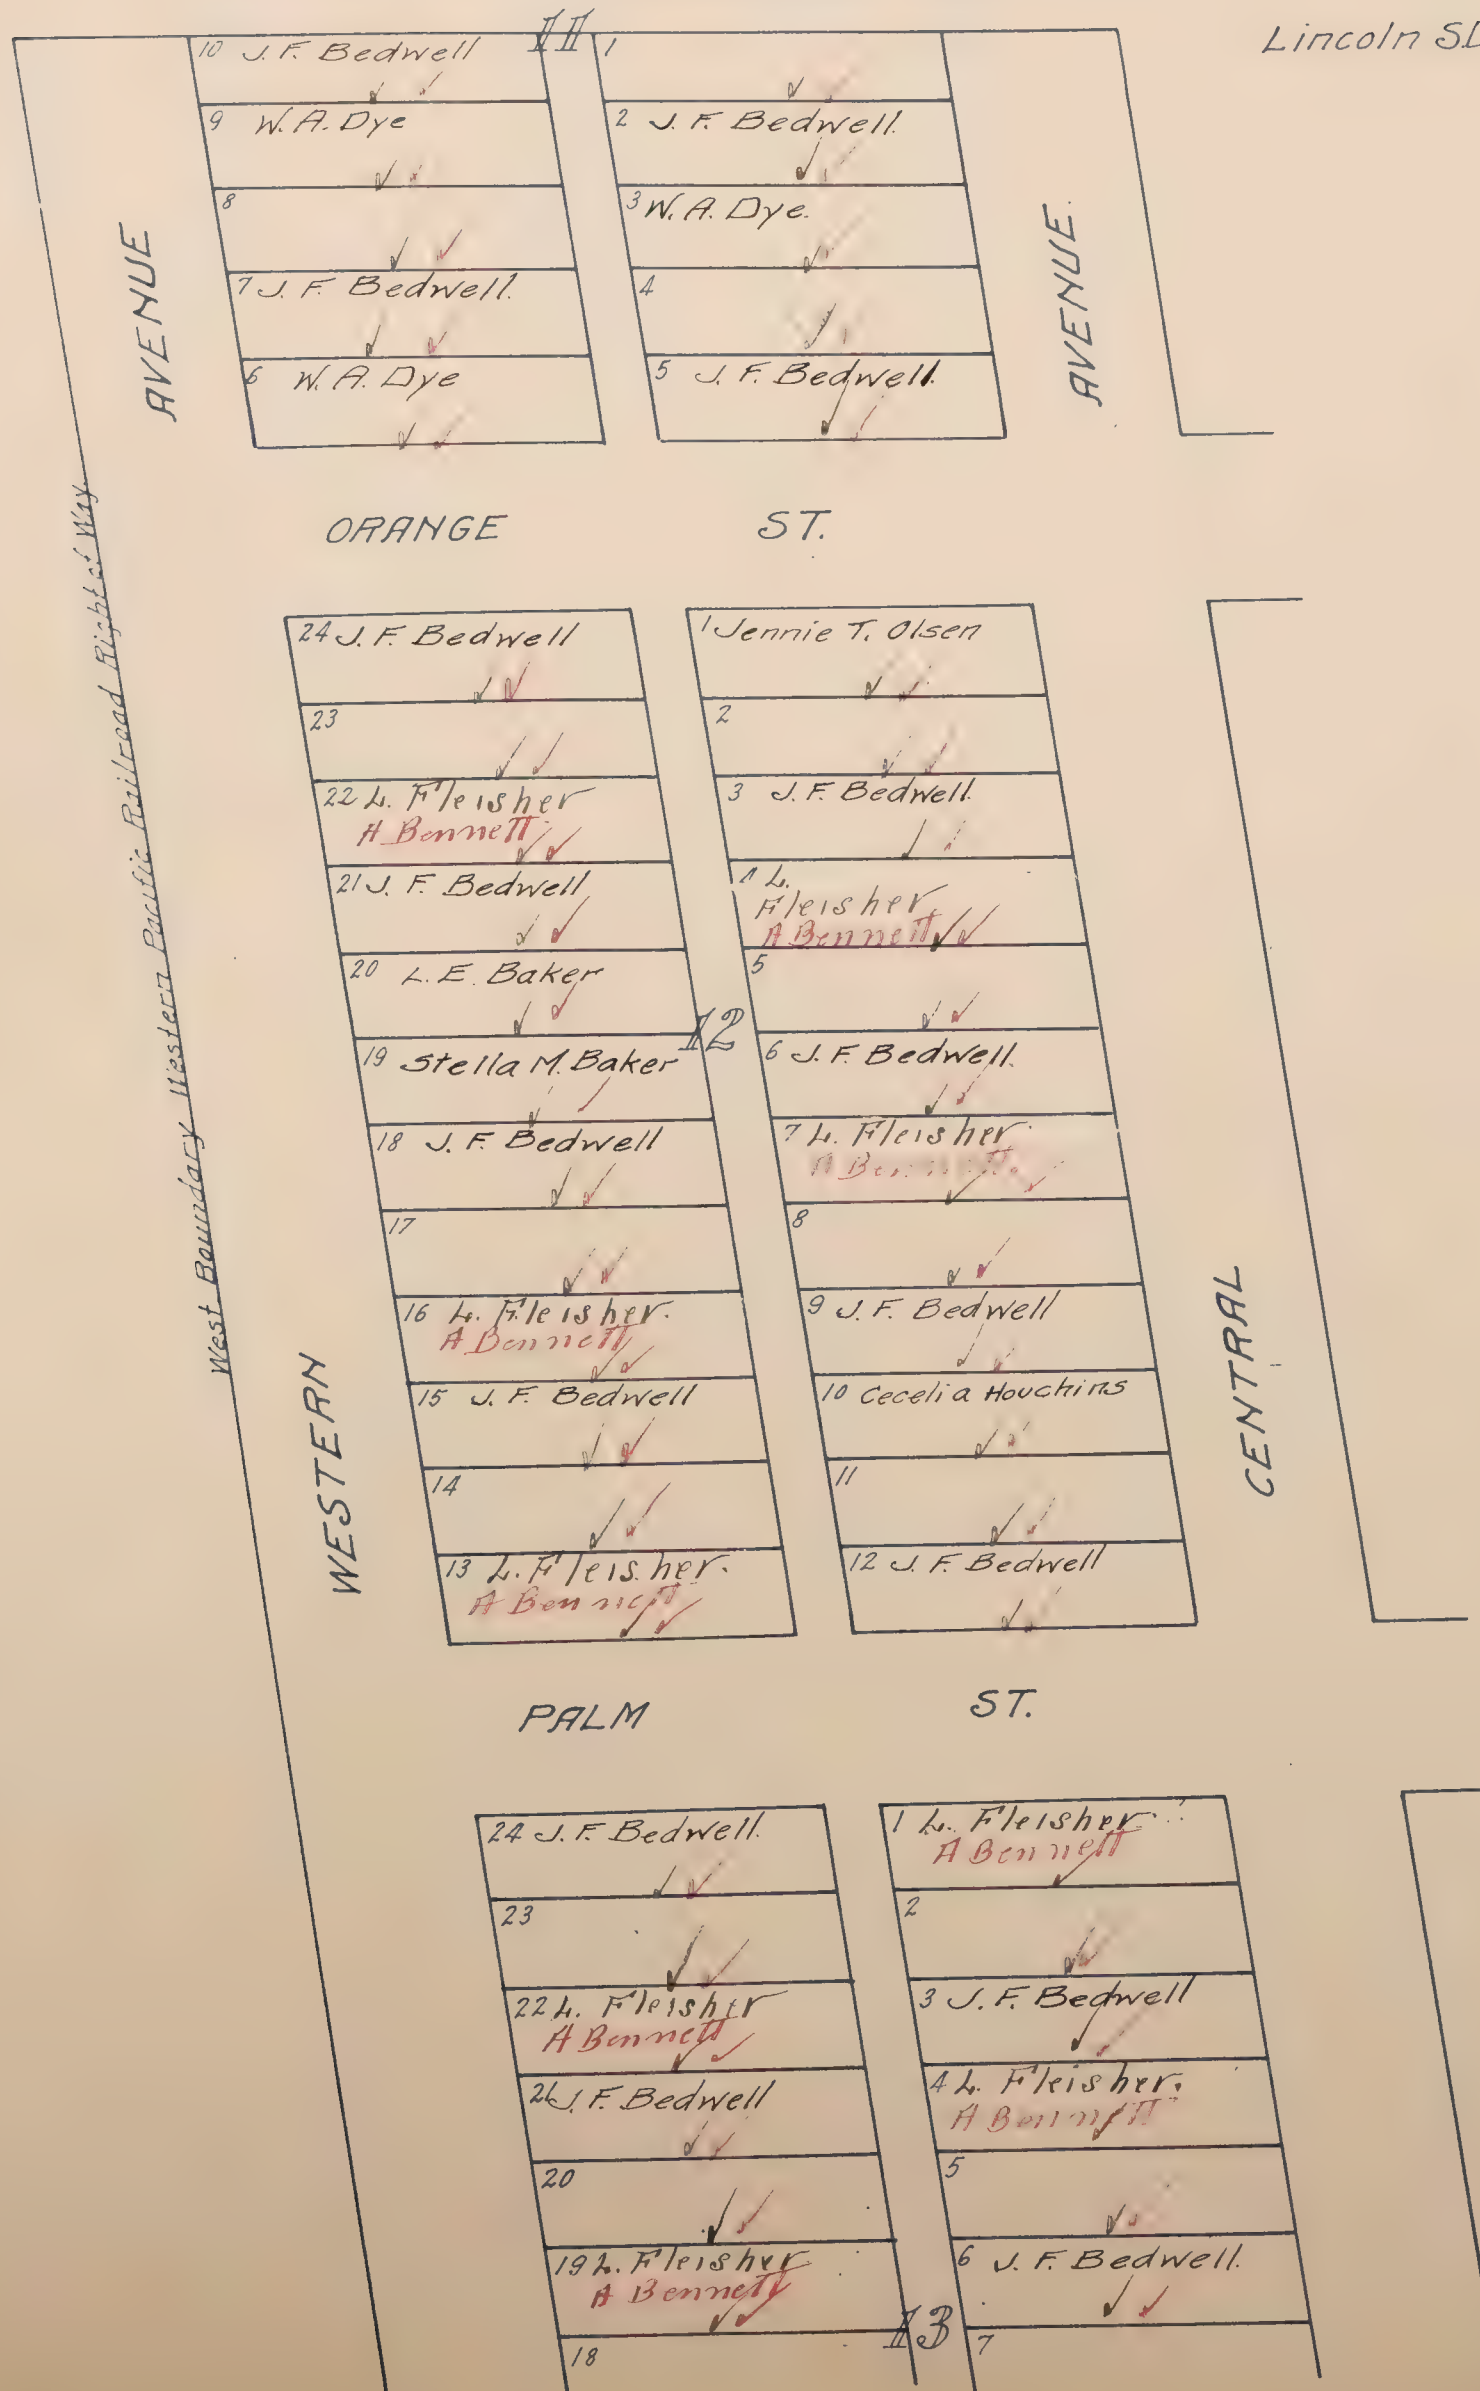

Mapped.


Black Ink-1919 Ownership
Red Ink-1920 Ownership

Blanks to "A" Auto Co of Calif. ✓

ARDMORE HEIGHTS

SE 1/4 of Section 13 T10N R4E

Scale 50 feet = 1 inch

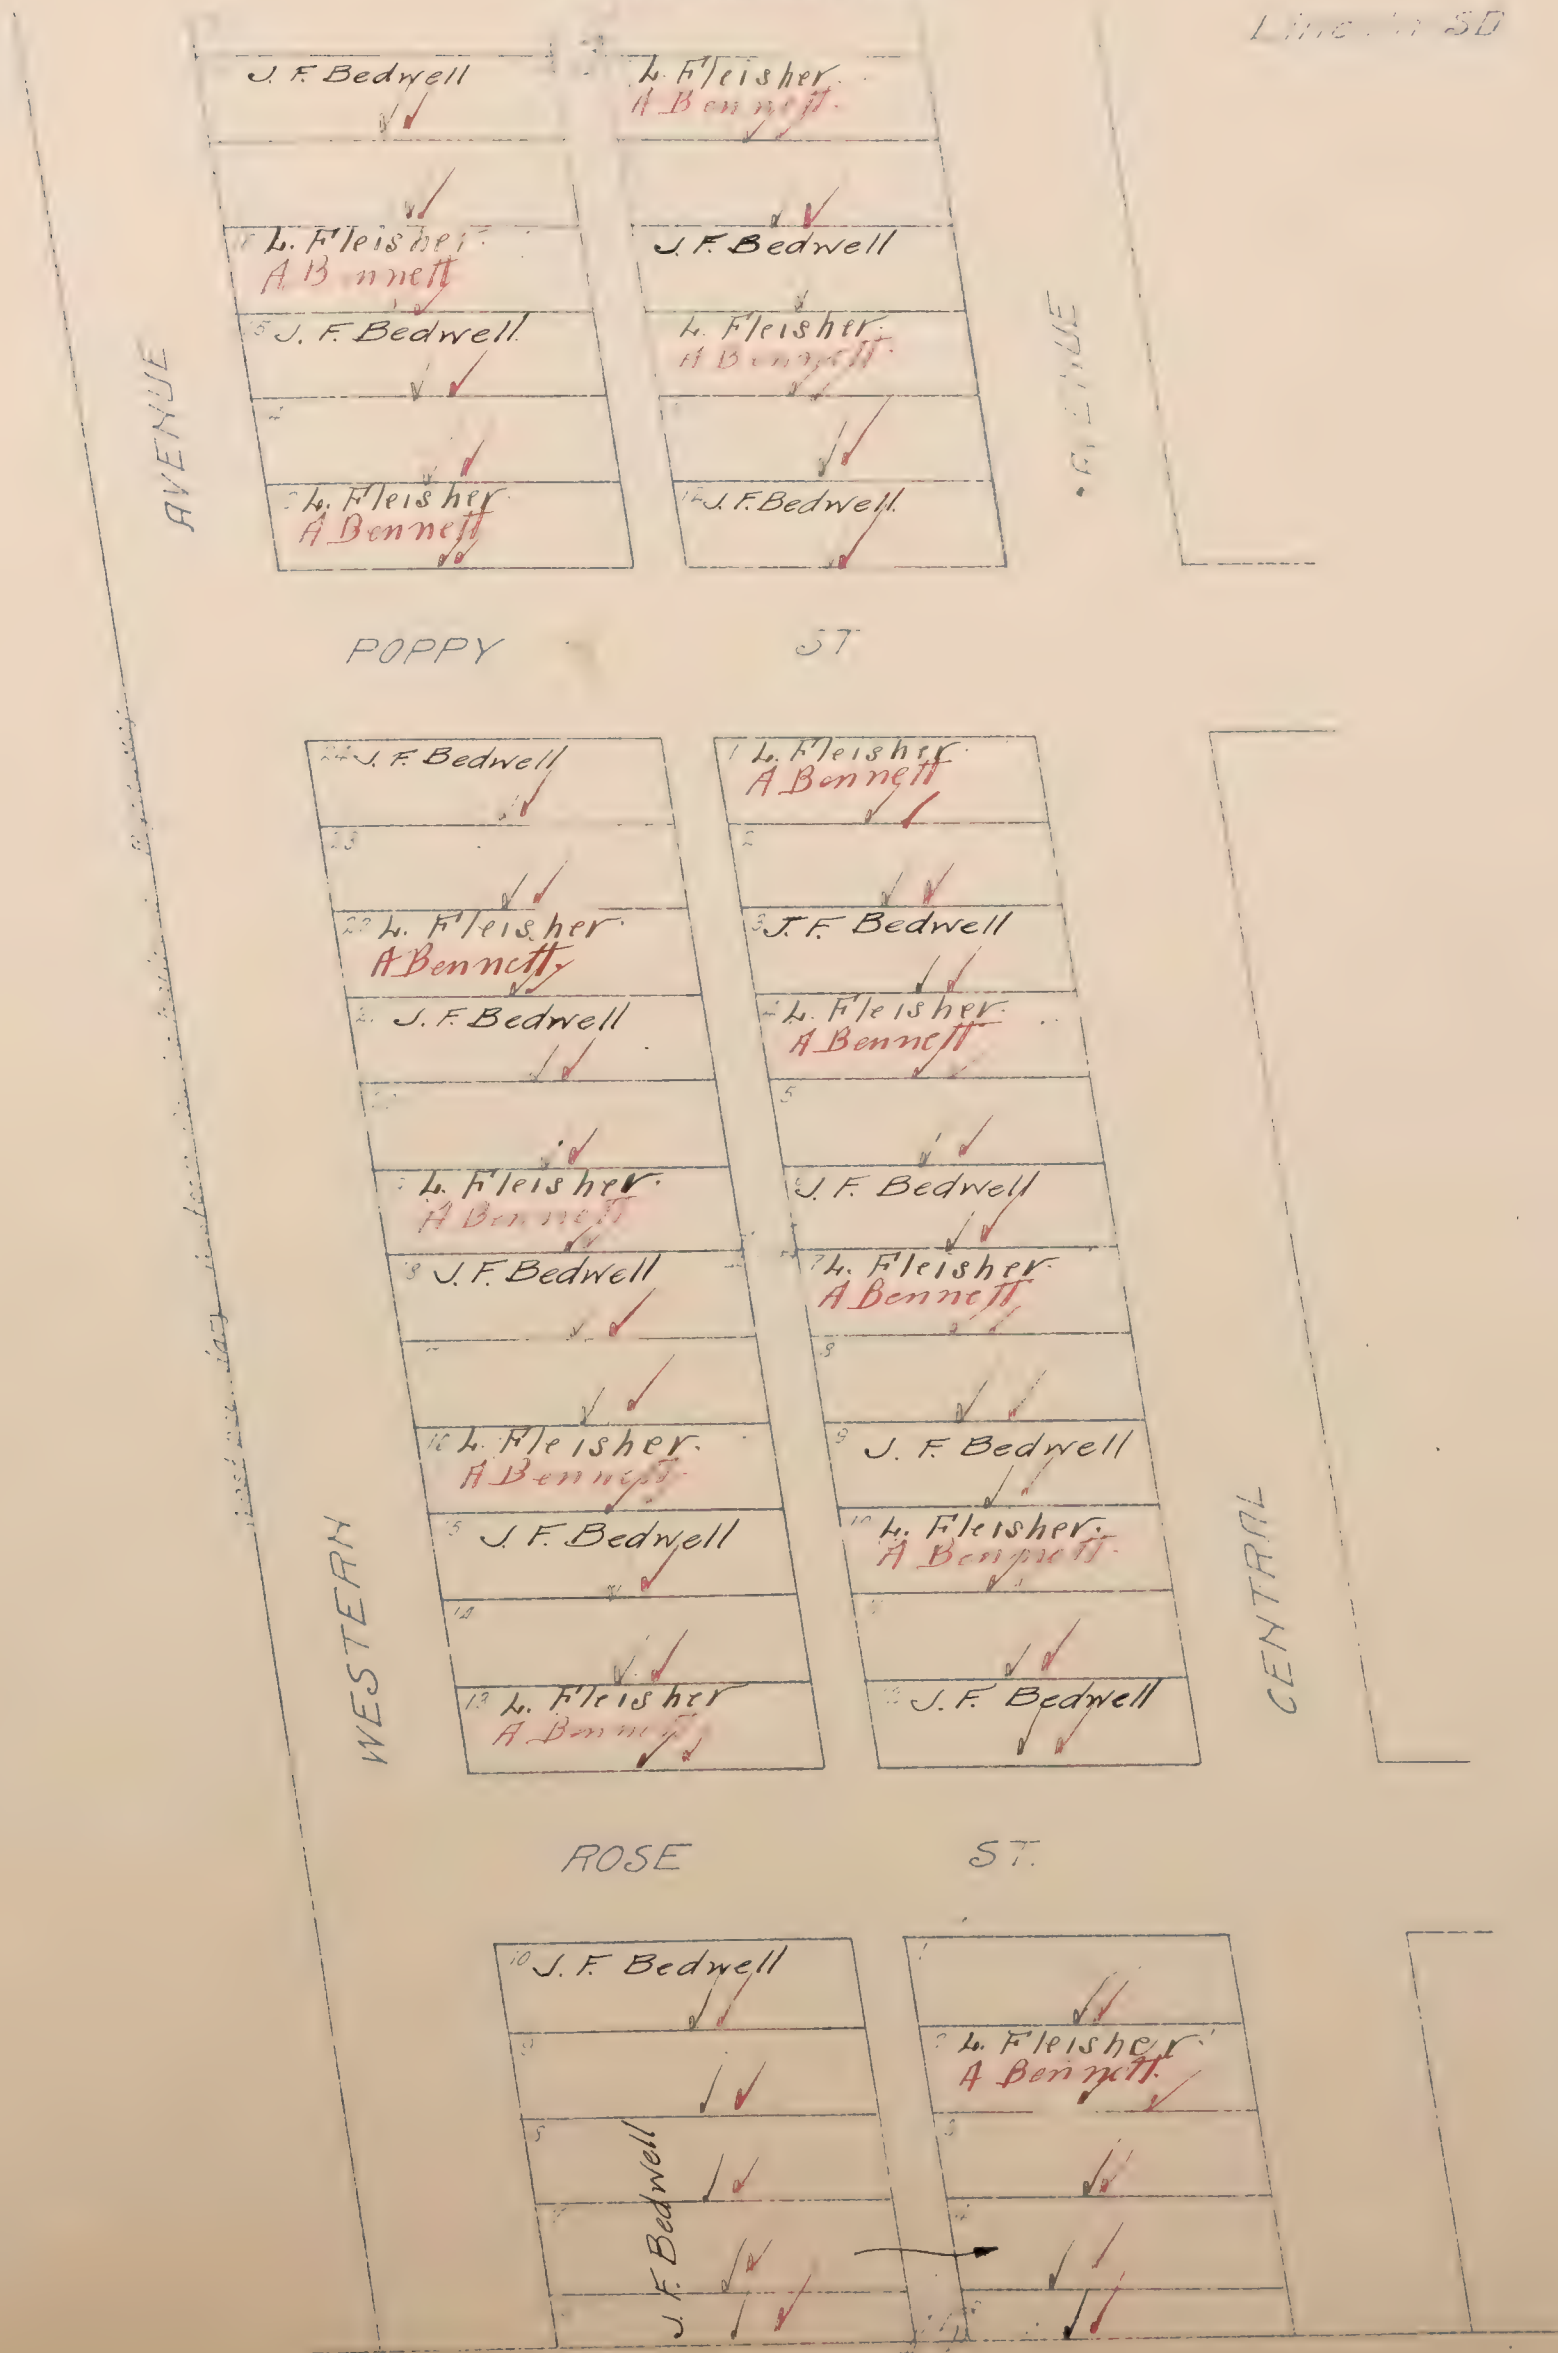


ARTZ & COFFING OLIVE GROVE

LOCATED IN
S.E. $\frac{1}{4}$ of Sec 10. T. 7N. R. 6E
Sacramento County California
Scale 1-300.

Black Ink-1919 Ownership
Red Ink-1920 Ownership


Blanks to Geo. W. Artz & C. C. Coffing. ✓✓

Pl. Grove S.D

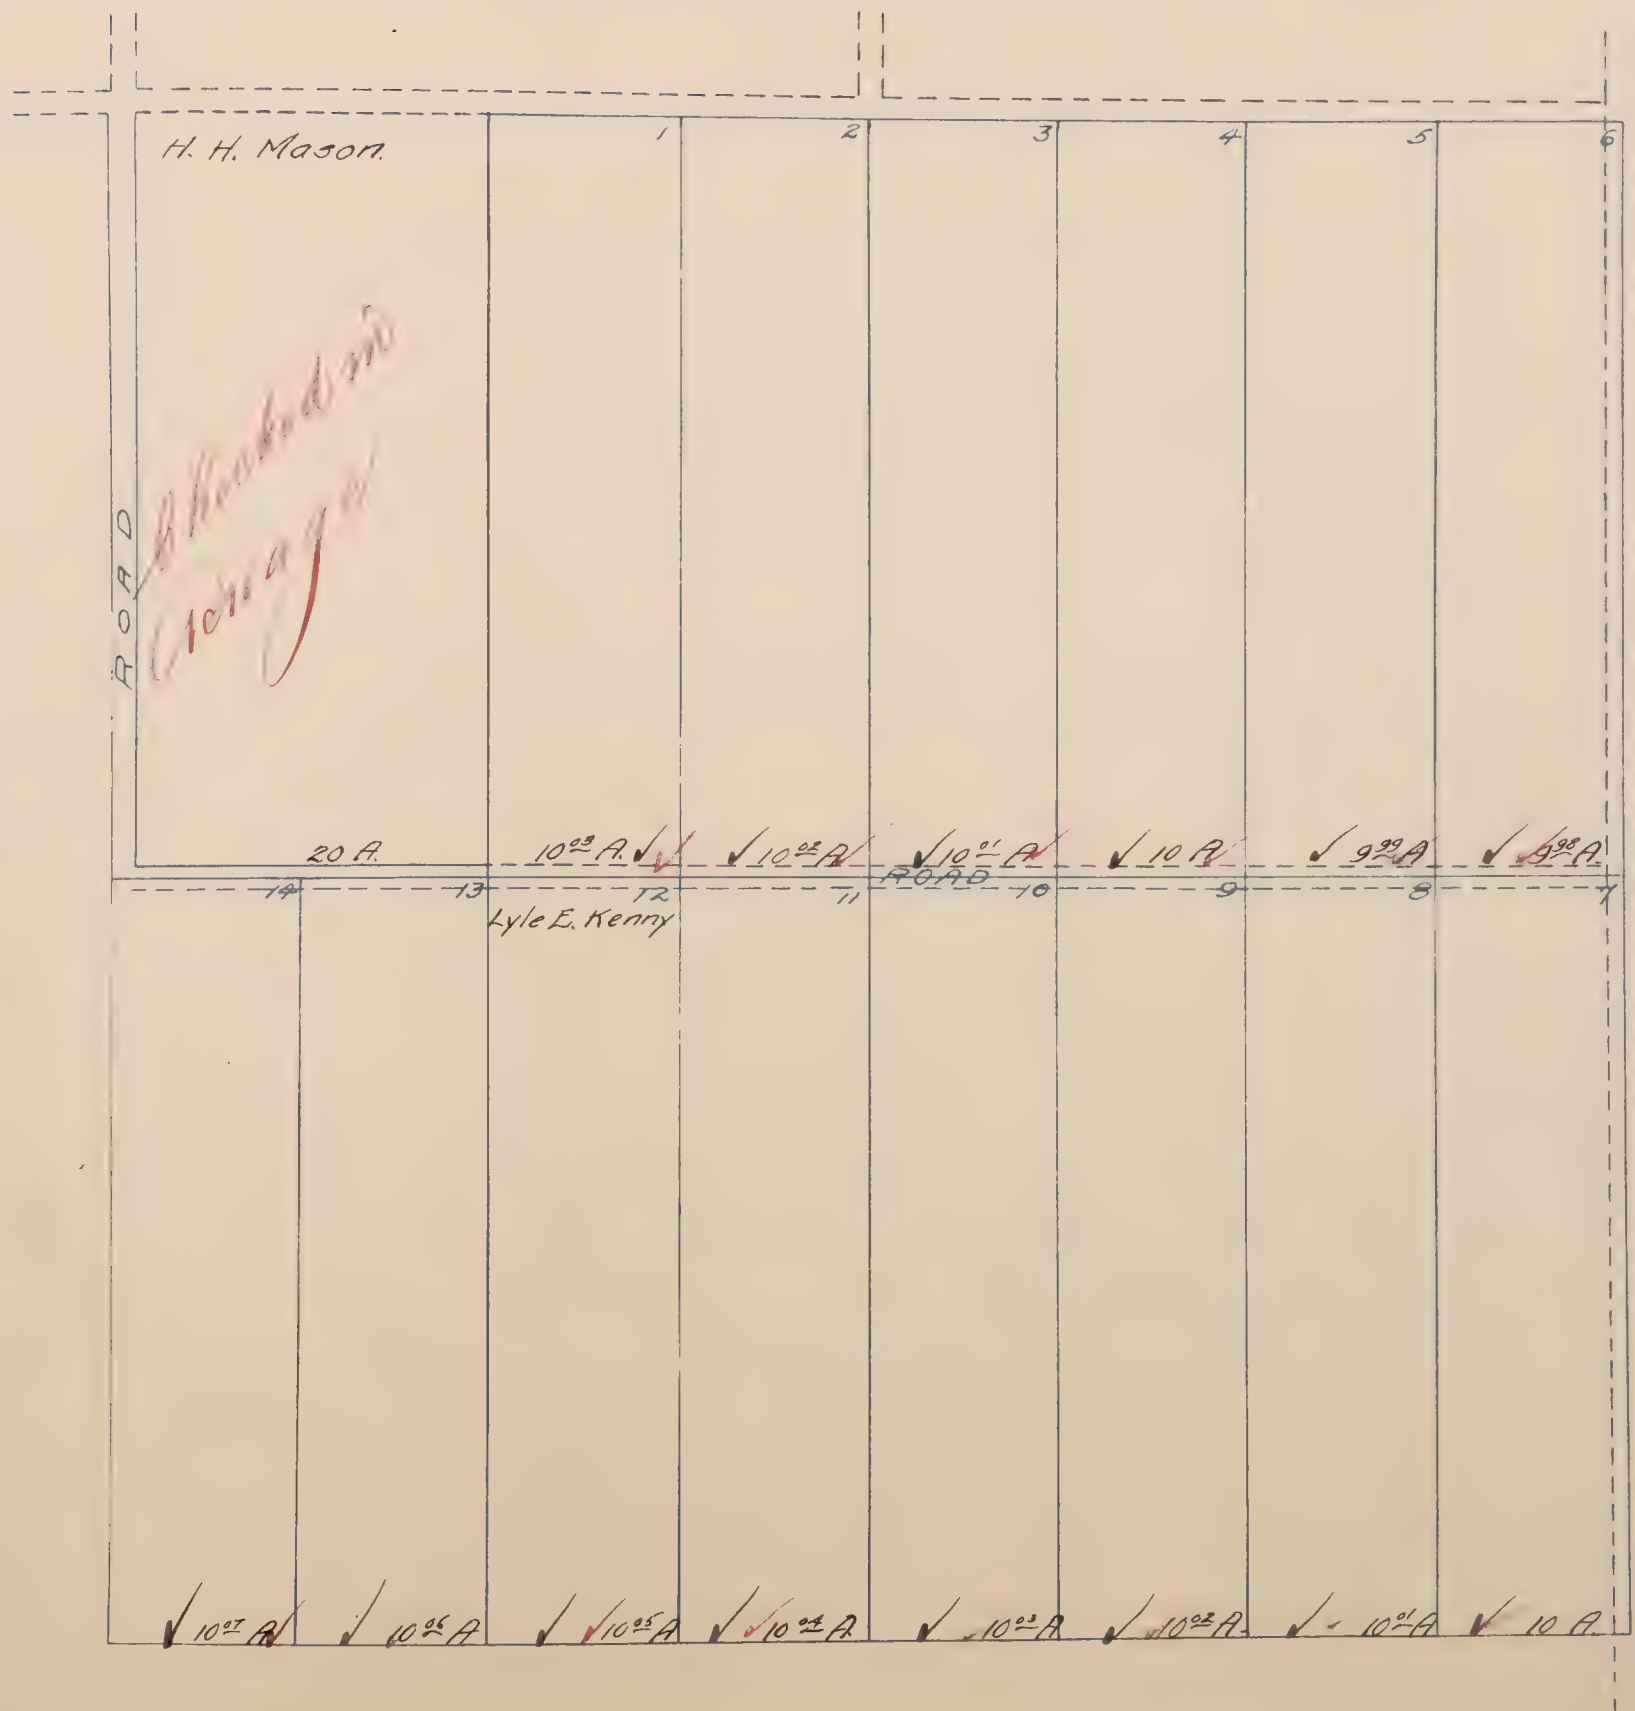

Black Ink-1919 Ownership
Red Ink-1920 Ownership

BEING
N. 1/2 of the N.W. 1/4 of Sec. 29 & the N. 1/2 of the N.E. 1/4 of Sec. 30, T. 8 N., R. 6 E.
Scale: 1" = 450'

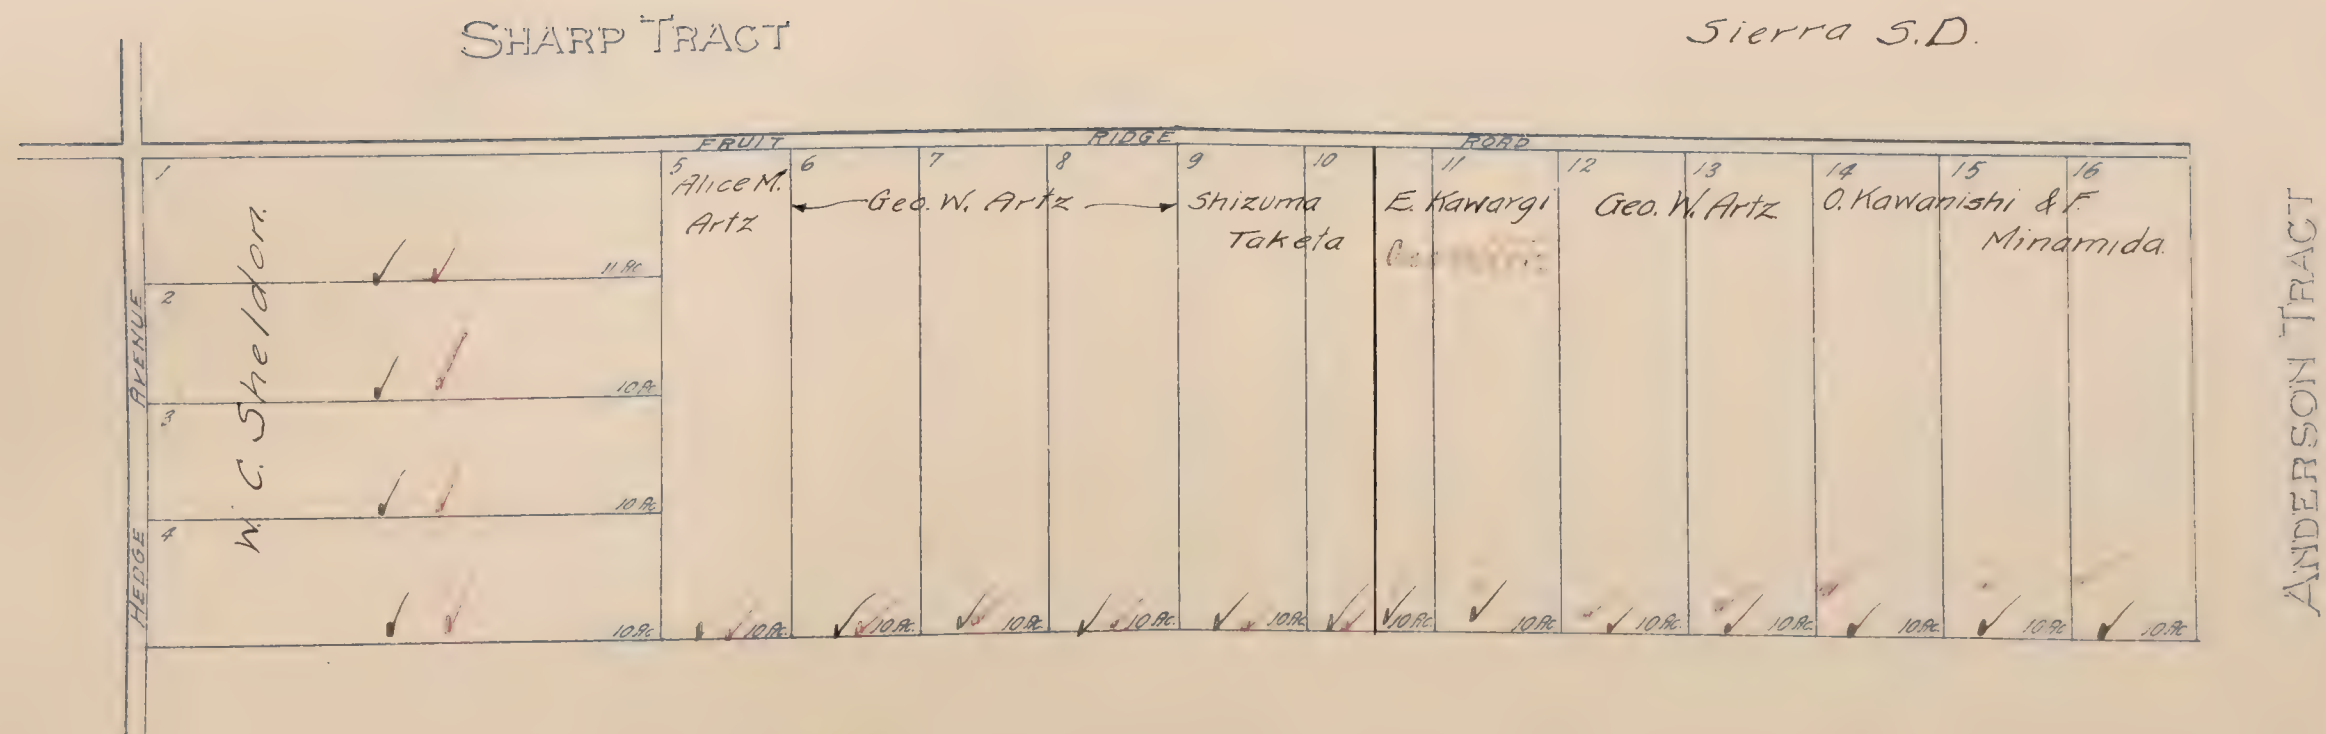


Map

GEORGE WARTZ SUBD NO 2

W.M. SERRIN TOLRSE
Sagittarius

Black Ink-1919 Ownership
Red Ink-1920 Ownership

Sierra S.D.

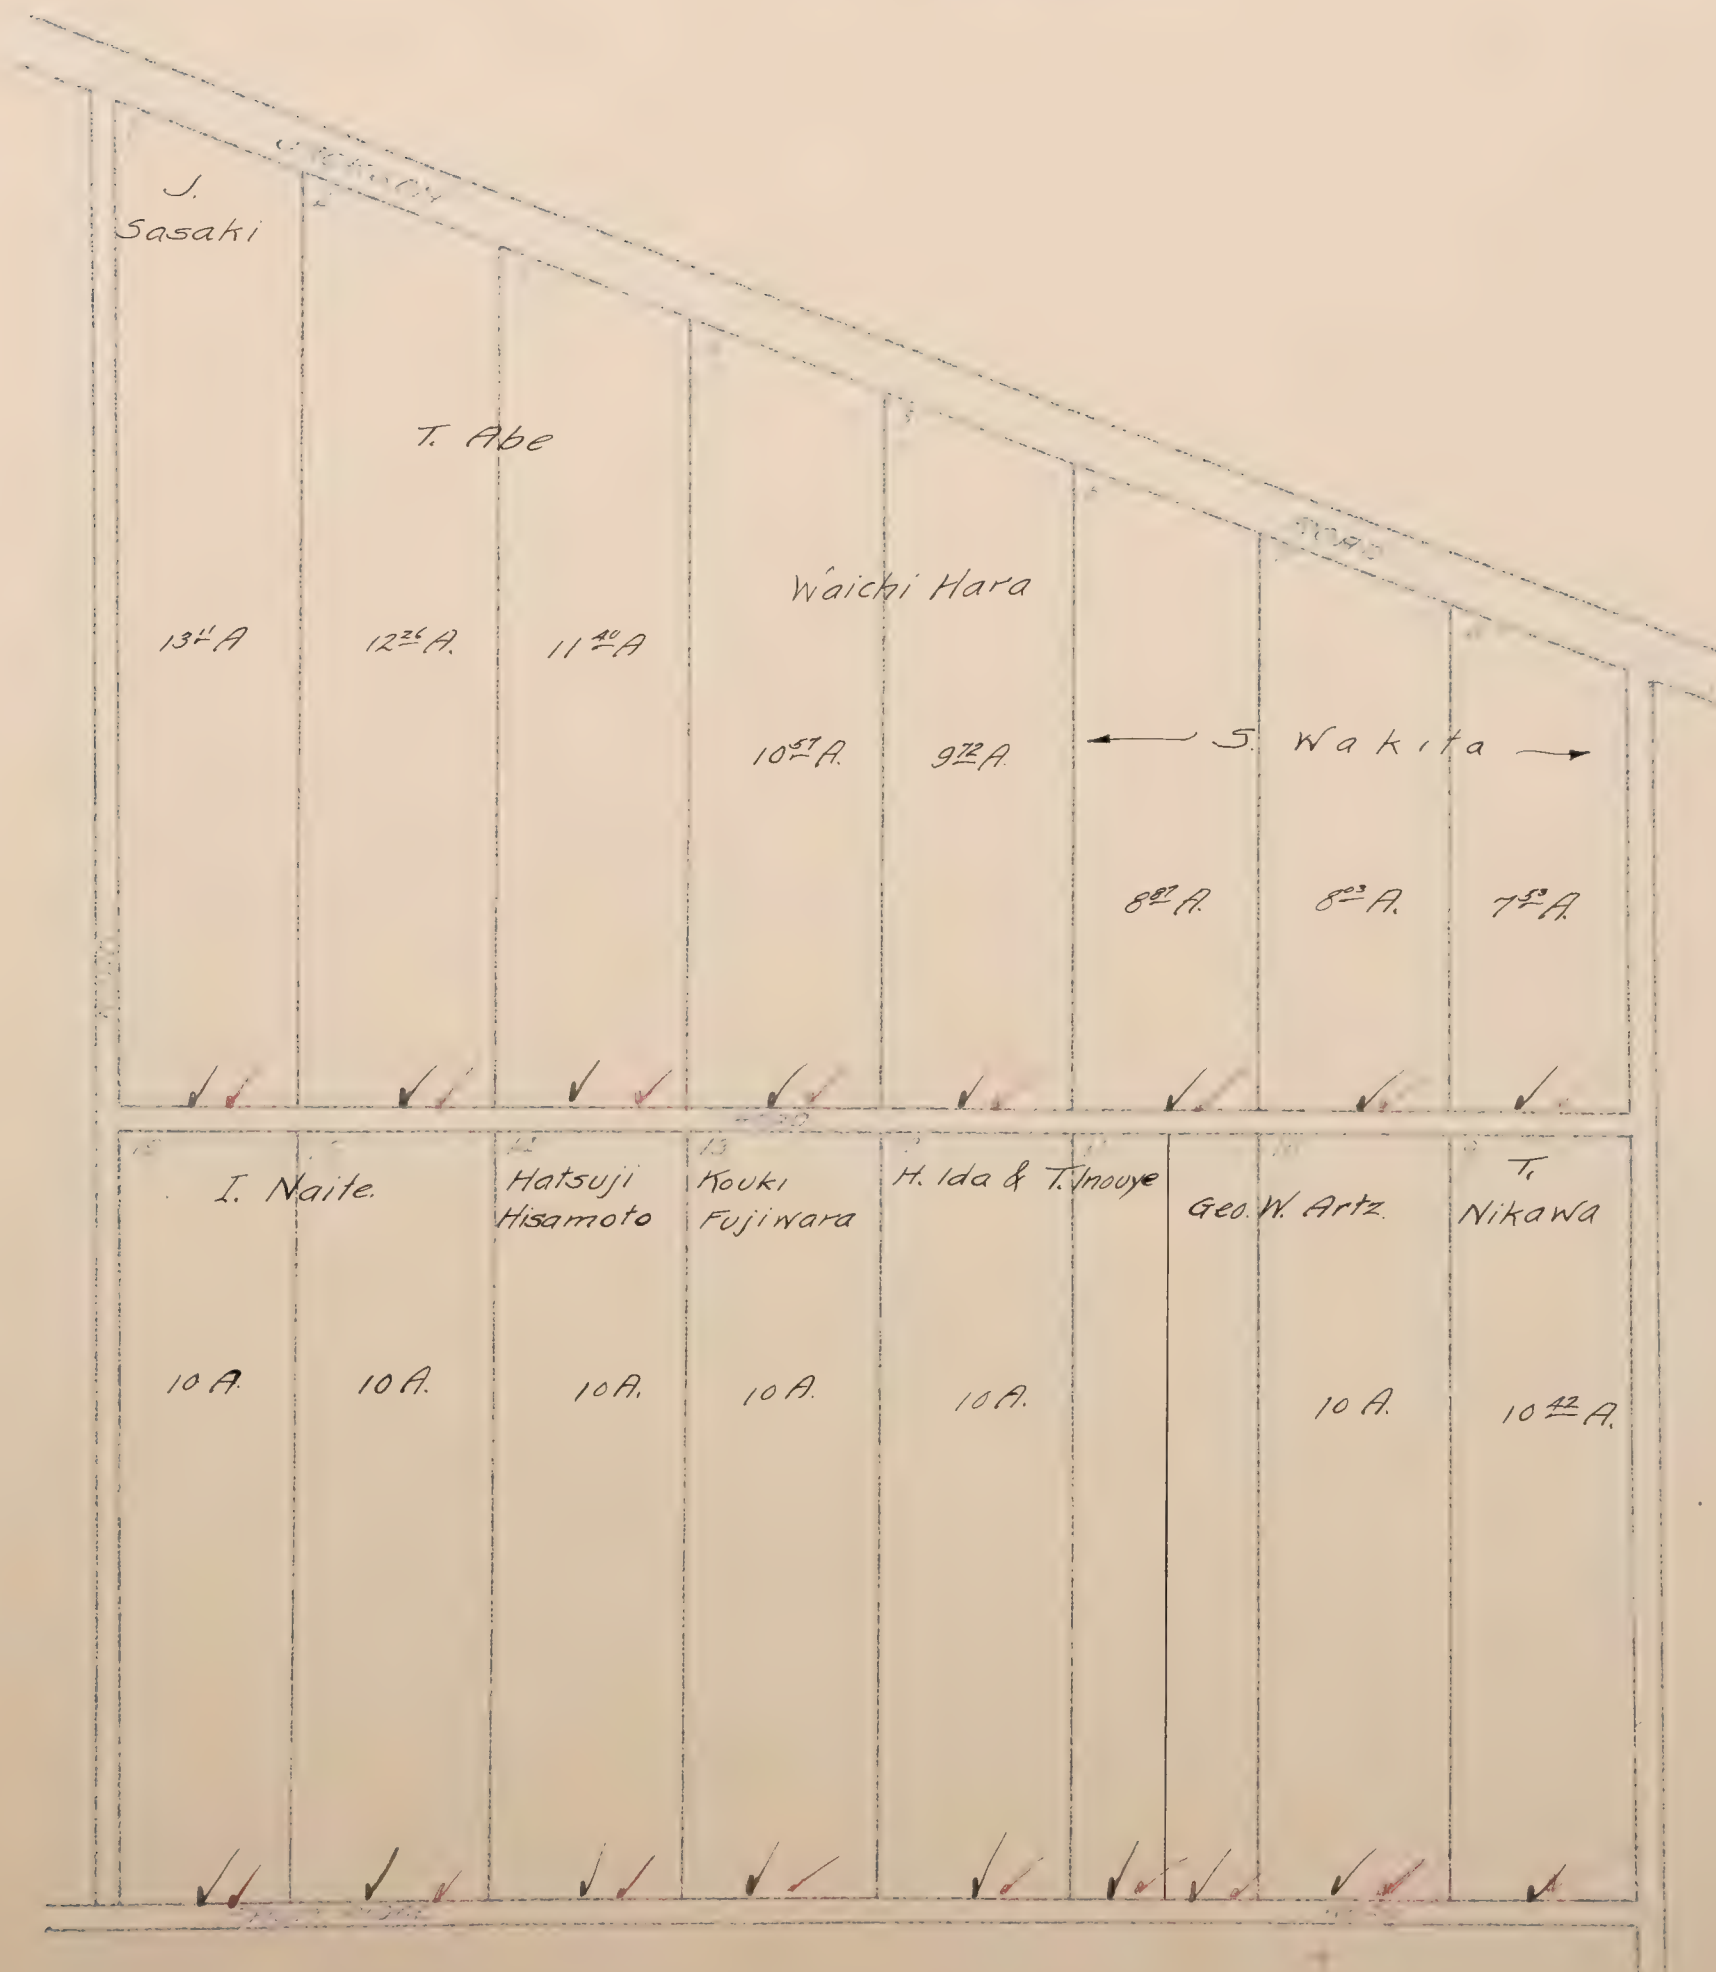


Mapped.

Black Ink-1919 Ownership
Red Ink-1920 Ownership

BATES AND ISHAM
ADDITION TO COURTLAND

Blanks to F.B. Bates. ↓
Onisto. S. II

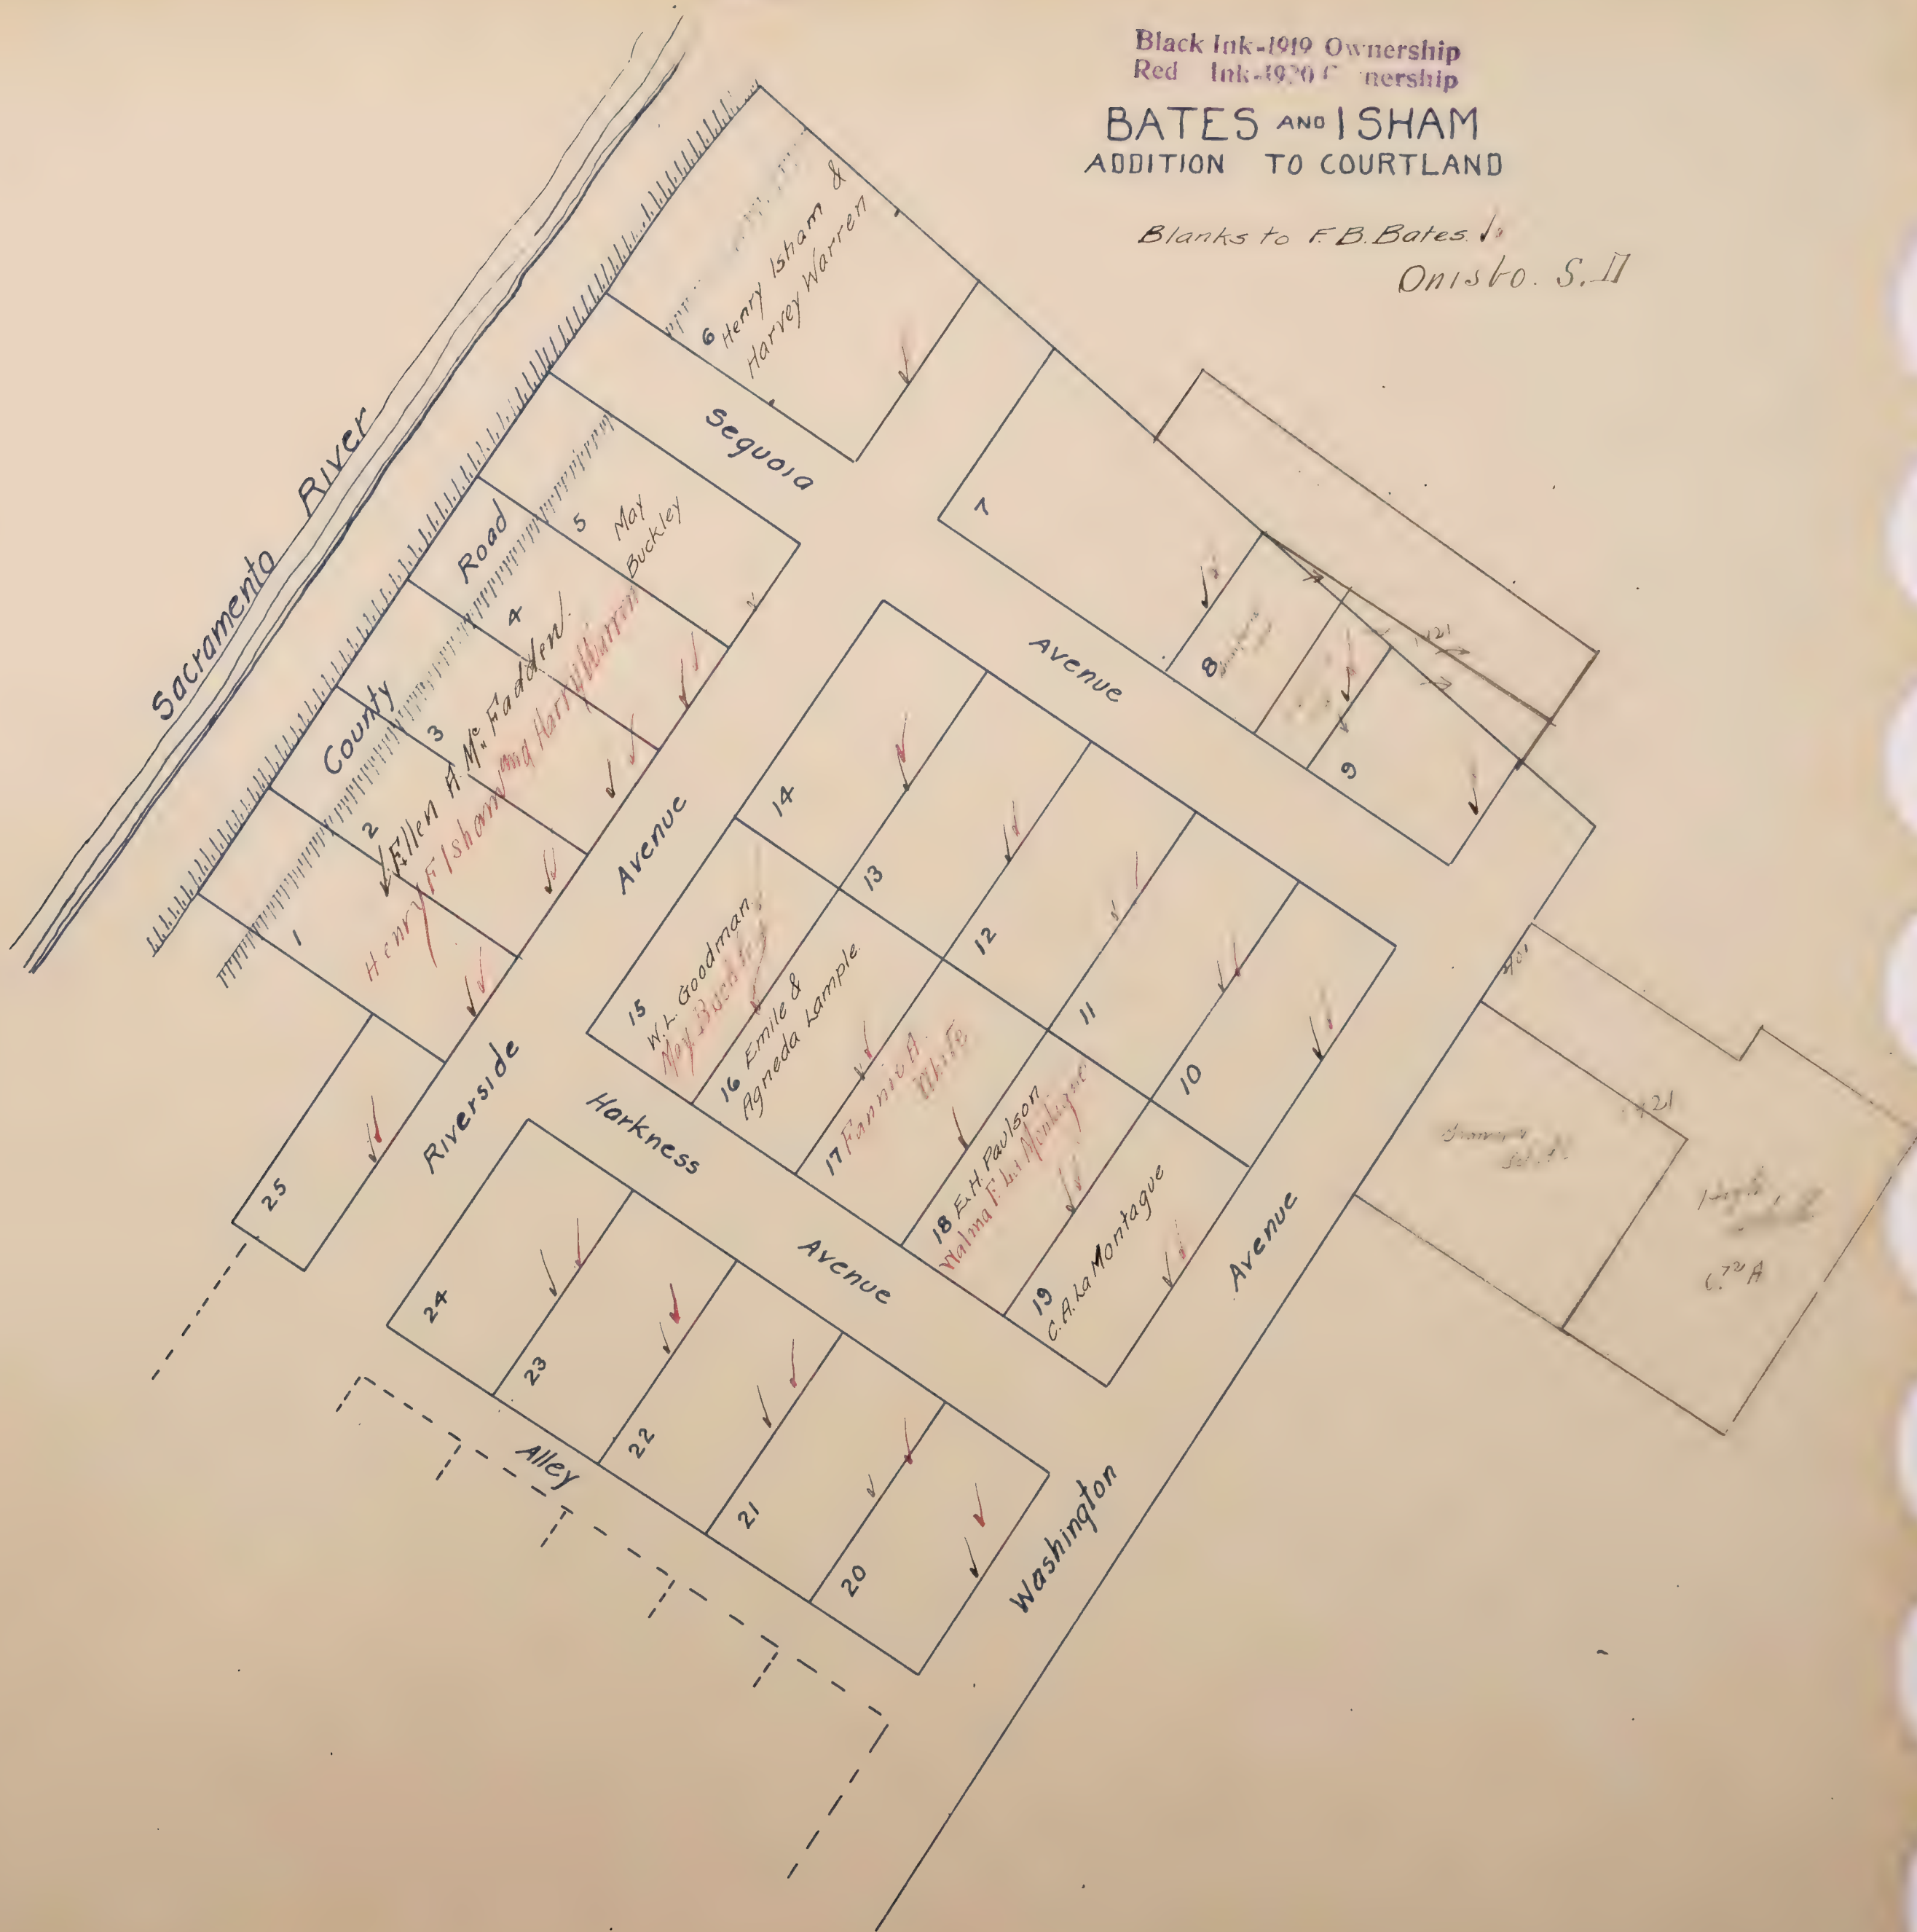

Mapped.

BELL & LE ROY SUBD'N

OF

LOT'S 1 & 2 ~ BLOCK 55

NORTH SACRAMENTO SUBD'N NO 1

Scale 1" = 50 Feet

Blanks to T.W. Bell & Chas Le Roy ✓

N. Sacto. S.D.

Black Ink-1919 Ownership
Red Ink-1920 Ownership

10TH STREET


15. Luke Howe. ✓✓	4	5	6	7	8	9	✓✓ 10 ✓✓ 11 ✓✓	12 Lucy Souza ✓
2 F. A. Sandahl. ✓✓	✓✓	✓✓	✓✓	✓✓	✓✓	✓✓	✓✓	13. C. W. Kiff. ✓✓
3 ✓✓								14 ✓✓
28 ✓✓	25 John Rasmussen ✓✓	24 ✓✓ ✓✓ V.J. and E. I. ✓✓	23 ✓✓ ✓✓	22 ✓✓	21 ✓✓	20 ✓✓	19 ✓✓	18 O.C. Bunte. ✓✓
27 ✓✓				✓✓	✓✓	✓✓	✓✓	16 ✓✓
26 ✓✓								17 ✓✓

11TH STREET

BLAKE

Scale: 10 chs. = 1 in.
SEC. 9 & 10 T. 6 N. R. 7 E.

Lee S.D.
Co. ony S.D

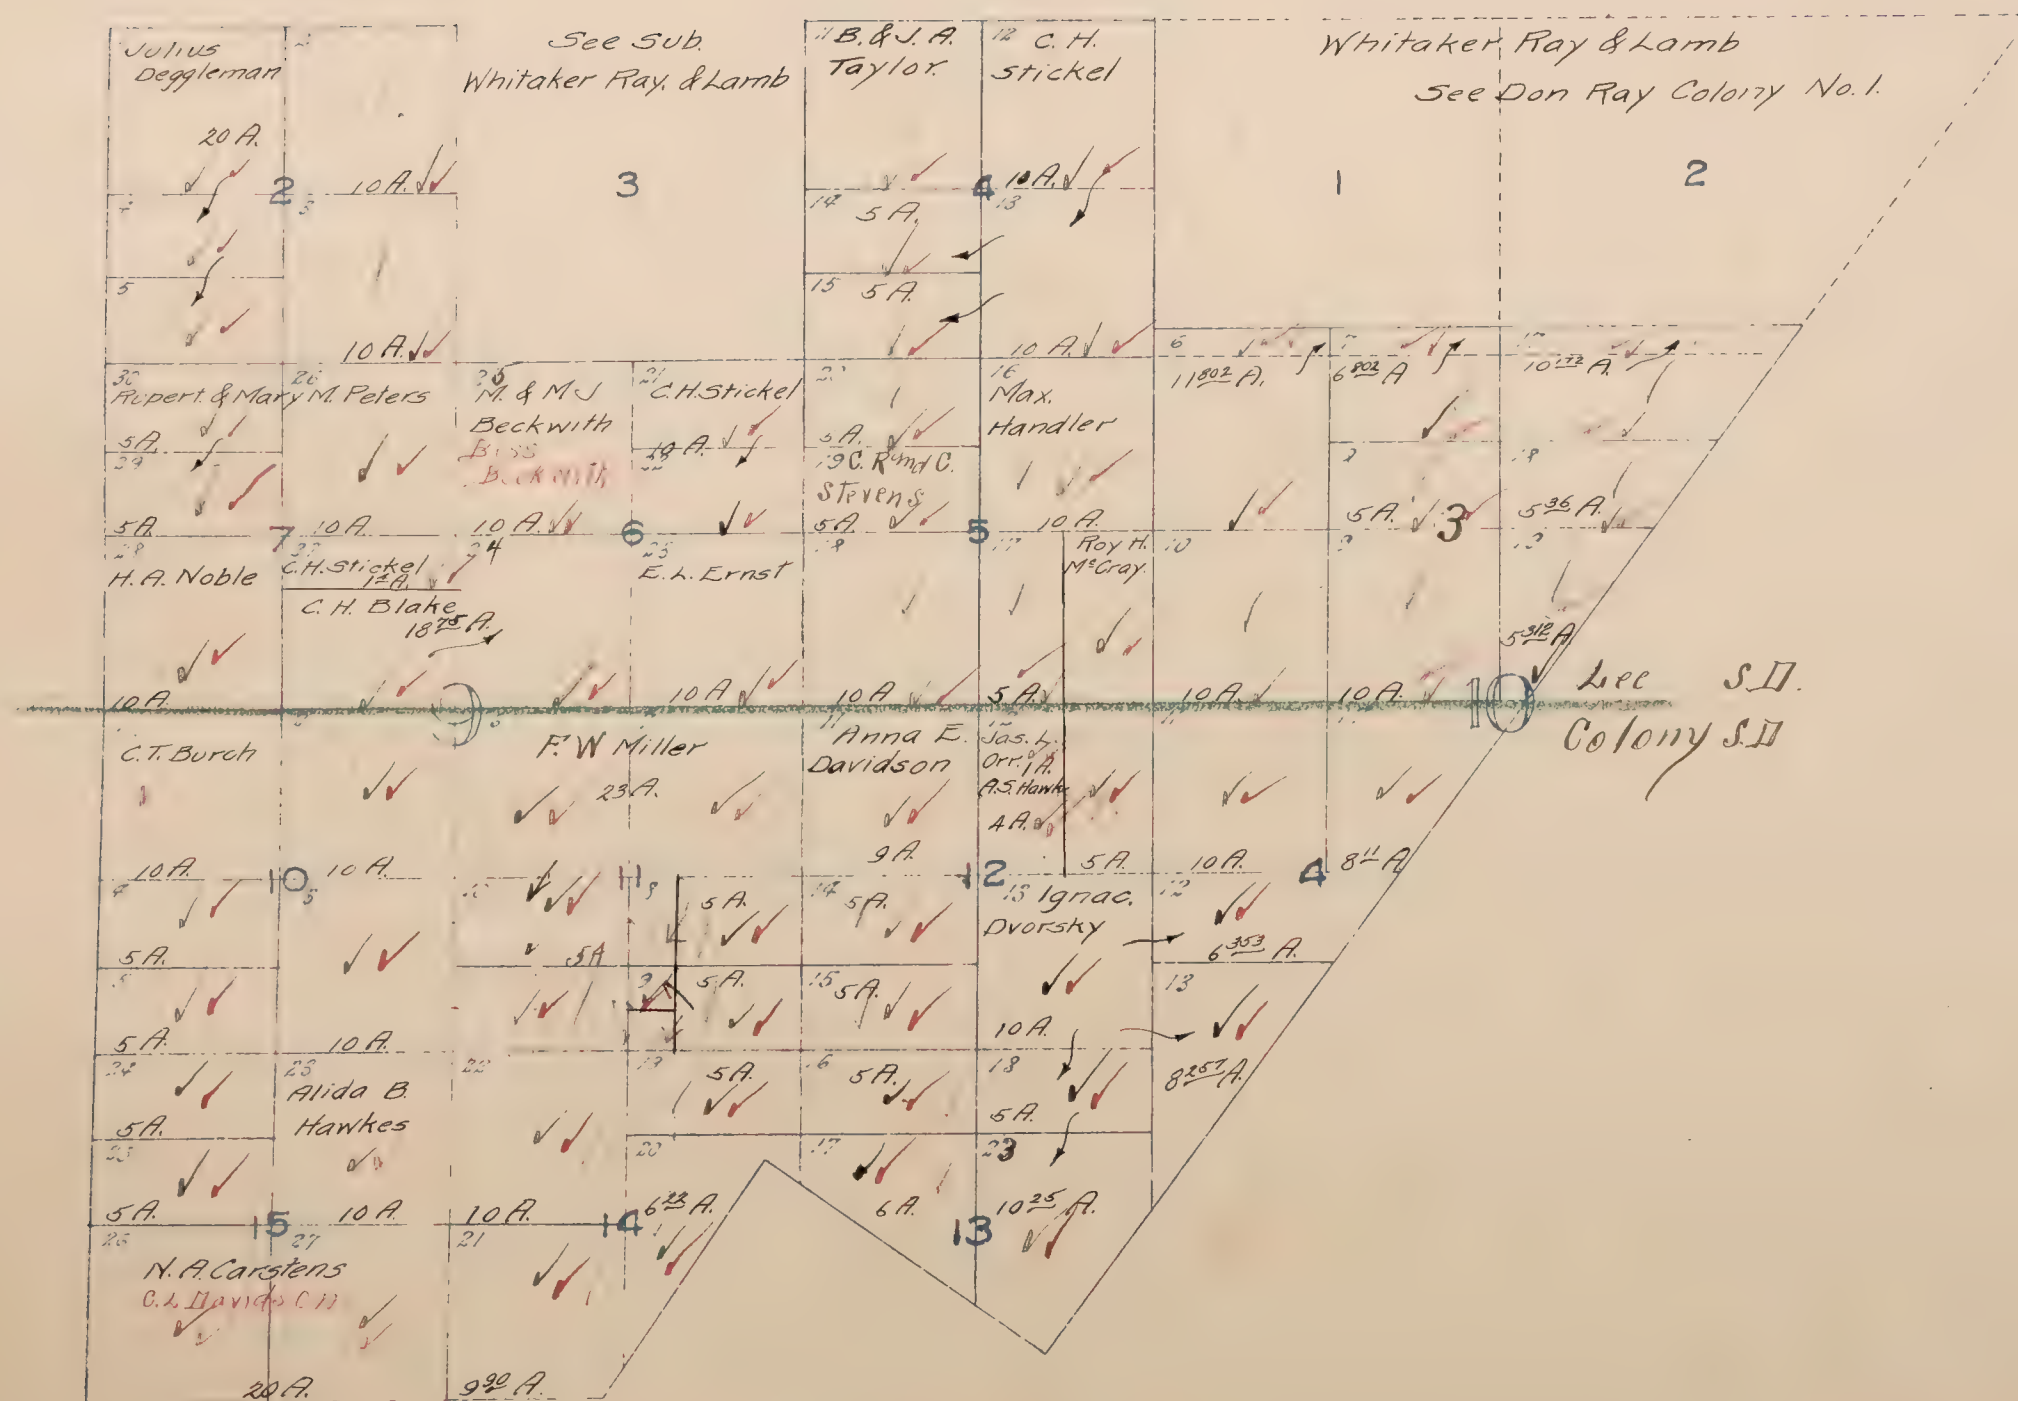

Mapped.


BONNIEMEAD & SEQUOIA PARK.

SUBDIVISION N° 95 & 107.

Scale 4 chains=1 in

Black Ink=1919 Ownership
Red Ink=1920 Ownership

Junction S.D.

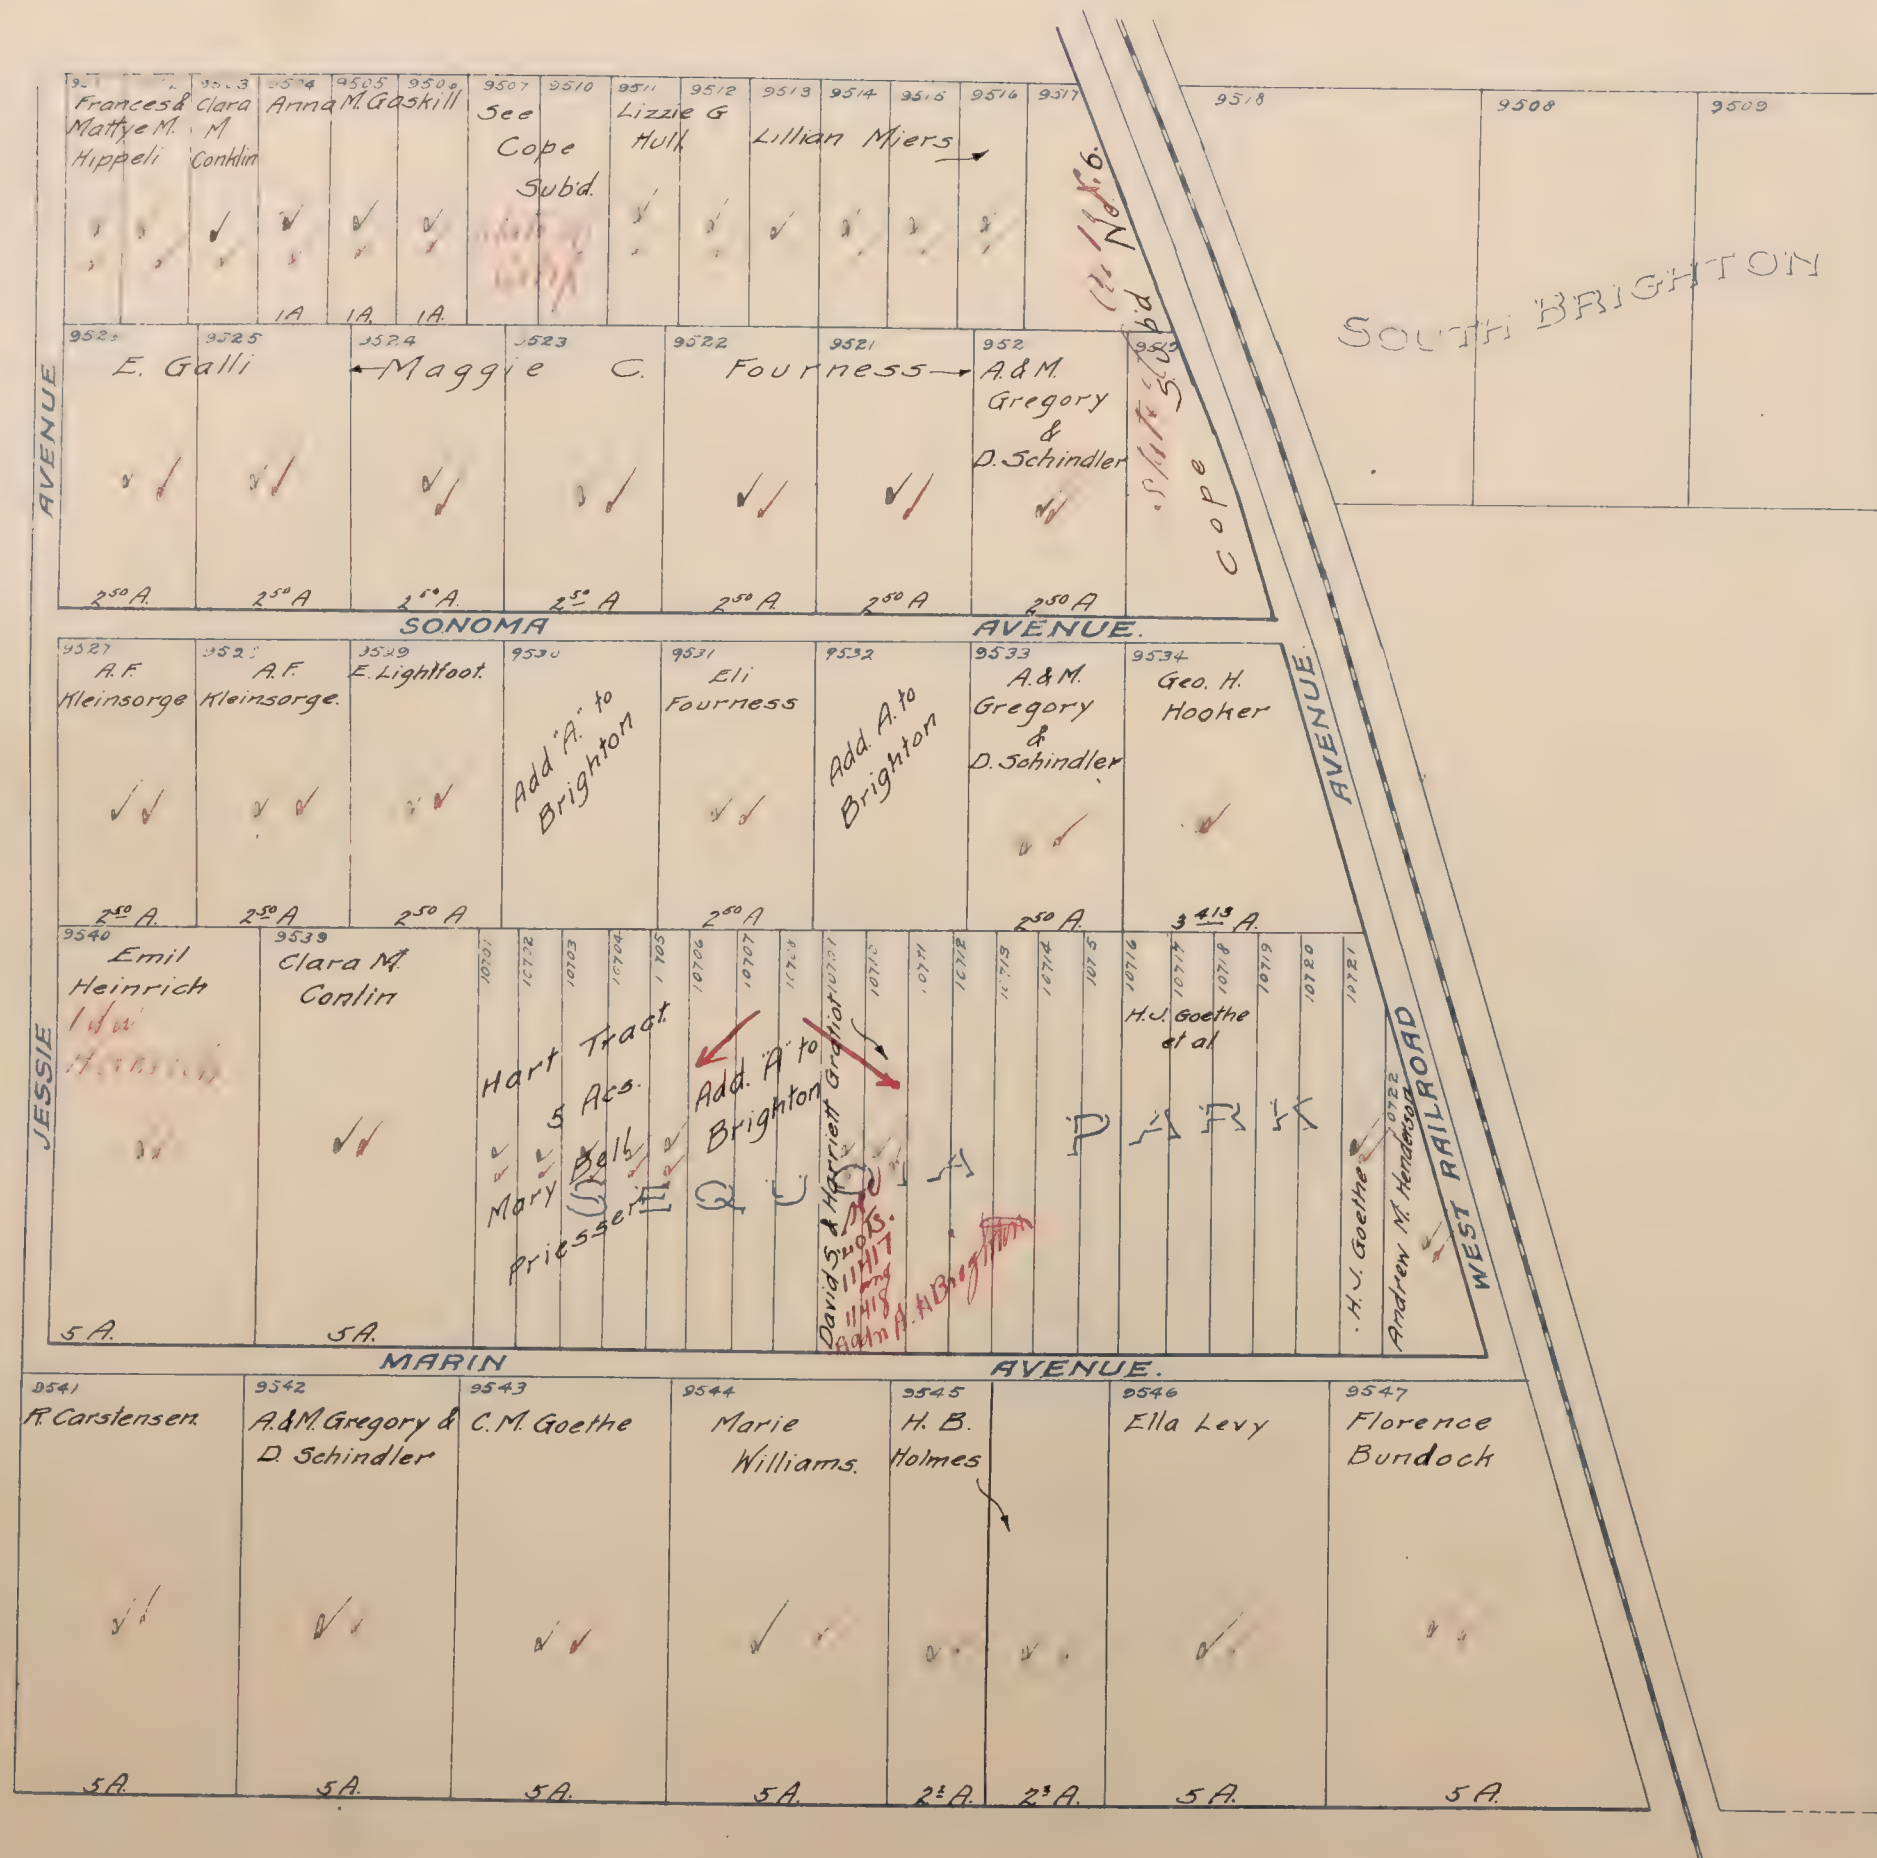


Black Ink-1919 Ownership
Red Ink-1920 Ownership

BOULEVARD ACRES

located in
NW 1/4 of Sec. 28 T 8 N. R 5 E
Scale: 1" = Fruit Ridge S.D.

Blanks to Mercantile Terminal Co.


R.A. PRICE TRACT

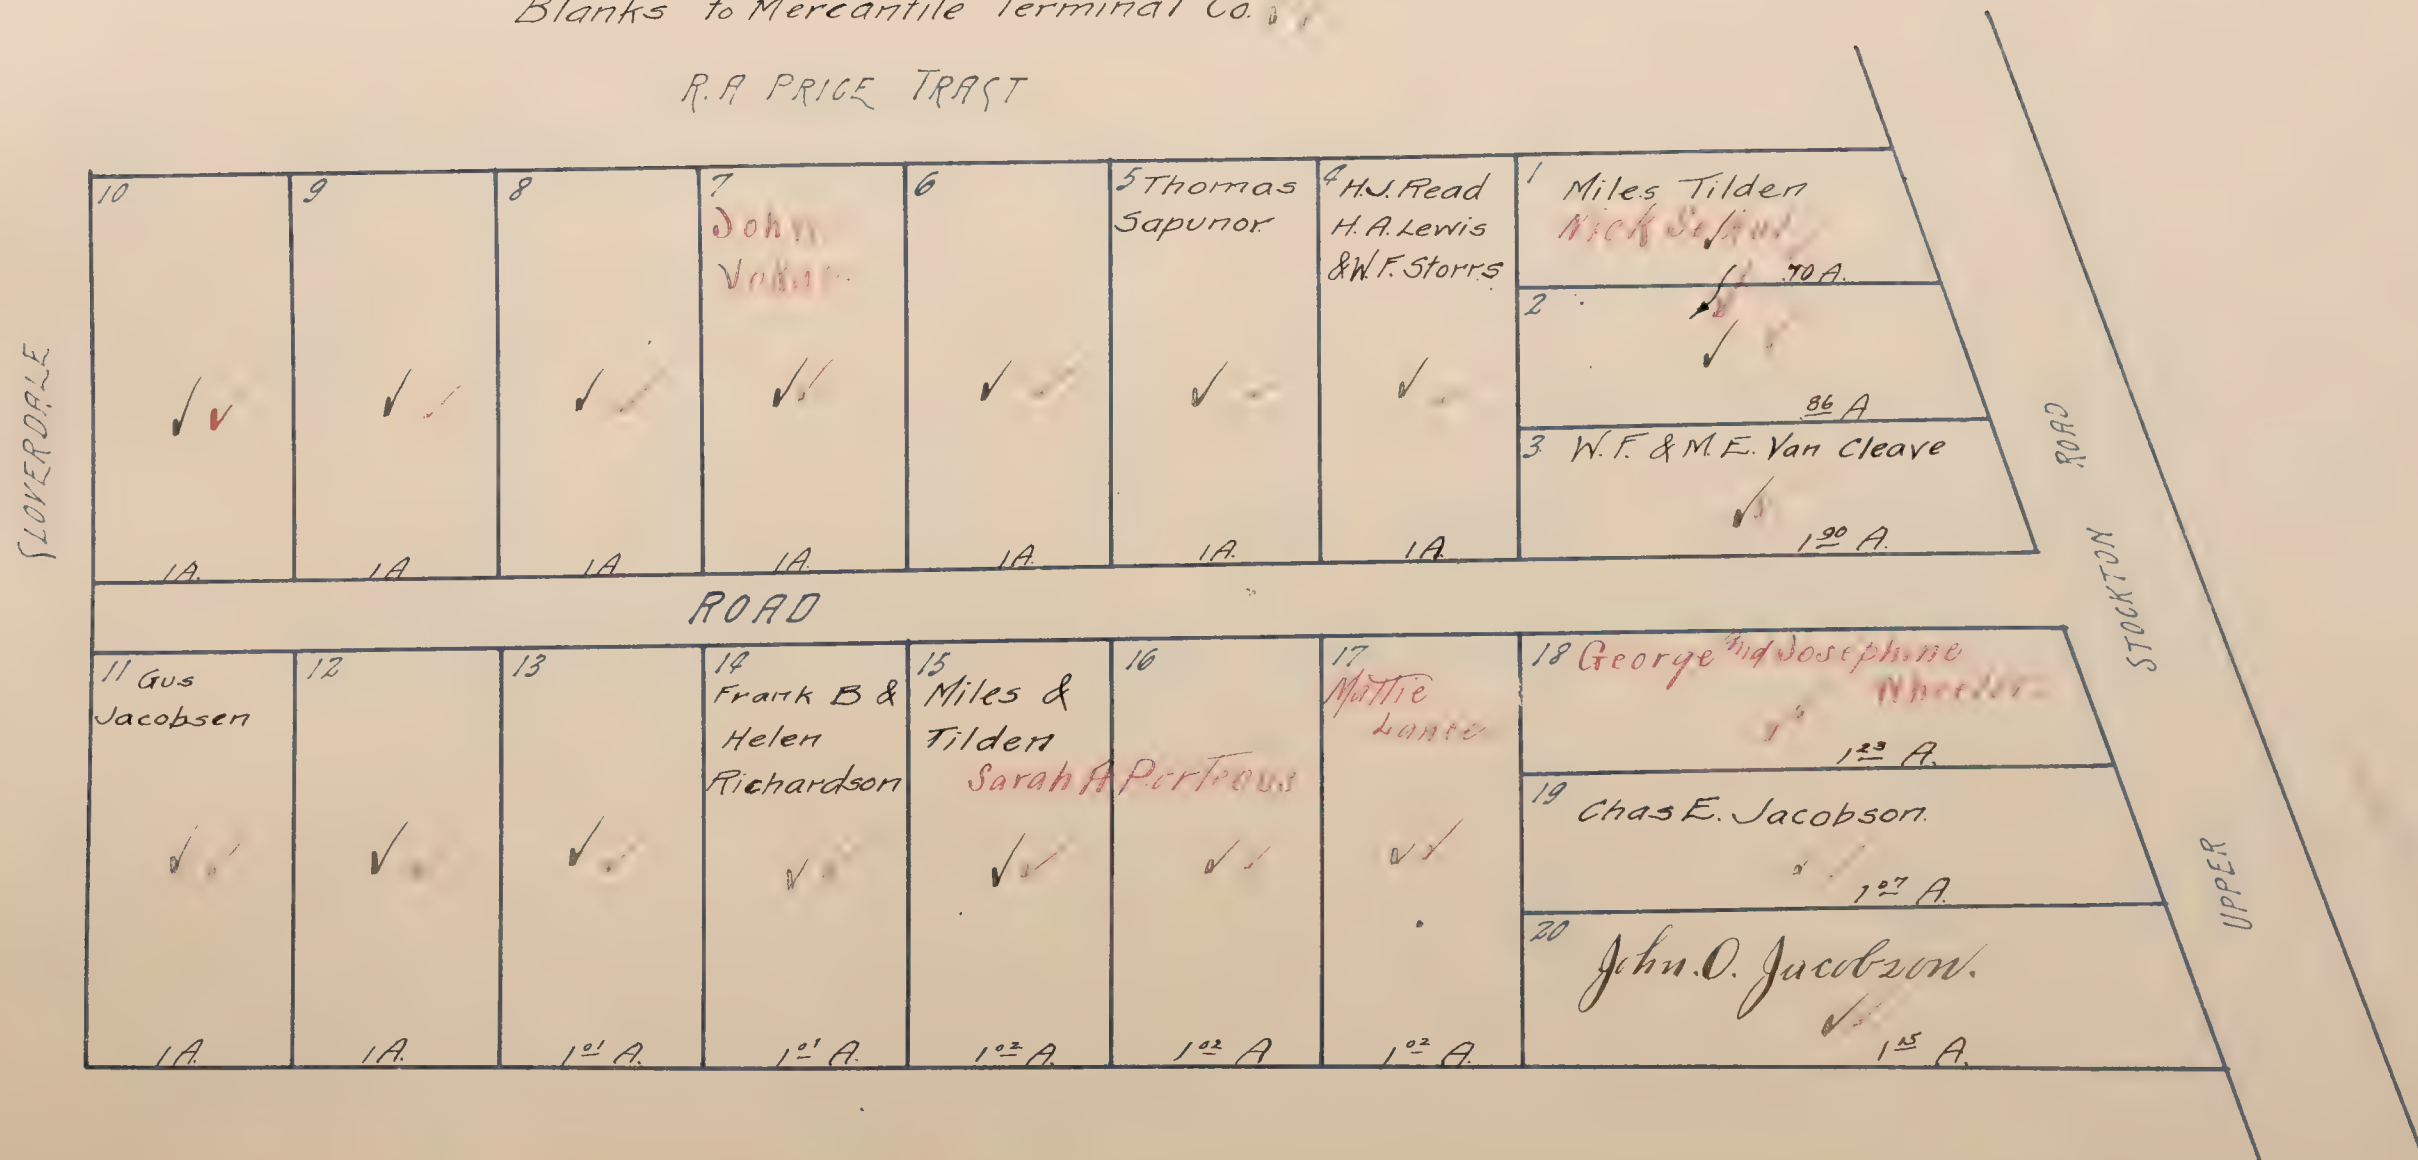

BRIGHTON VICINITY

Scale 10 chains = 1 inch.

Black Ink-1919 Ownership
Red Ink-1920 Ownership

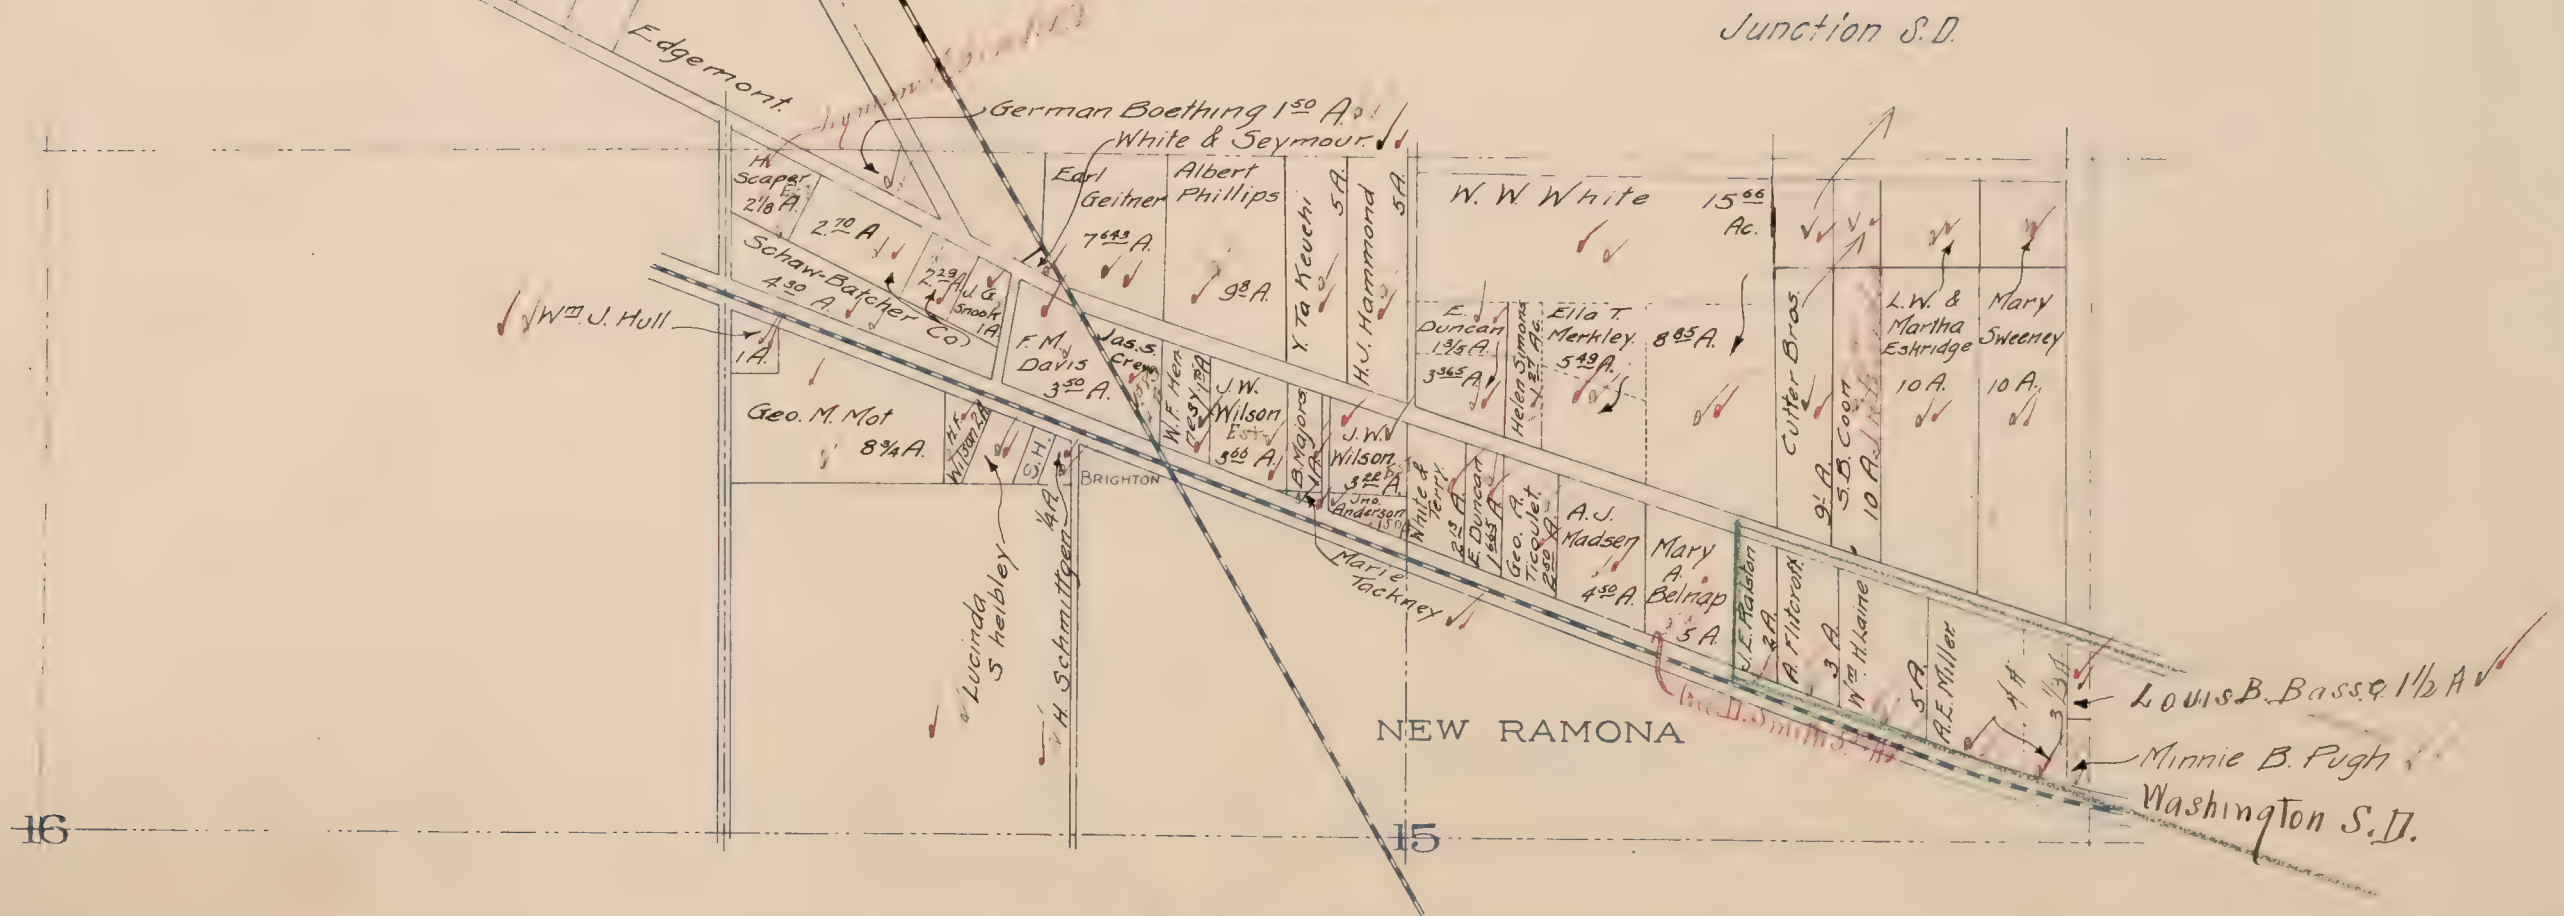

Black Ink-1919 Ownership
Red Ink-1920 Ownership

PERKINS

Washington S.D.



Mapped.


Black Ink-1919 Ownership
Red Ink-1920 Ownership

BRIGHTON ADDITION

H.J. GOETHE CO'S SUBDIVISION III.

Scale 60 feet = 1 inch

Junction S.D.

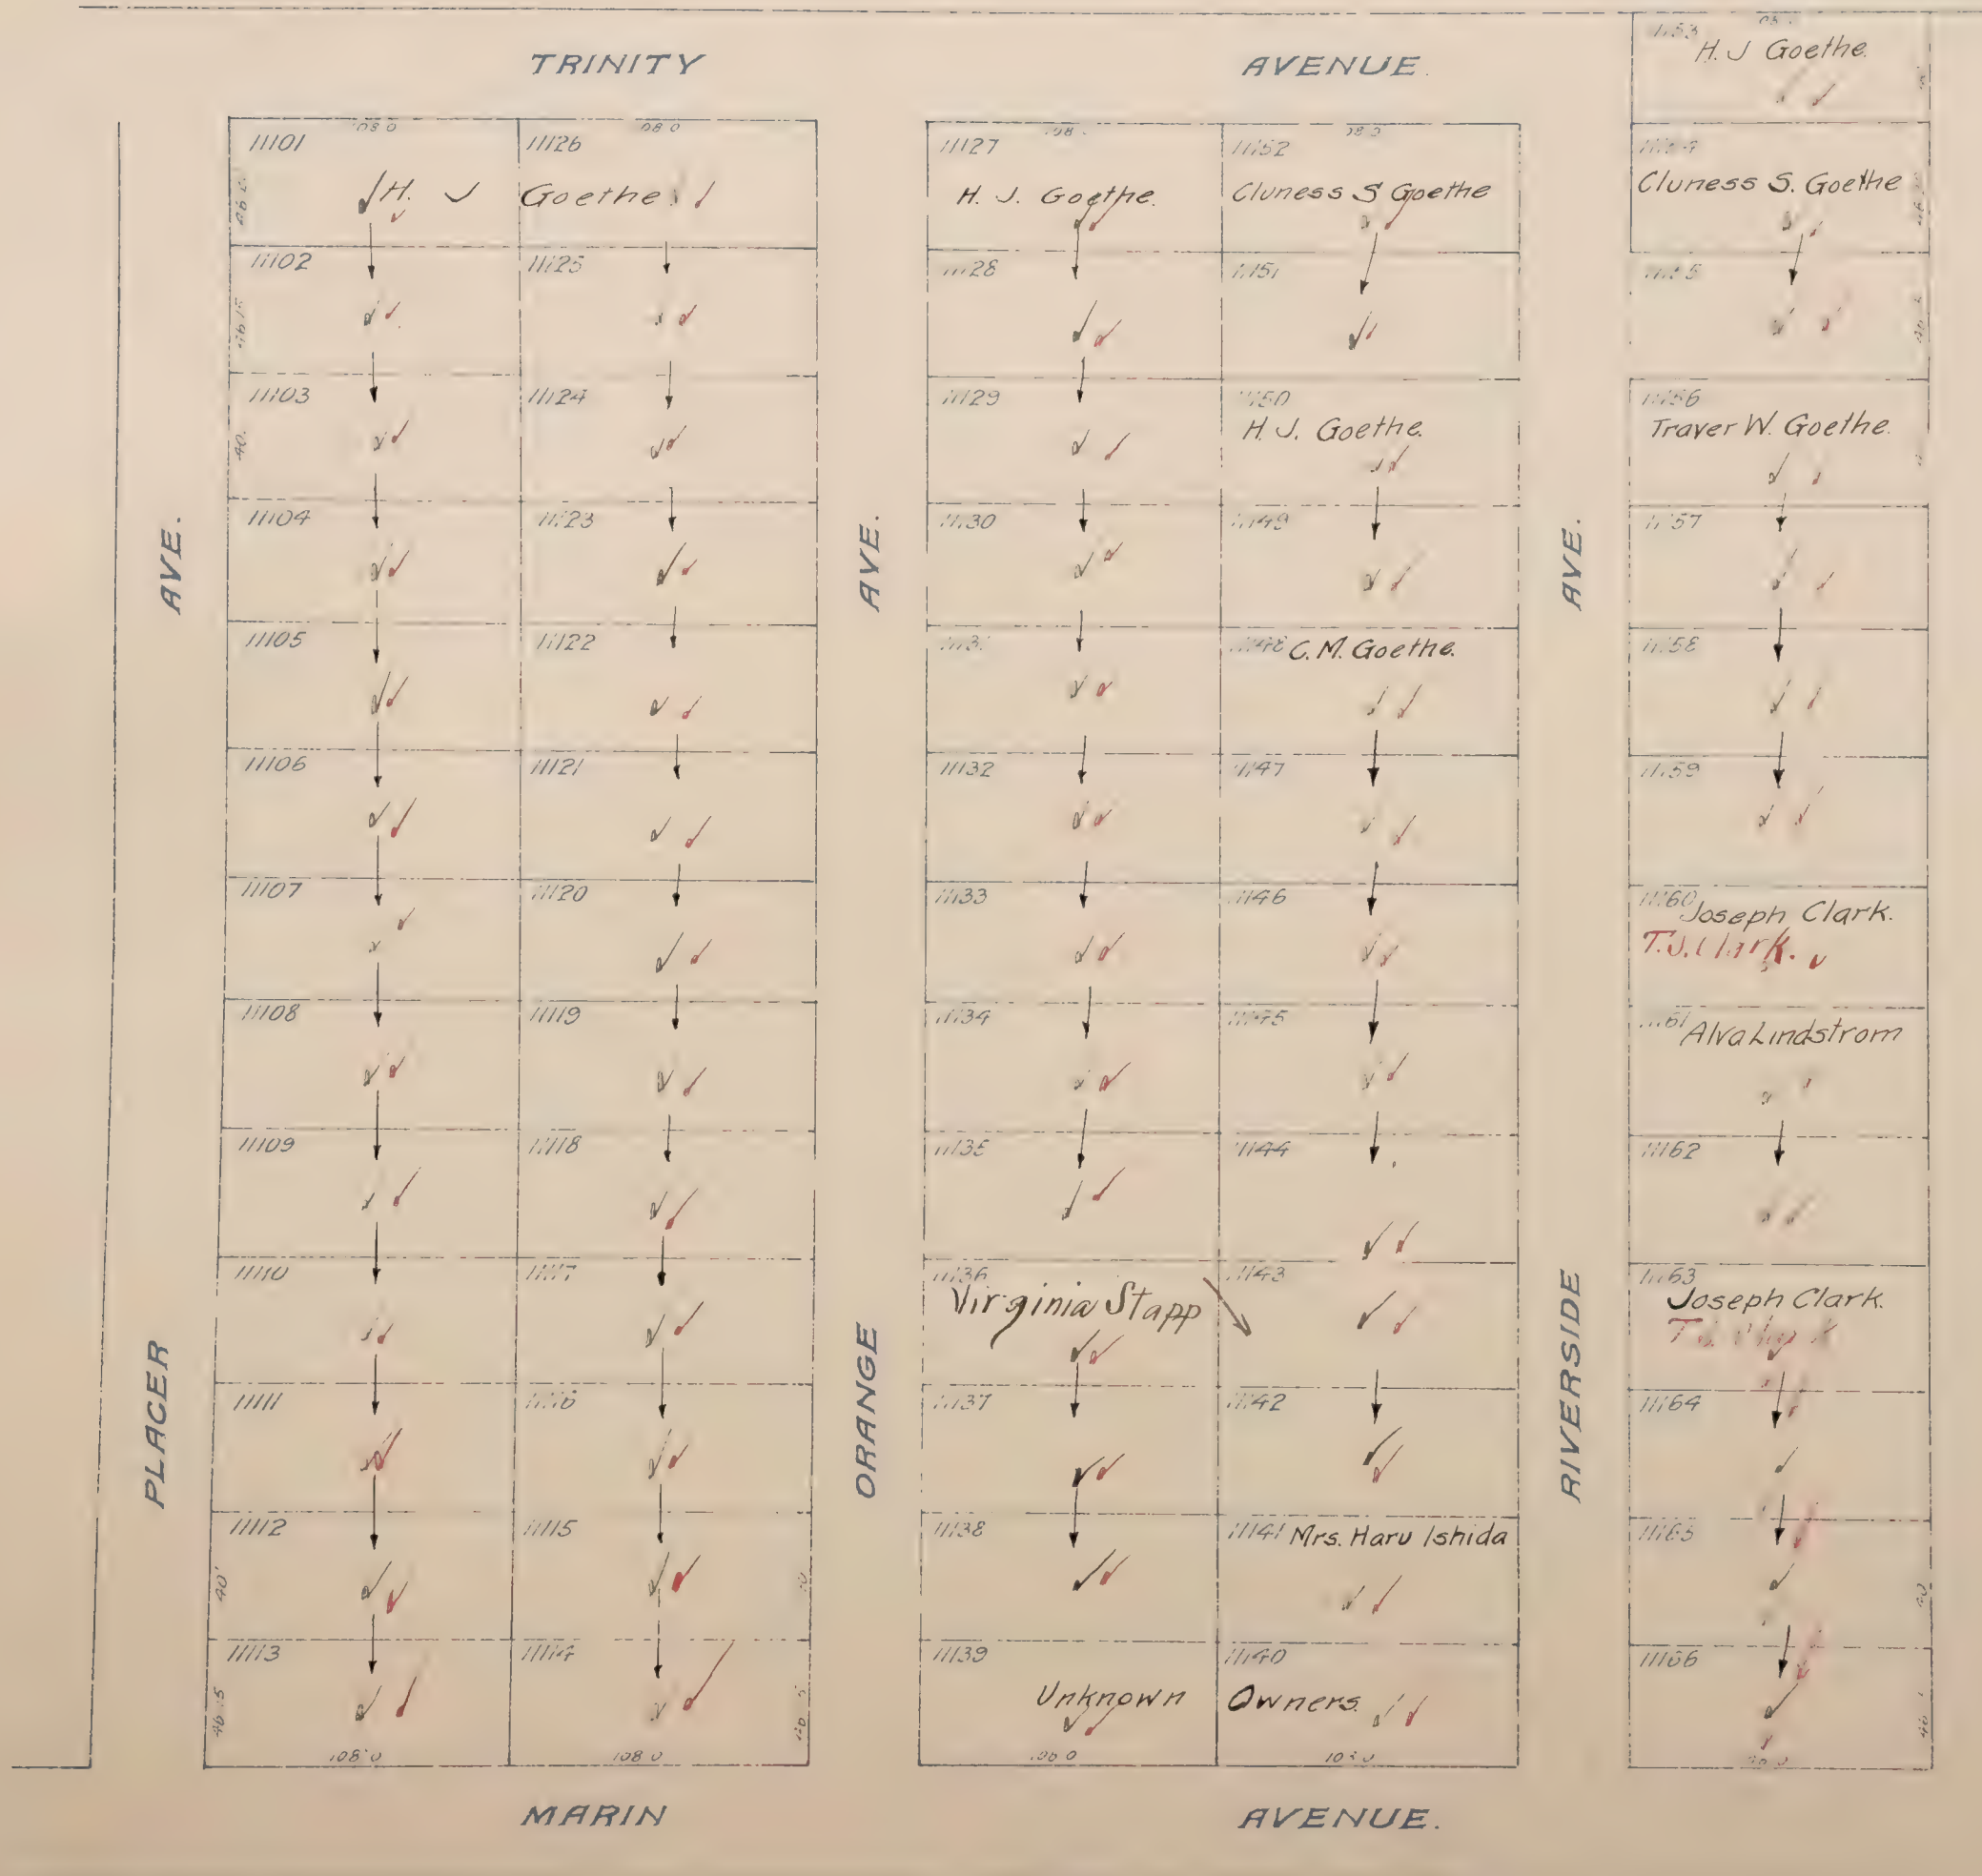


ADDITION "A" TO BRIGHTON

H.J. GOETHE CO'S SUBDIVISION No 114

Scale 100 feet = 1 inch

Black Ink-1919 Owners
Red Ink-1920 Owners

Junction S.D.

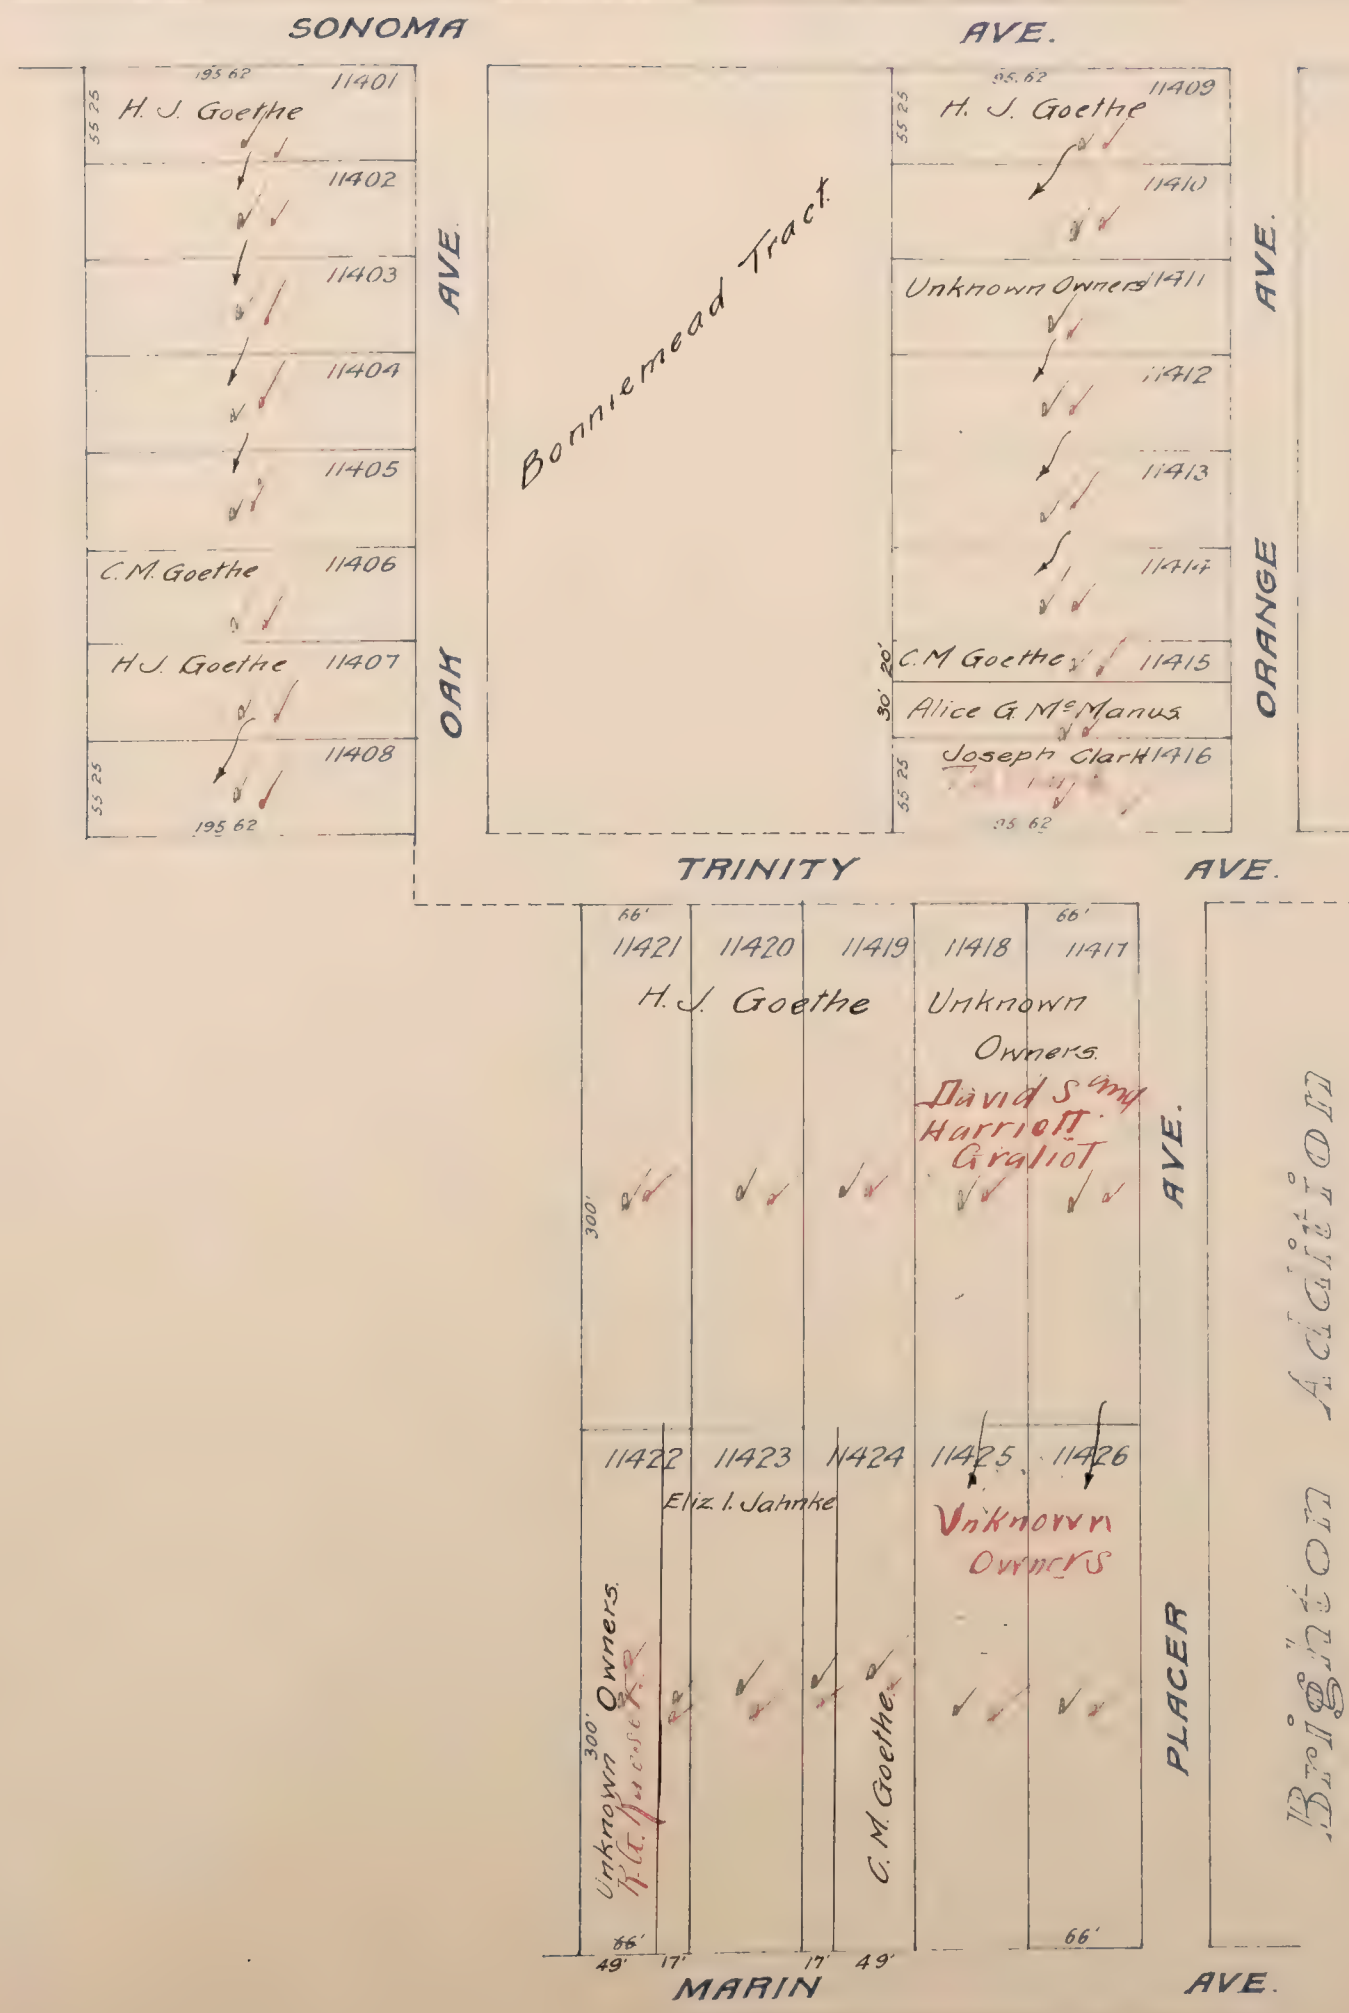

Mapped.

BRIGHTON HEIGHTS


Scale 1 in. = 100 ft.

LOCATED IN SEC. 15 T8 N. R. 5 E.

Blanks below assessed to *Anna Brackett* & *Mary J. Nichols* ✓

Black Ink-1919 Ownership
Red Ink-1920 Ownership

Junction S.D.

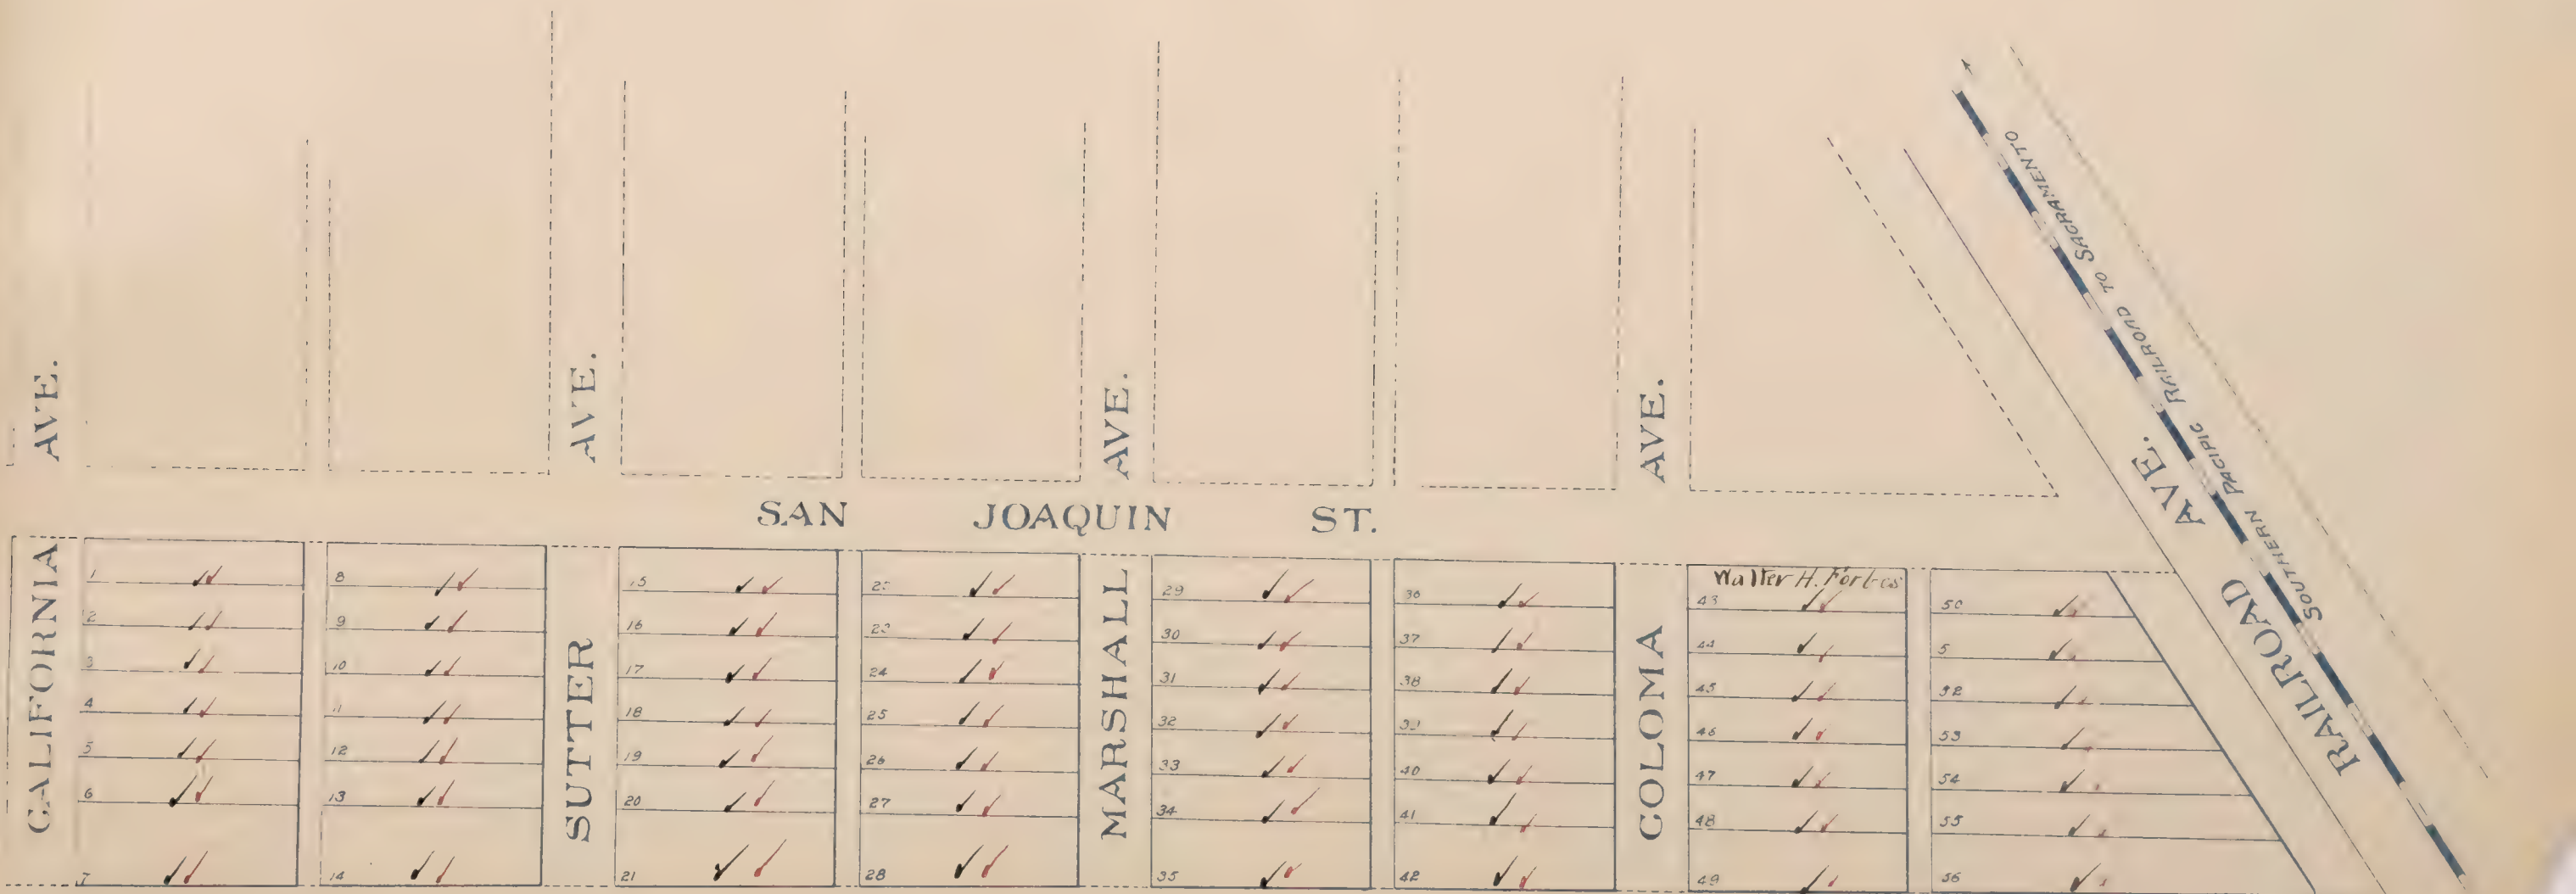

Black Ink-1919 Ownership
Red Ink-1929 Ownership


BRIGHTON PARK

LOCATED IN THE

N.E. 1/4 of Sec. 22, T. 8 N., R. 5 E.

Scale: 100' = 1"

Junction S.D.

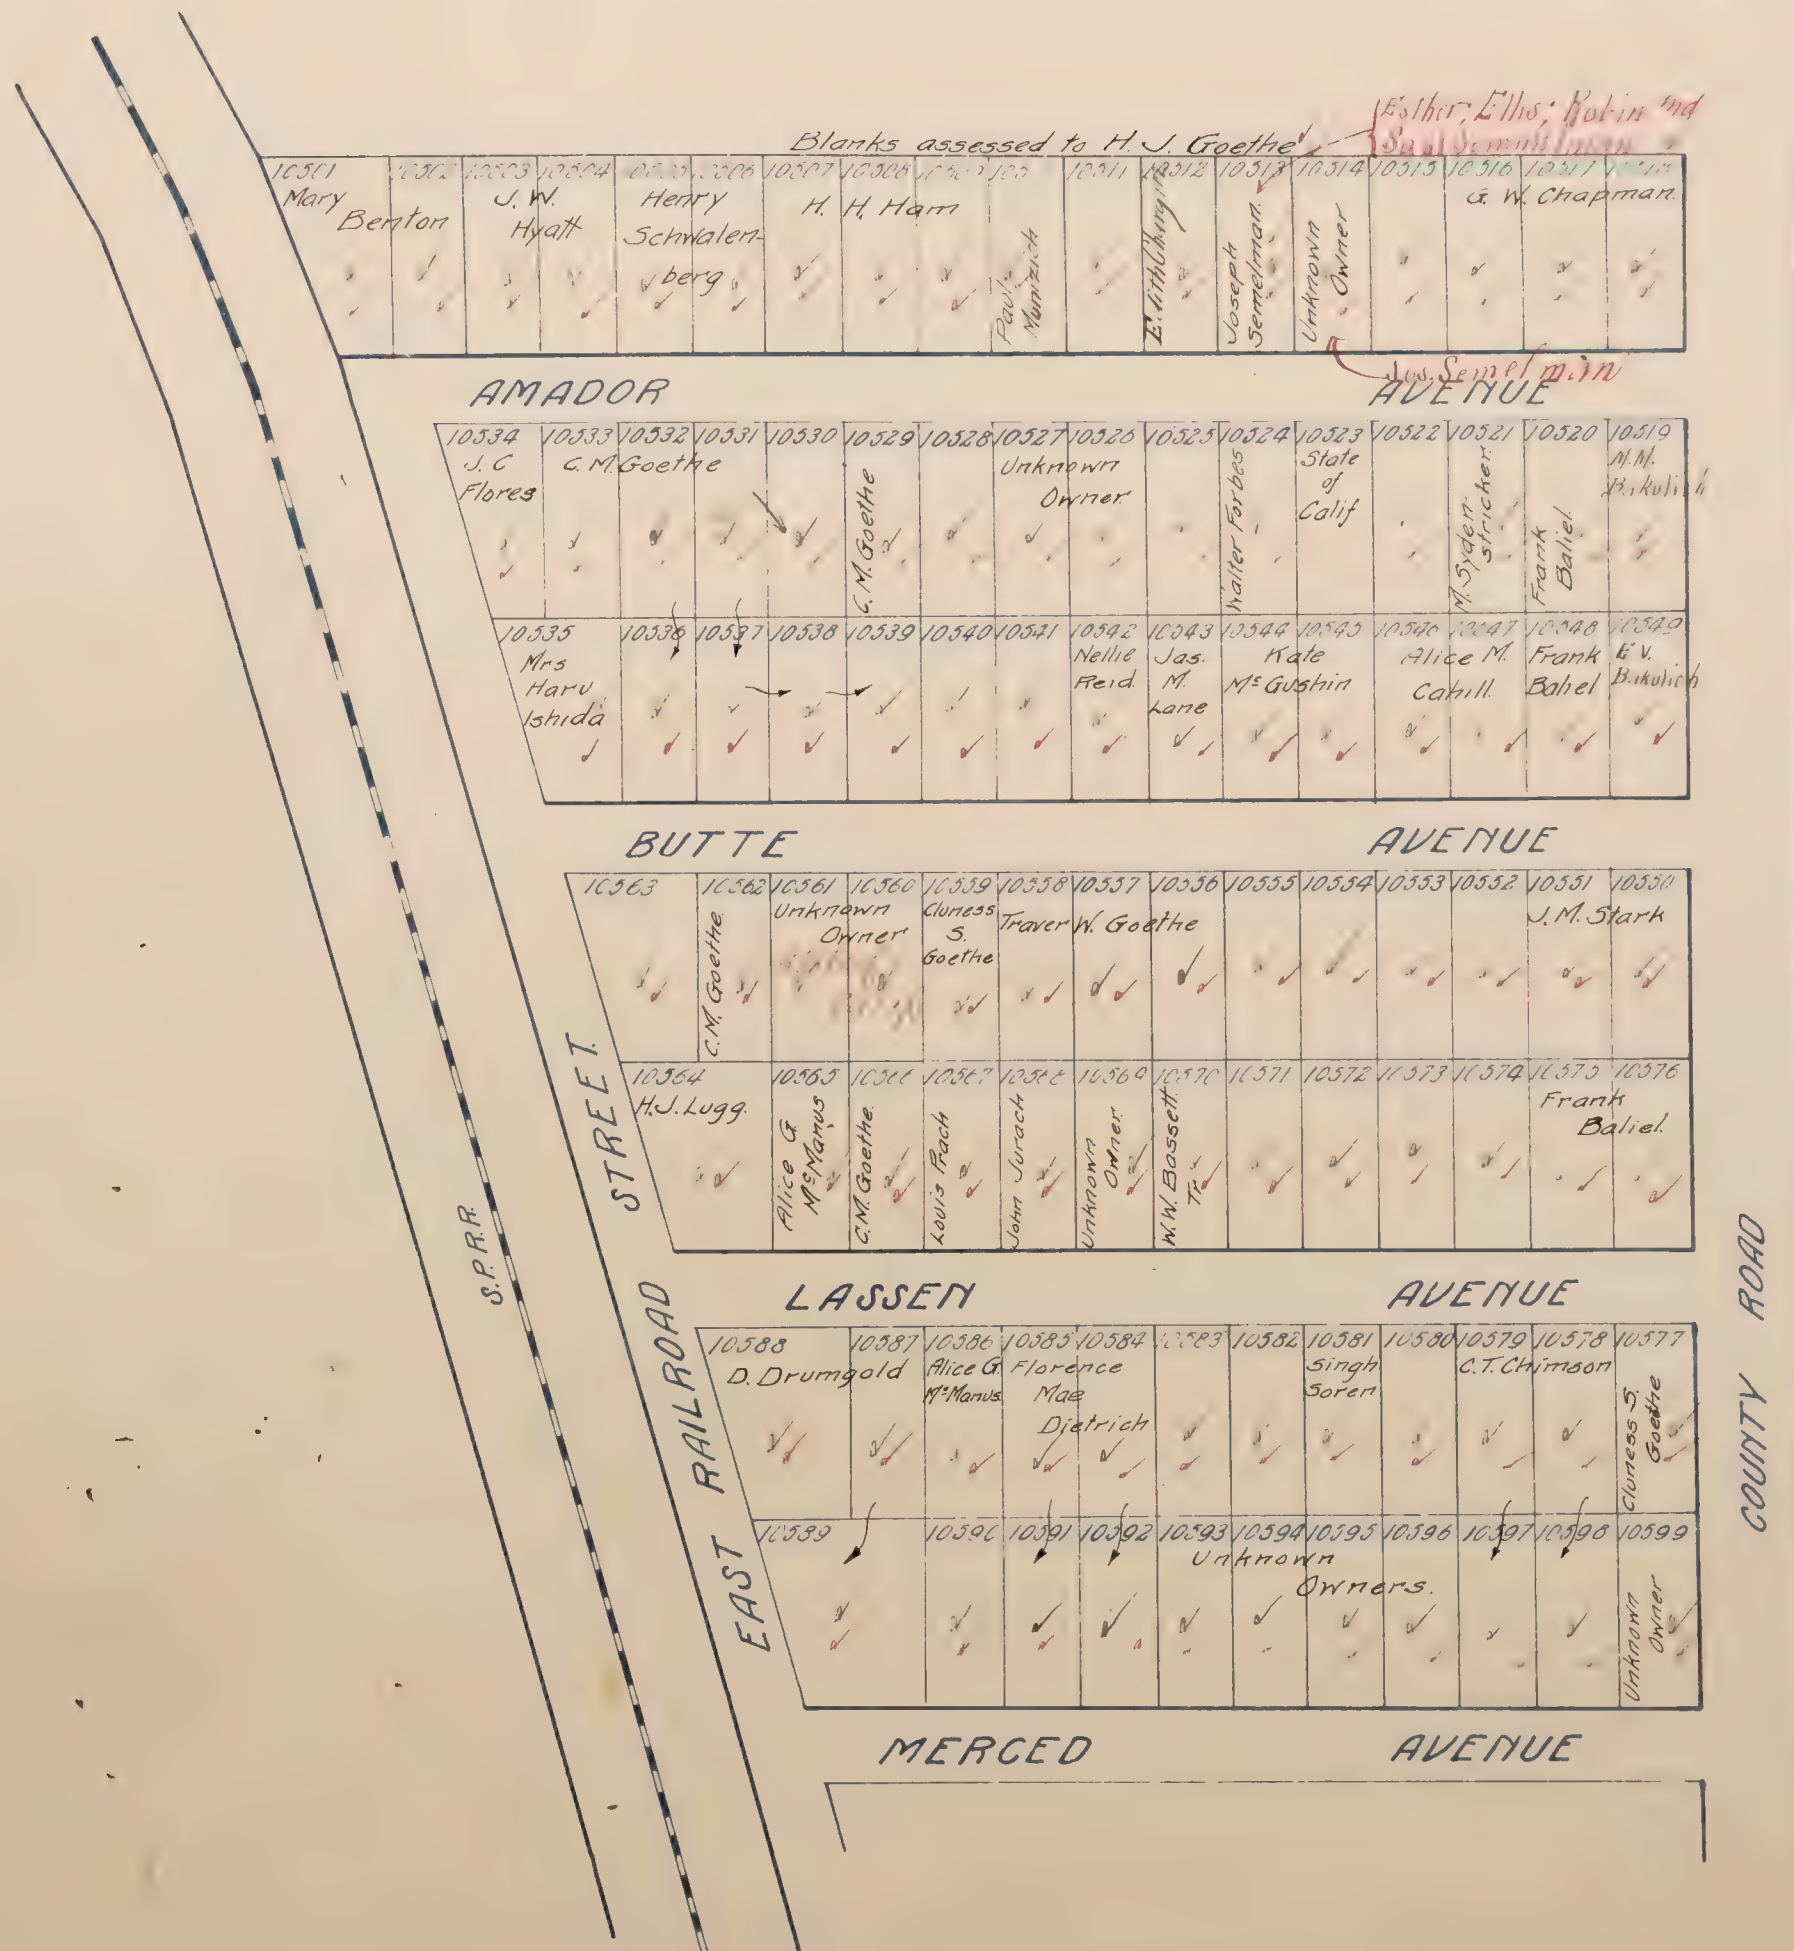

NEW BRIGHTON

LOCATED IN THE
N.E. 1/4 of Sec. 22, T. 8 N., R. 5 E.

Scale: 100' = 1"

Black Ink-1919 Ownership
Red Ink-1920 Ownership

Junction S.D.



259

Mapped

BRIGHTON TOWNSITE

Scale 160 Feet = 1 Inch

LOCATED IN SEC. 15 T. 8 N. R. 5 E.

Black Ink-1919 Ownership
Red Ink-1920 Ownership

All Blanks below assessed to Brighton Townsite Co.

Junction S.D.



Anna Bracken
2A

SOUTH BRIGHTON

SECTION 22 T. 8 N. R. 5 E.

Scale 80 feet = 1 inch.

Black Ink - 1919 Ownership
Red Ink - 1920 Ownership

Junction S.D.

COUNTY

ROAD

67 Louisa Micheli	68 E. A. Thiele	69 C. M. Goethe	70 Karl Bose	71 John H. Moon	72	73	74	75	1
✓	✓	✓	✓	✓	✓	✓	✓	✓	✓
41.65	82	81	80 Johanna Schmitt	79 G. Y. Conn	78 I. Shoda	77	76 A. H. Morgan Jr.	26	110'
93.7									

ROAD

2 H. A. McClelland	3 Kate Duval	4 A. B. Conradson	5 Nannie E. Everett	6 Grace W. Mabrey & Jules Darrell	7 Mrs. I. M. Lewis	8	9 W. F. Gormley	10	11 Mary L. O'Neil	12	13
✓	✓	✓	✓	✓	✓	✓	✓	✓	✓	✓	✓
25 Johanna Schmitt	24 W. R. Frazier	23	22 Darrow & Mabrey	21	20 Charlotte Burgess	19	18 C. M. Goethe	17 Karl Stase	16 Johanna Schmitt	15 Eda C. Mason	14
✓	✓	✓	✓	✓	✓	✓	✓	✓	✓	✓	✓

CLIFTON

ROAD

83 Lea L. Nicolasi	84 Walter Maynard	85 A. H. Morgan Sr.	86	87	88	89 A. H. Morgan	27
✓	✓	✓	✓	✓	✓	✓	✓
31.3	94 H. J. Goethe	93 Jas. Doran	92 Mary L. O'Neil	91 H. J. Goethe	90	52 Alice G. McManus	110'
36.1							

ABBEY

28 Anne McClelland	29 Ruth M. McManus Poston	30 Wm. Faust	31 Wm. Magennis	32 Lotta Johnson	33 Maria W. Wentworth	34 Ellen Bowden	35	36 John A. Button	37	38 Mary L. O'Neil	39
✓	✓	✓	✓	✓	✓	✓	✓	✓	✓	✓	✓
51 A. G. McManus	50	49 H. H. Hook	48	47 J. A. Williams	46	45 E. Jenkins	44 Cora Templeton	43	42 Brooke Realty Co.	41 W. R. Frazier	40
✓	✓	✓	✓	✓	✓	✓	✓	✓	✓	✓	✓

CARLTON

ROAD

95 E. Jenkins	96	97 J. A. Inlow	98	53	54 Mrs. I. M. Lewis	55 Edith N. Rath	56 Laura Flanders	57 Ellen Bowden	58	59 Kate Stahl	60	61 A. C. Heisen	62 Alva Lindstrom	63 Marie Ruedy	64 August Ruedy	65 Ed. Anderson	66
✓	✓	✓	✓	✓	✓	✓	✓	✓	✓	✓	✓	✓	✓	✓	✓	✓	✓
66.75	28.25																

ST.

S. P. R. R.

EAST RAILROAD

Black Ink-1919 Ownership
Red Ink-1920 Ownership

BRINKMEYER'S SUBDIVISION N^o1

LOCATED IN
Sec. 16 Del Paso Grant.
Scale 1"=200'

Blanks to Margaret Brinkmeyer. ✓✓

N. Sacto. S.D.




CALIFORNIA ACRES

TRACT No. 1
located in
Sections 3-4 T.5N. R.7E.
Scale 1" = 400 ft.

Mapped.
Black Ink-1919 Ownership
Red Ink-1920 Ownership

Alabama S.D.


Blanks to California Acres Company V

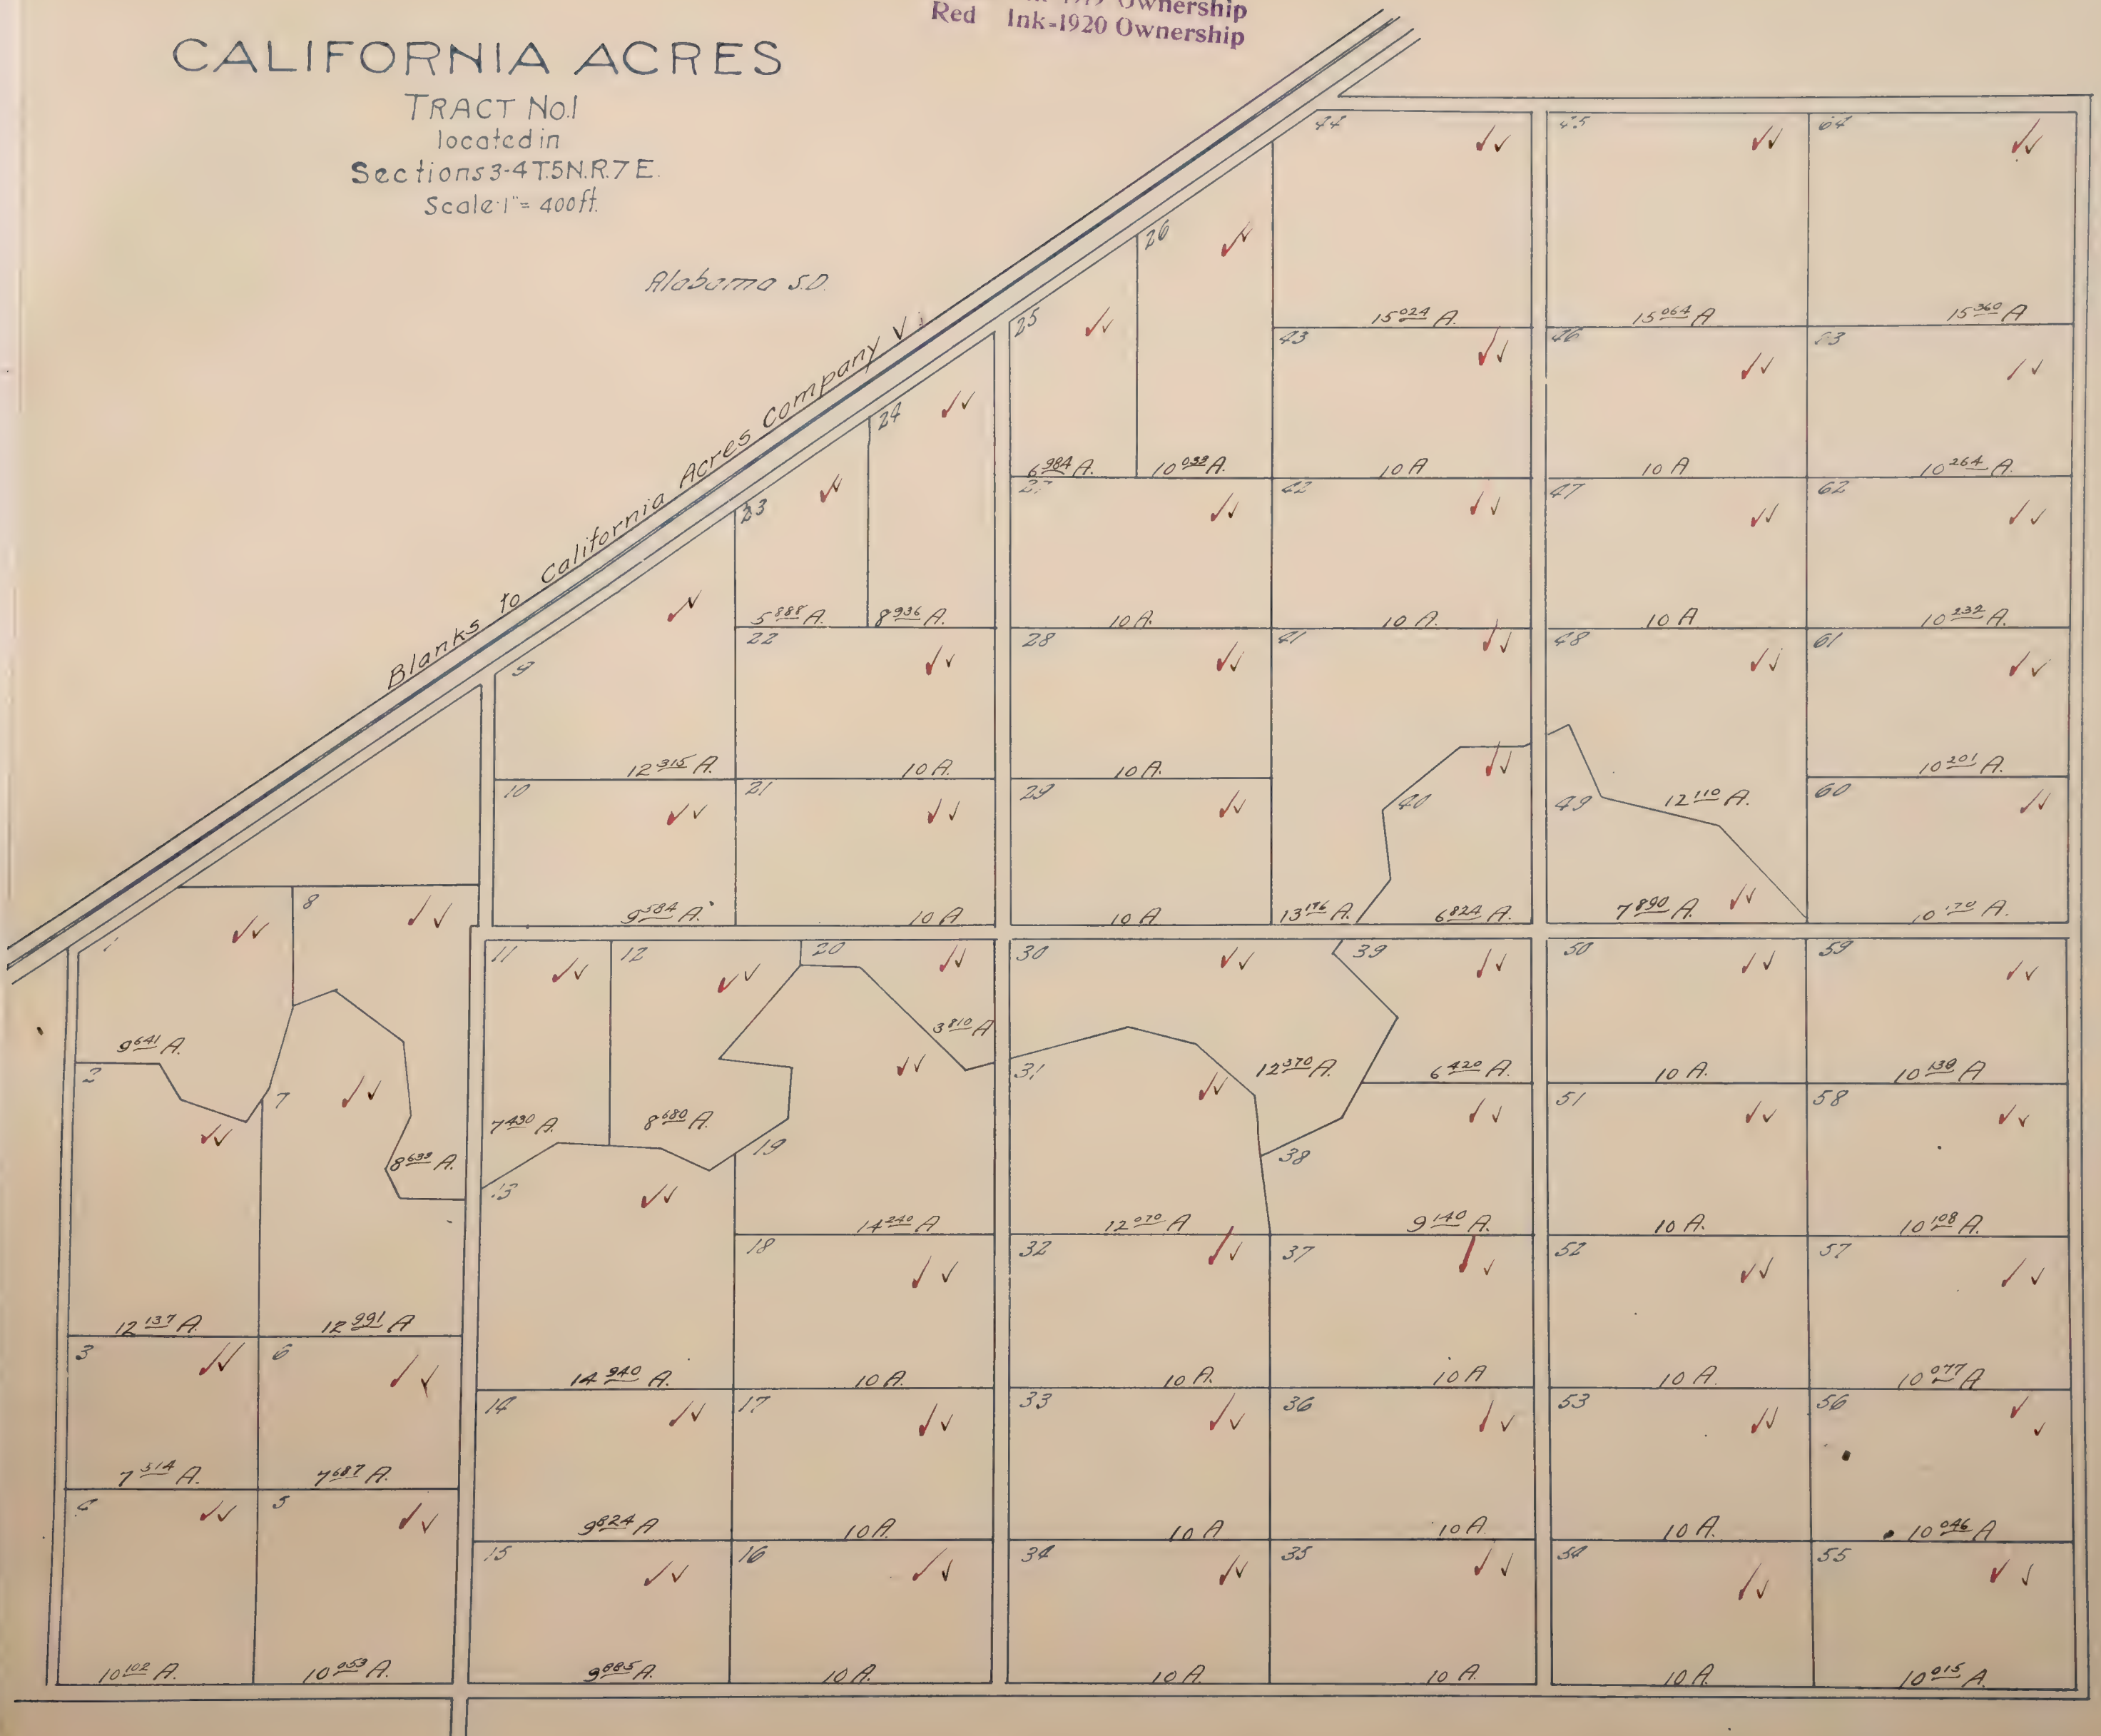

CALIFORNIA

CAMELLIA ACRES
BEING THE
S.W. 1/4 of Sec. 31, T. 8 N., R. 6 E
Scale 1" = 300'

Blanks to T. Wah Hing & Song Hing. ✓

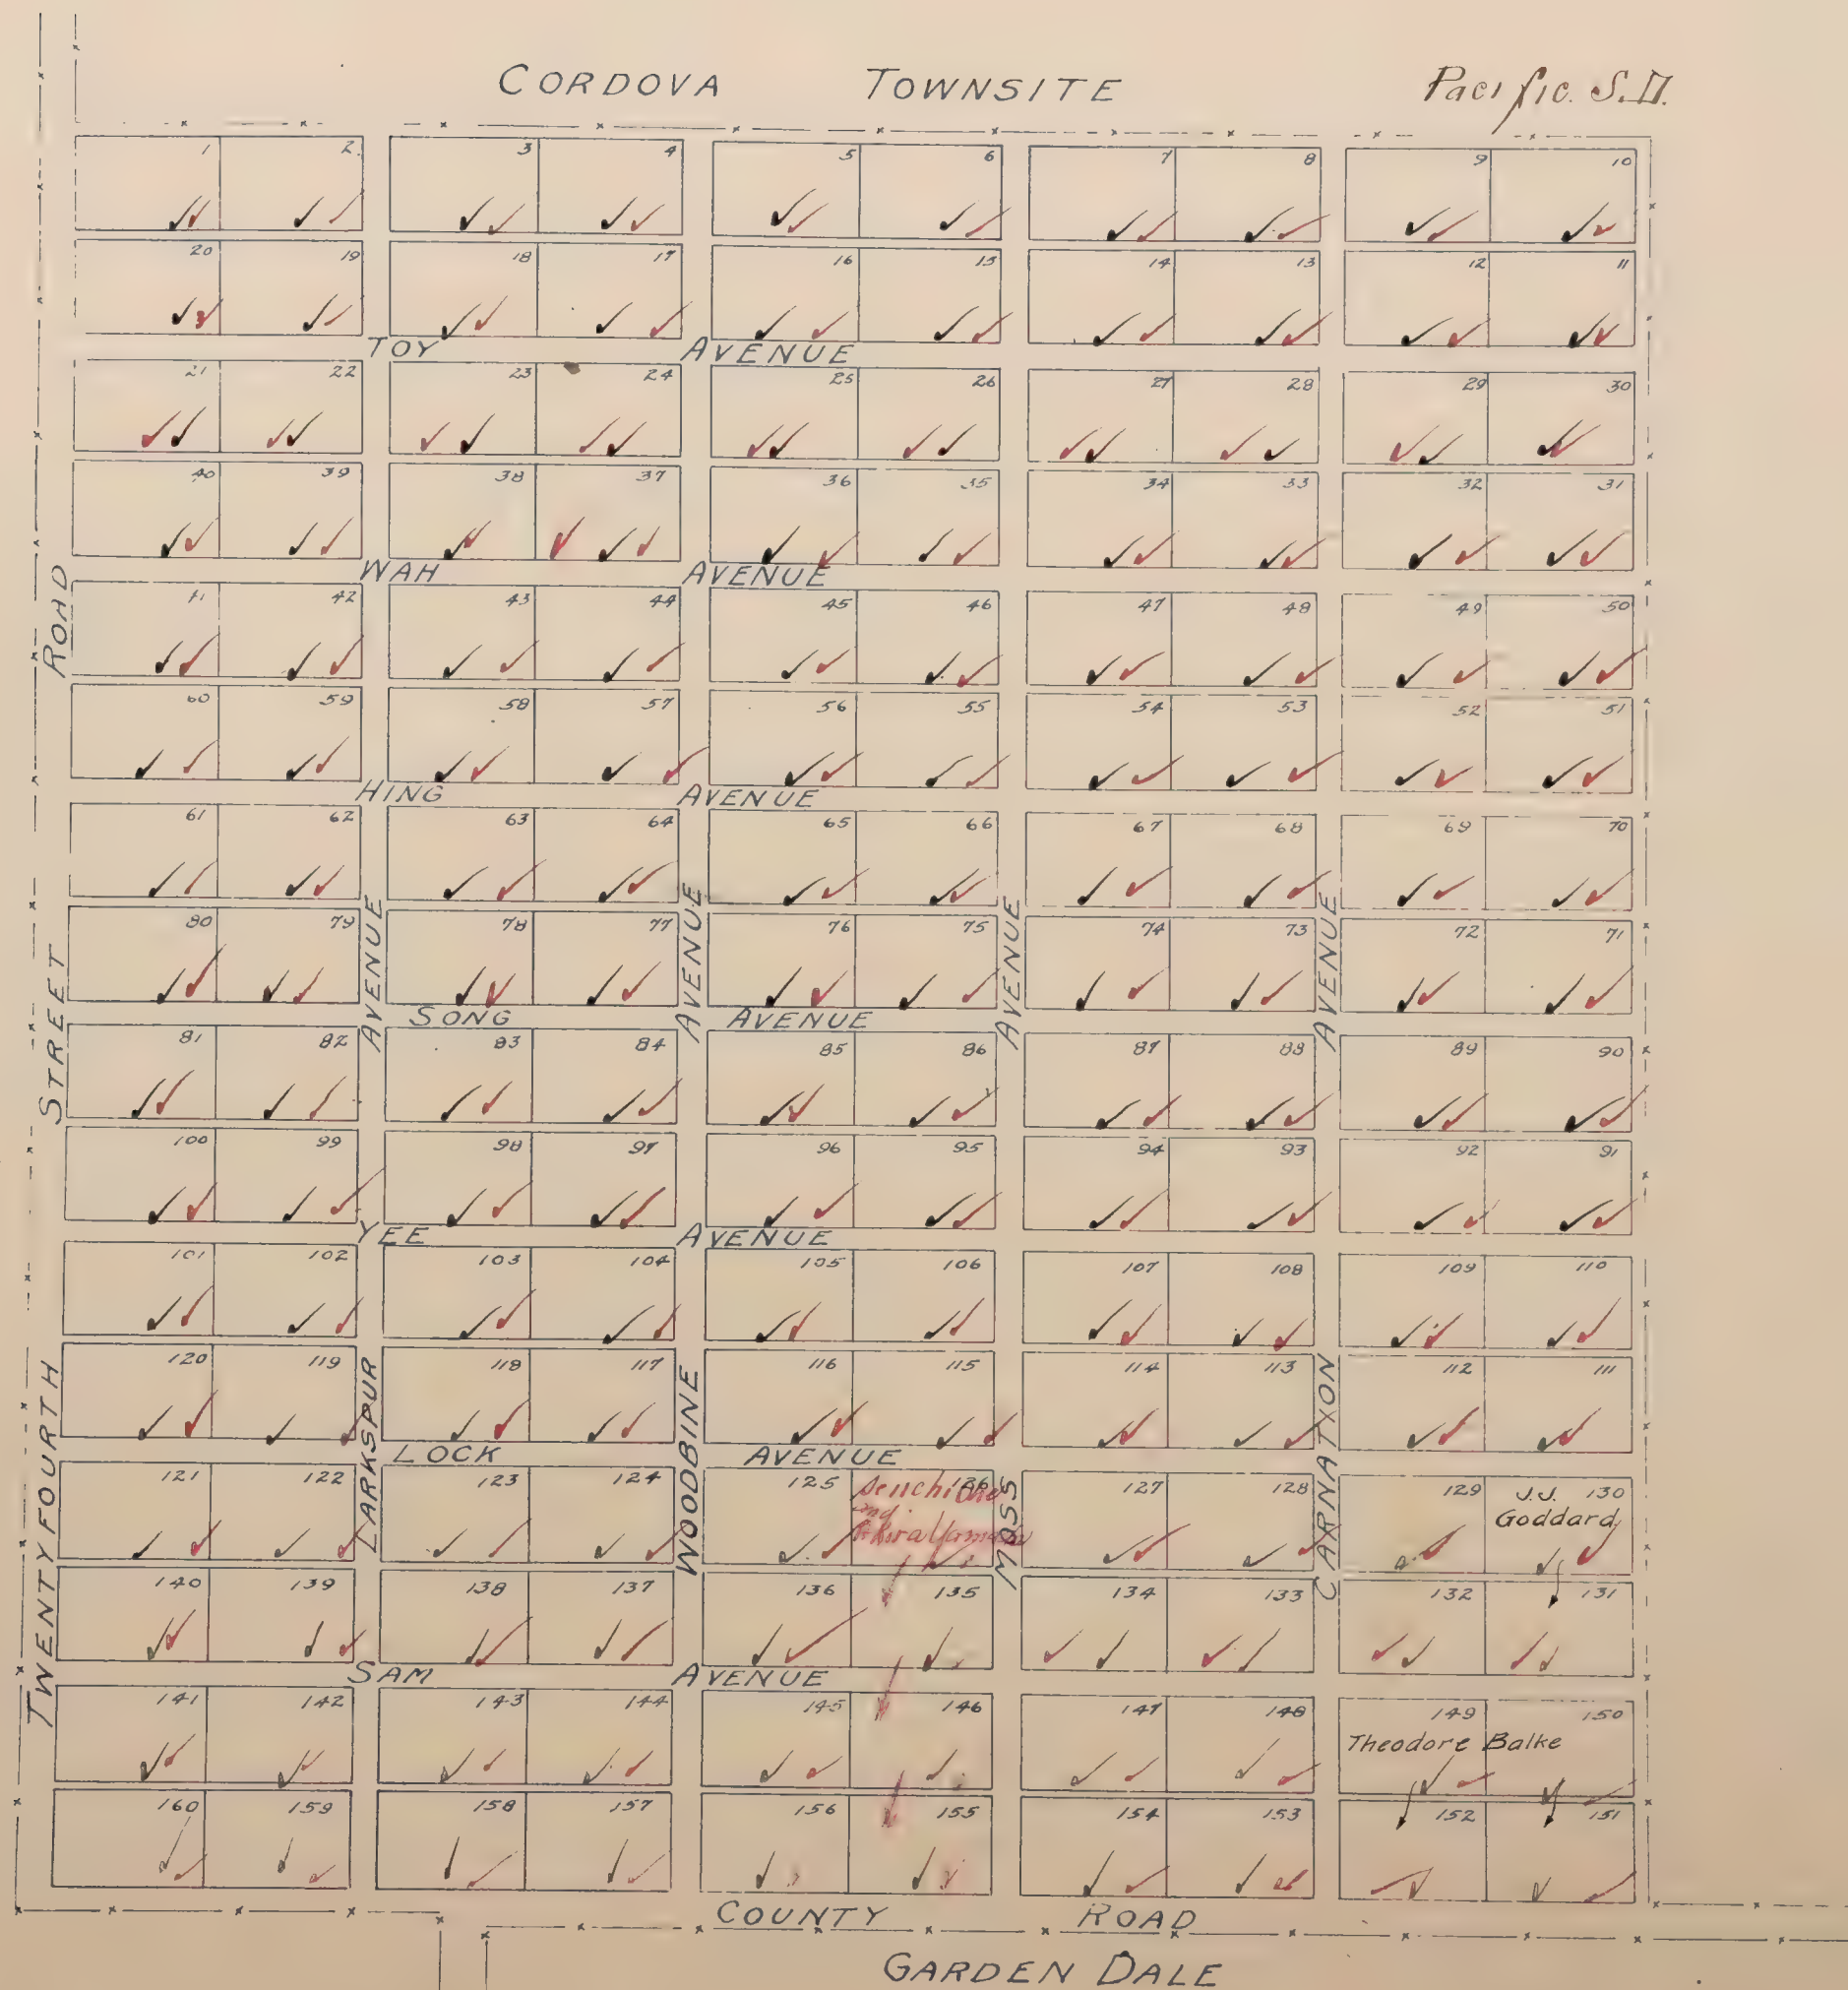


Mapped.

Black Ink-1919 Ownership
Red Ink-1920 Ownership

CAMELLIA HEIGHTS

LOCATED IN THE
N.E. 1/4 of Sec. 19, T8N R.5E

Scale: 125' = 1"

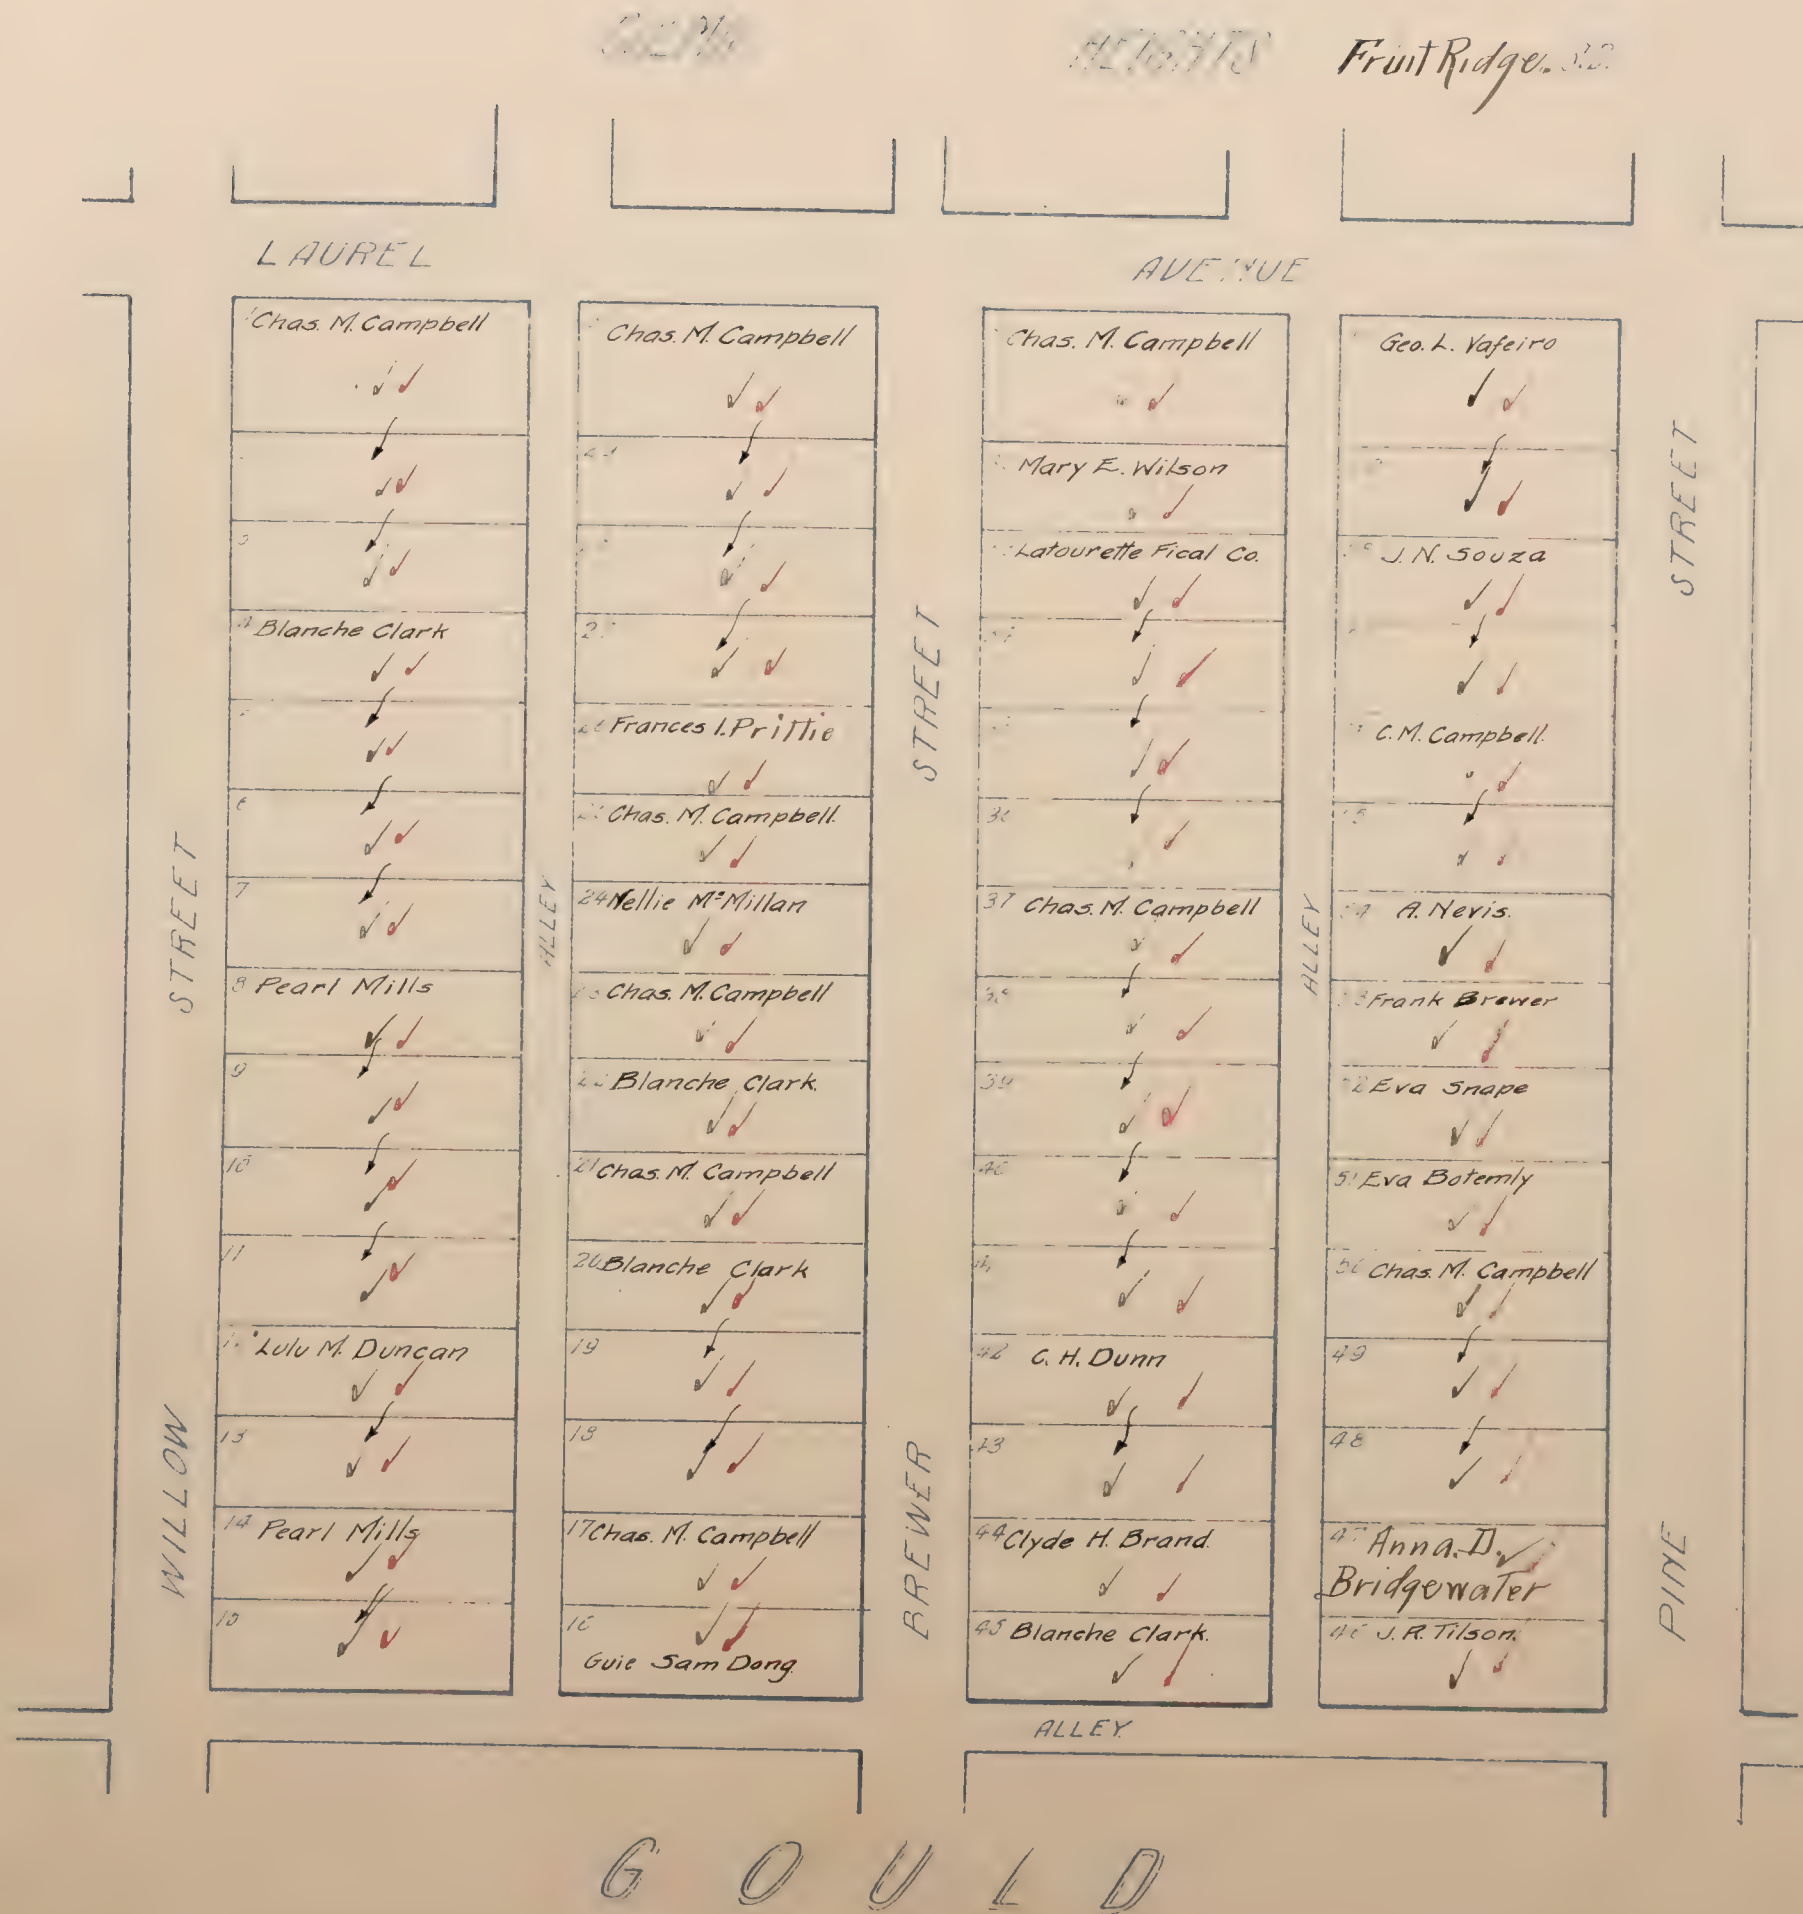

Mapped.

CAMELLIA HEIGHTS

LOCATED IN THE
N.E. 1/4 of Sec. 19, T8N., R5E

Black Ink - 1910 Ownership
Red Ink - 1920 Ownership
Blanks assessed to Frank Brewer ✓ Fruit Ridge, D

PHILYETIO

HEIGHTS

1/2 1/2 SUBDIVISION

LAUREL

AVENUE

STREET

PINE

61 Fay Brewer	✓✓
62	✓✓
63	✓✓
64	✓✓
65	✓✓
66 Ray C. Waring	✓✓
67 Blanche Clark	✓✓
68	✓✓
69	✓✓
70	✓✓
71	✓✓
72	✓✓
73	✓✓
74	✓✓
75	✓✓

ALLEY

80 Chas. M. Campbell	✓✓
82	✓✓
83	✓✓
84	✓✓
85 Fay Brewer	✓✓
86	✓✓
87 L. Bloomberg	✓✓
88 Fay Brewer	✓✓
89 L. Bloomberg	✓✓
90	✓✓
91	✓✓
92	✓✓
93	✓✓
94	✓✓
95	✓✓
96	✓✓

ALLEY

STREET

MAPLE

Checked in Acreage.	
91	✓✓
92	✓✓
93	✓✓
94	✓✓
95	✓✓
96	✓✓

ALLEY

STREET

HICKORY

100 Nellie & Edw. Everett	✓✓
101	✓✓
102	✓✓
103	✓✓
104	✓✓

TERRACE AVENUE

105 Nellie & Edw. Everett	✓✓
106	✓✓
107	✓✓
108	✓✓
109	✓✓
110	✓✓
111	✓✓
112	✓✓
113	✓✓
114	✓✓

Theodore J. Miller

G O U L D


Mapped.

Black Ink-1919 Ownership
Red Ink-1920 Ownership
CAMELLIA PARK

LOCATED IN
SECS 29 & 30 T8N R5E
Scale 500'-1"

PLAT 50


Blanks below assessed to Song Hing

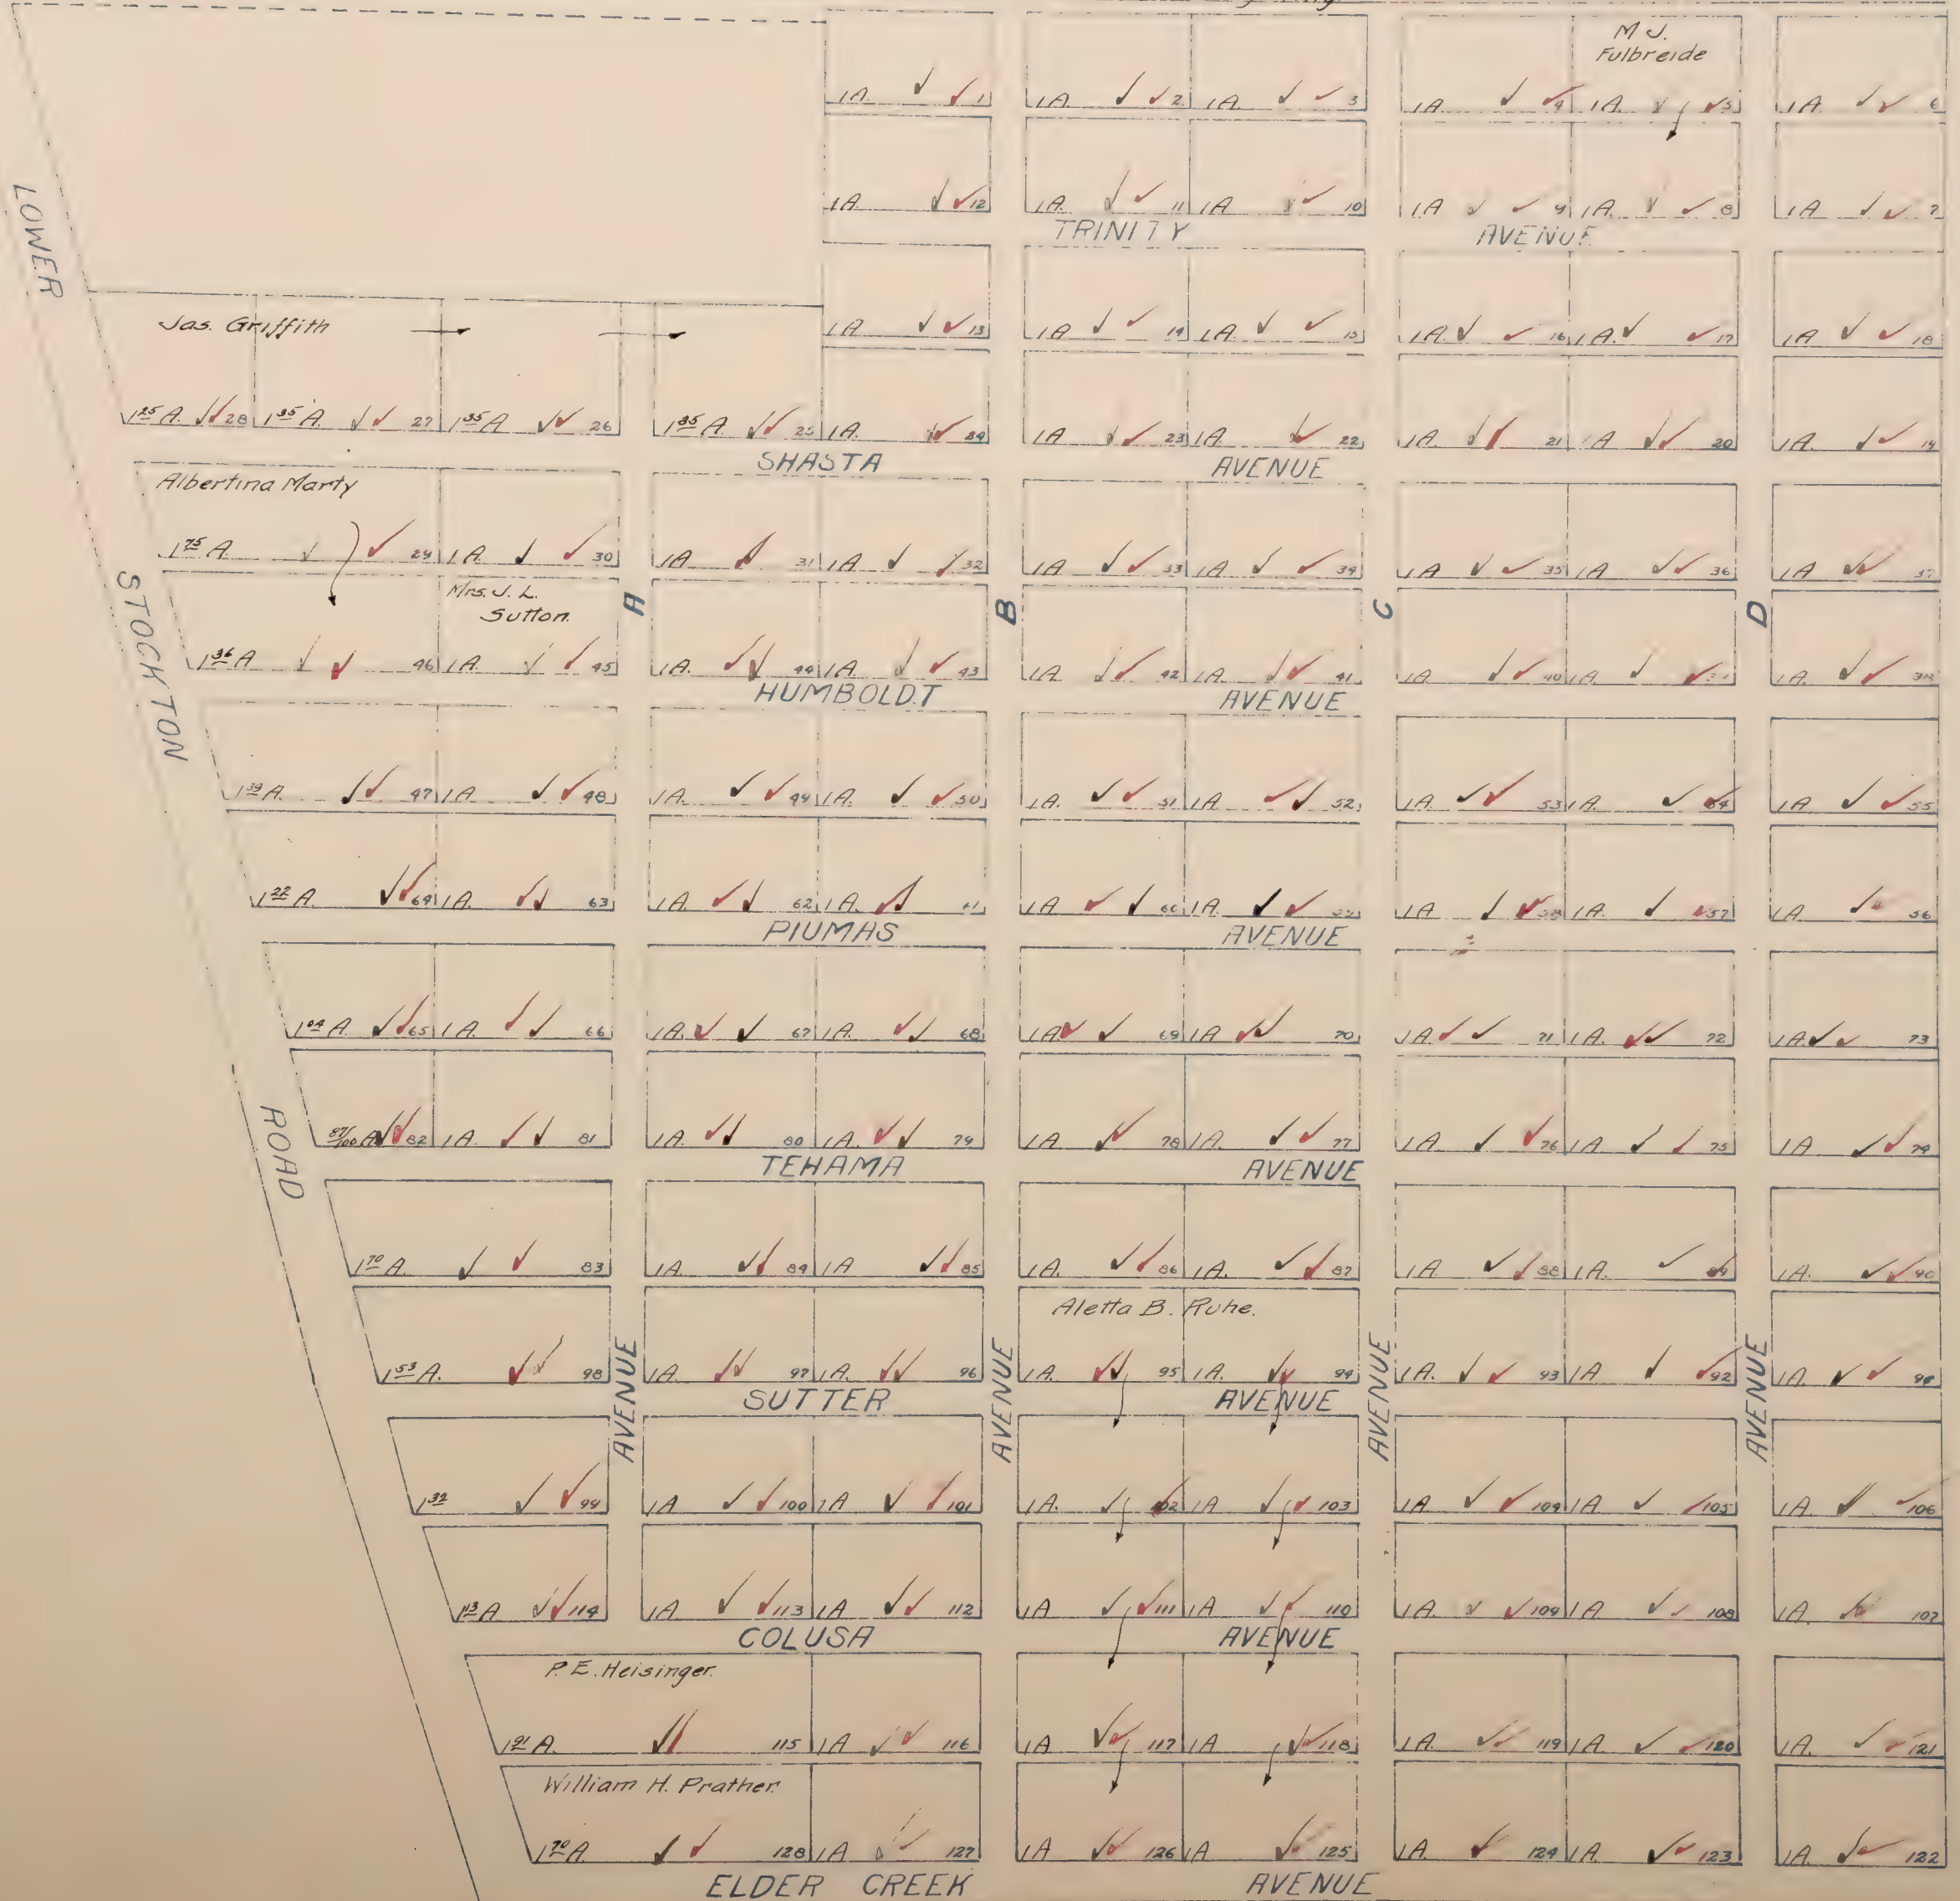

CARDWELL COLONY.

Blanks to P.S. & B.F. Driver ✓✓

ORANGE VALE S. D.

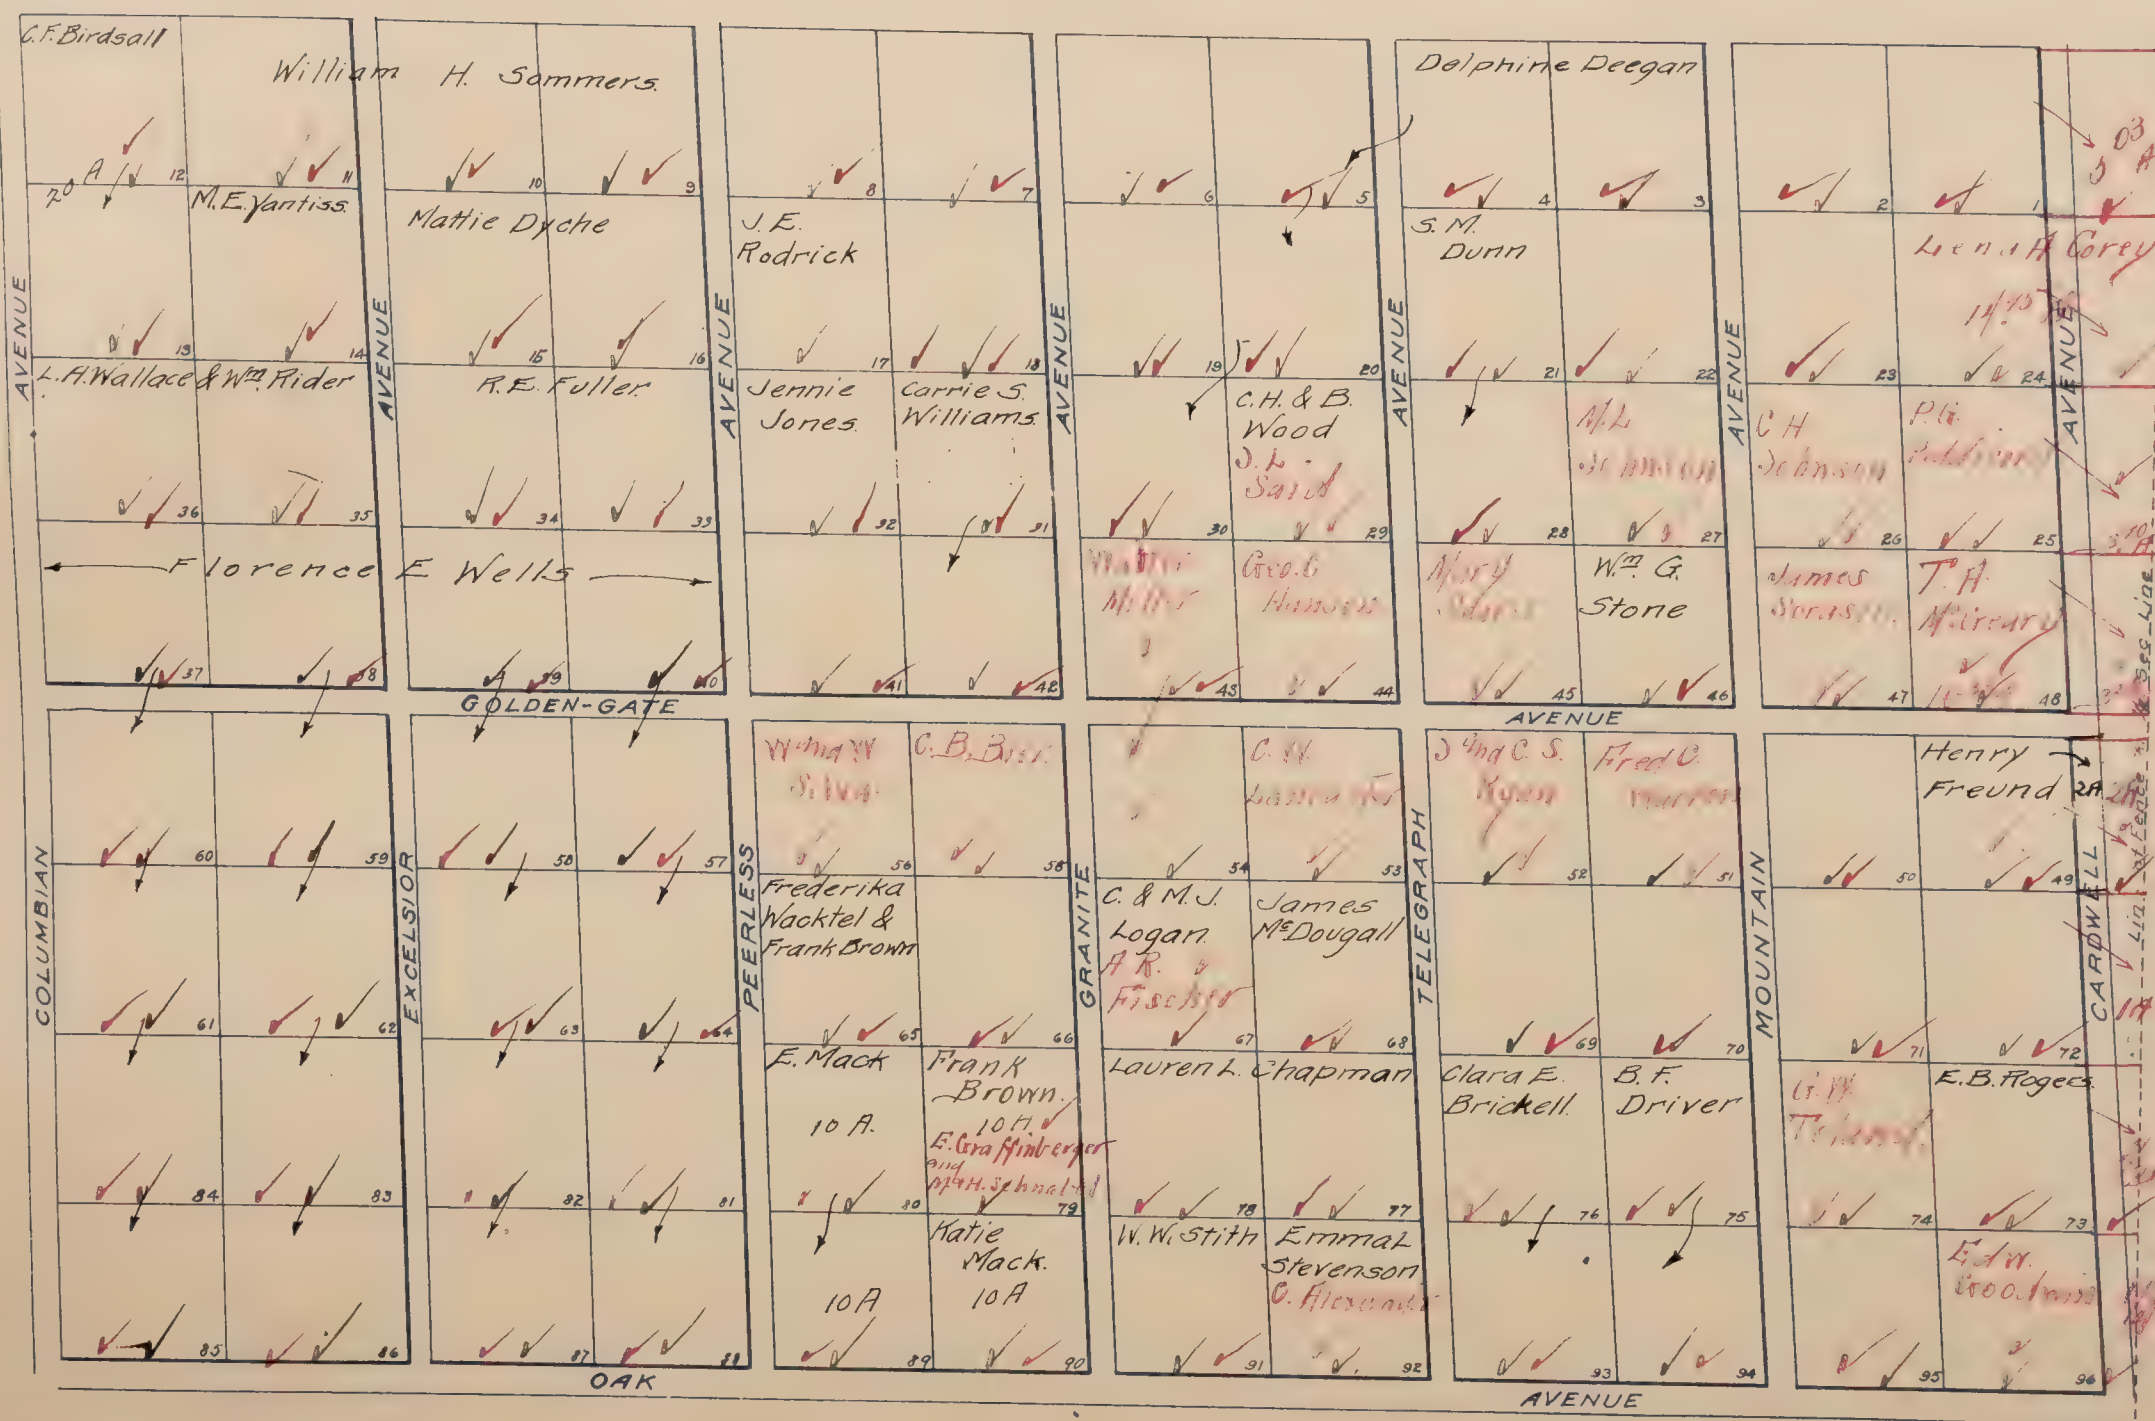


Black Ink-1919 Ownership
Red Ink-1920 Ownership
CARLETON

LOCATED IN THE
N. 1/2 of Sec. 24, T. 8 N., R. 5 E.
Scale: 100' = 1"

Sheet No. 1.

Blanks assessed to Hickman Inv. Co.

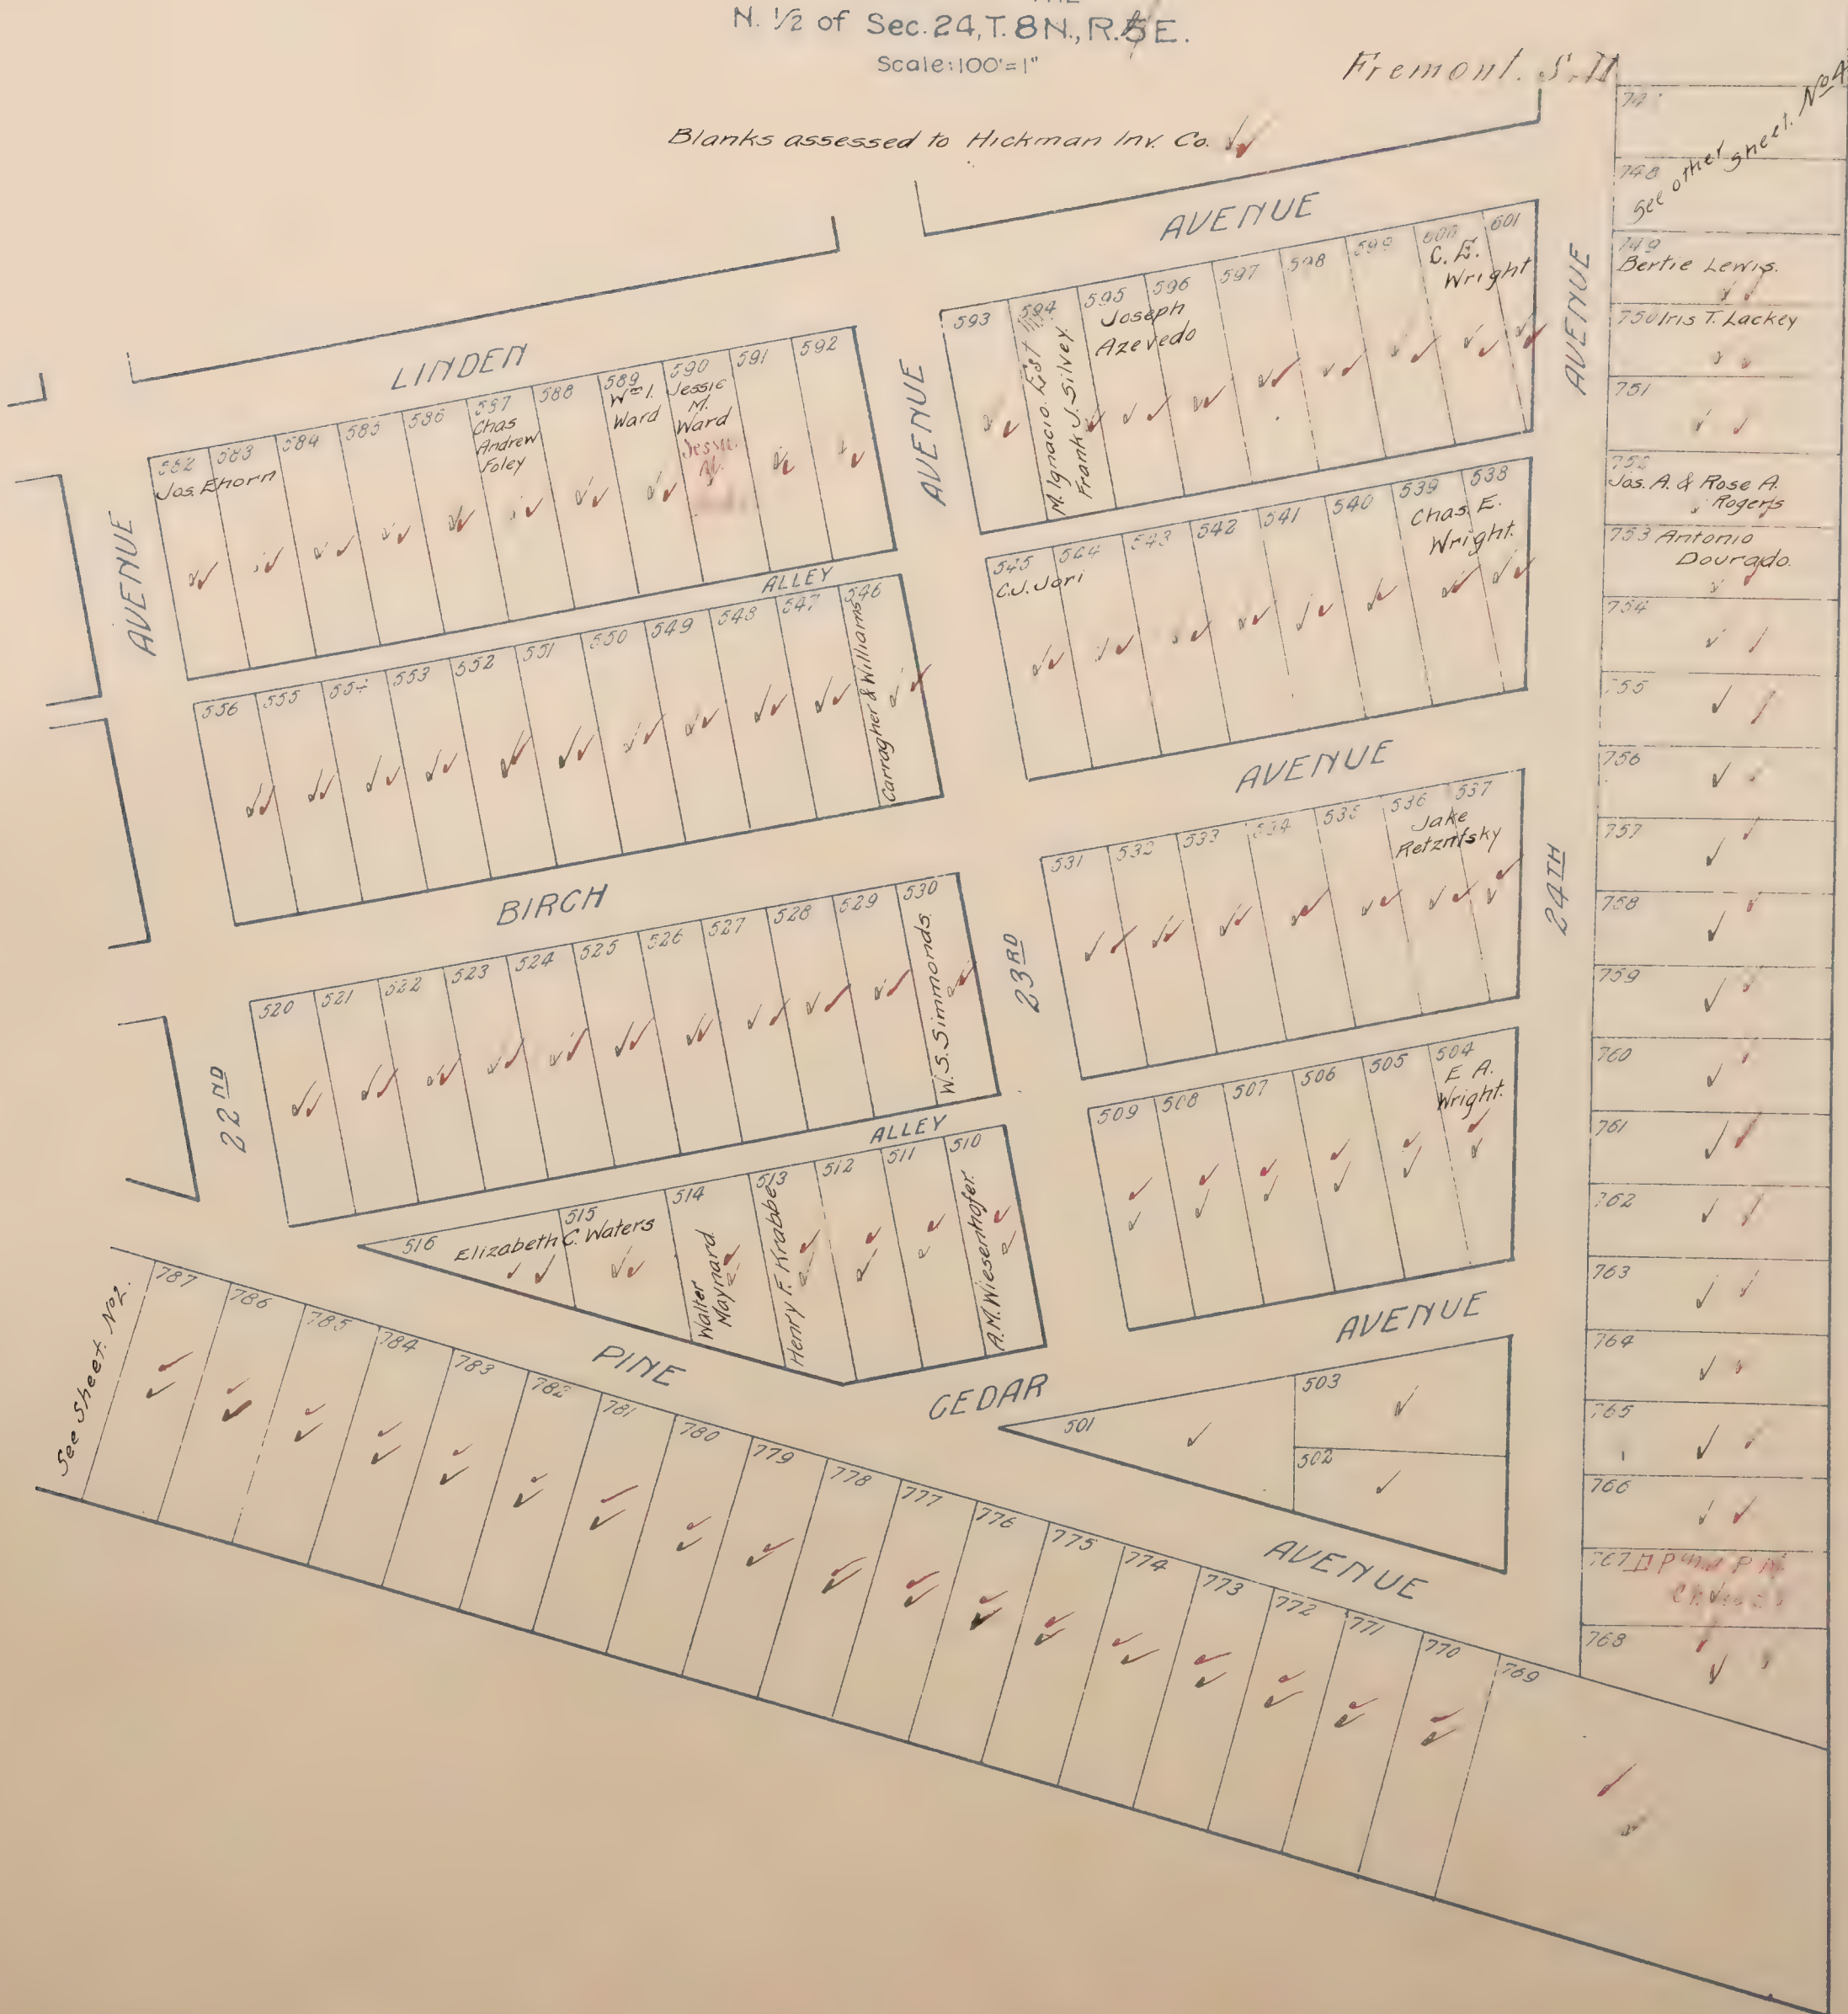


Black Ink-1919 Ownership
Red Ink-1920 Ownership

CARLETON
LOCATED IN THE
N. 1/2 of Sec. 24, T. 8 N., R. 5 E.
Scale: 100' = 1"

Sheet No 2

Blanks assessed to Hickman Inv. Co. ✓

Freemont, S.D.

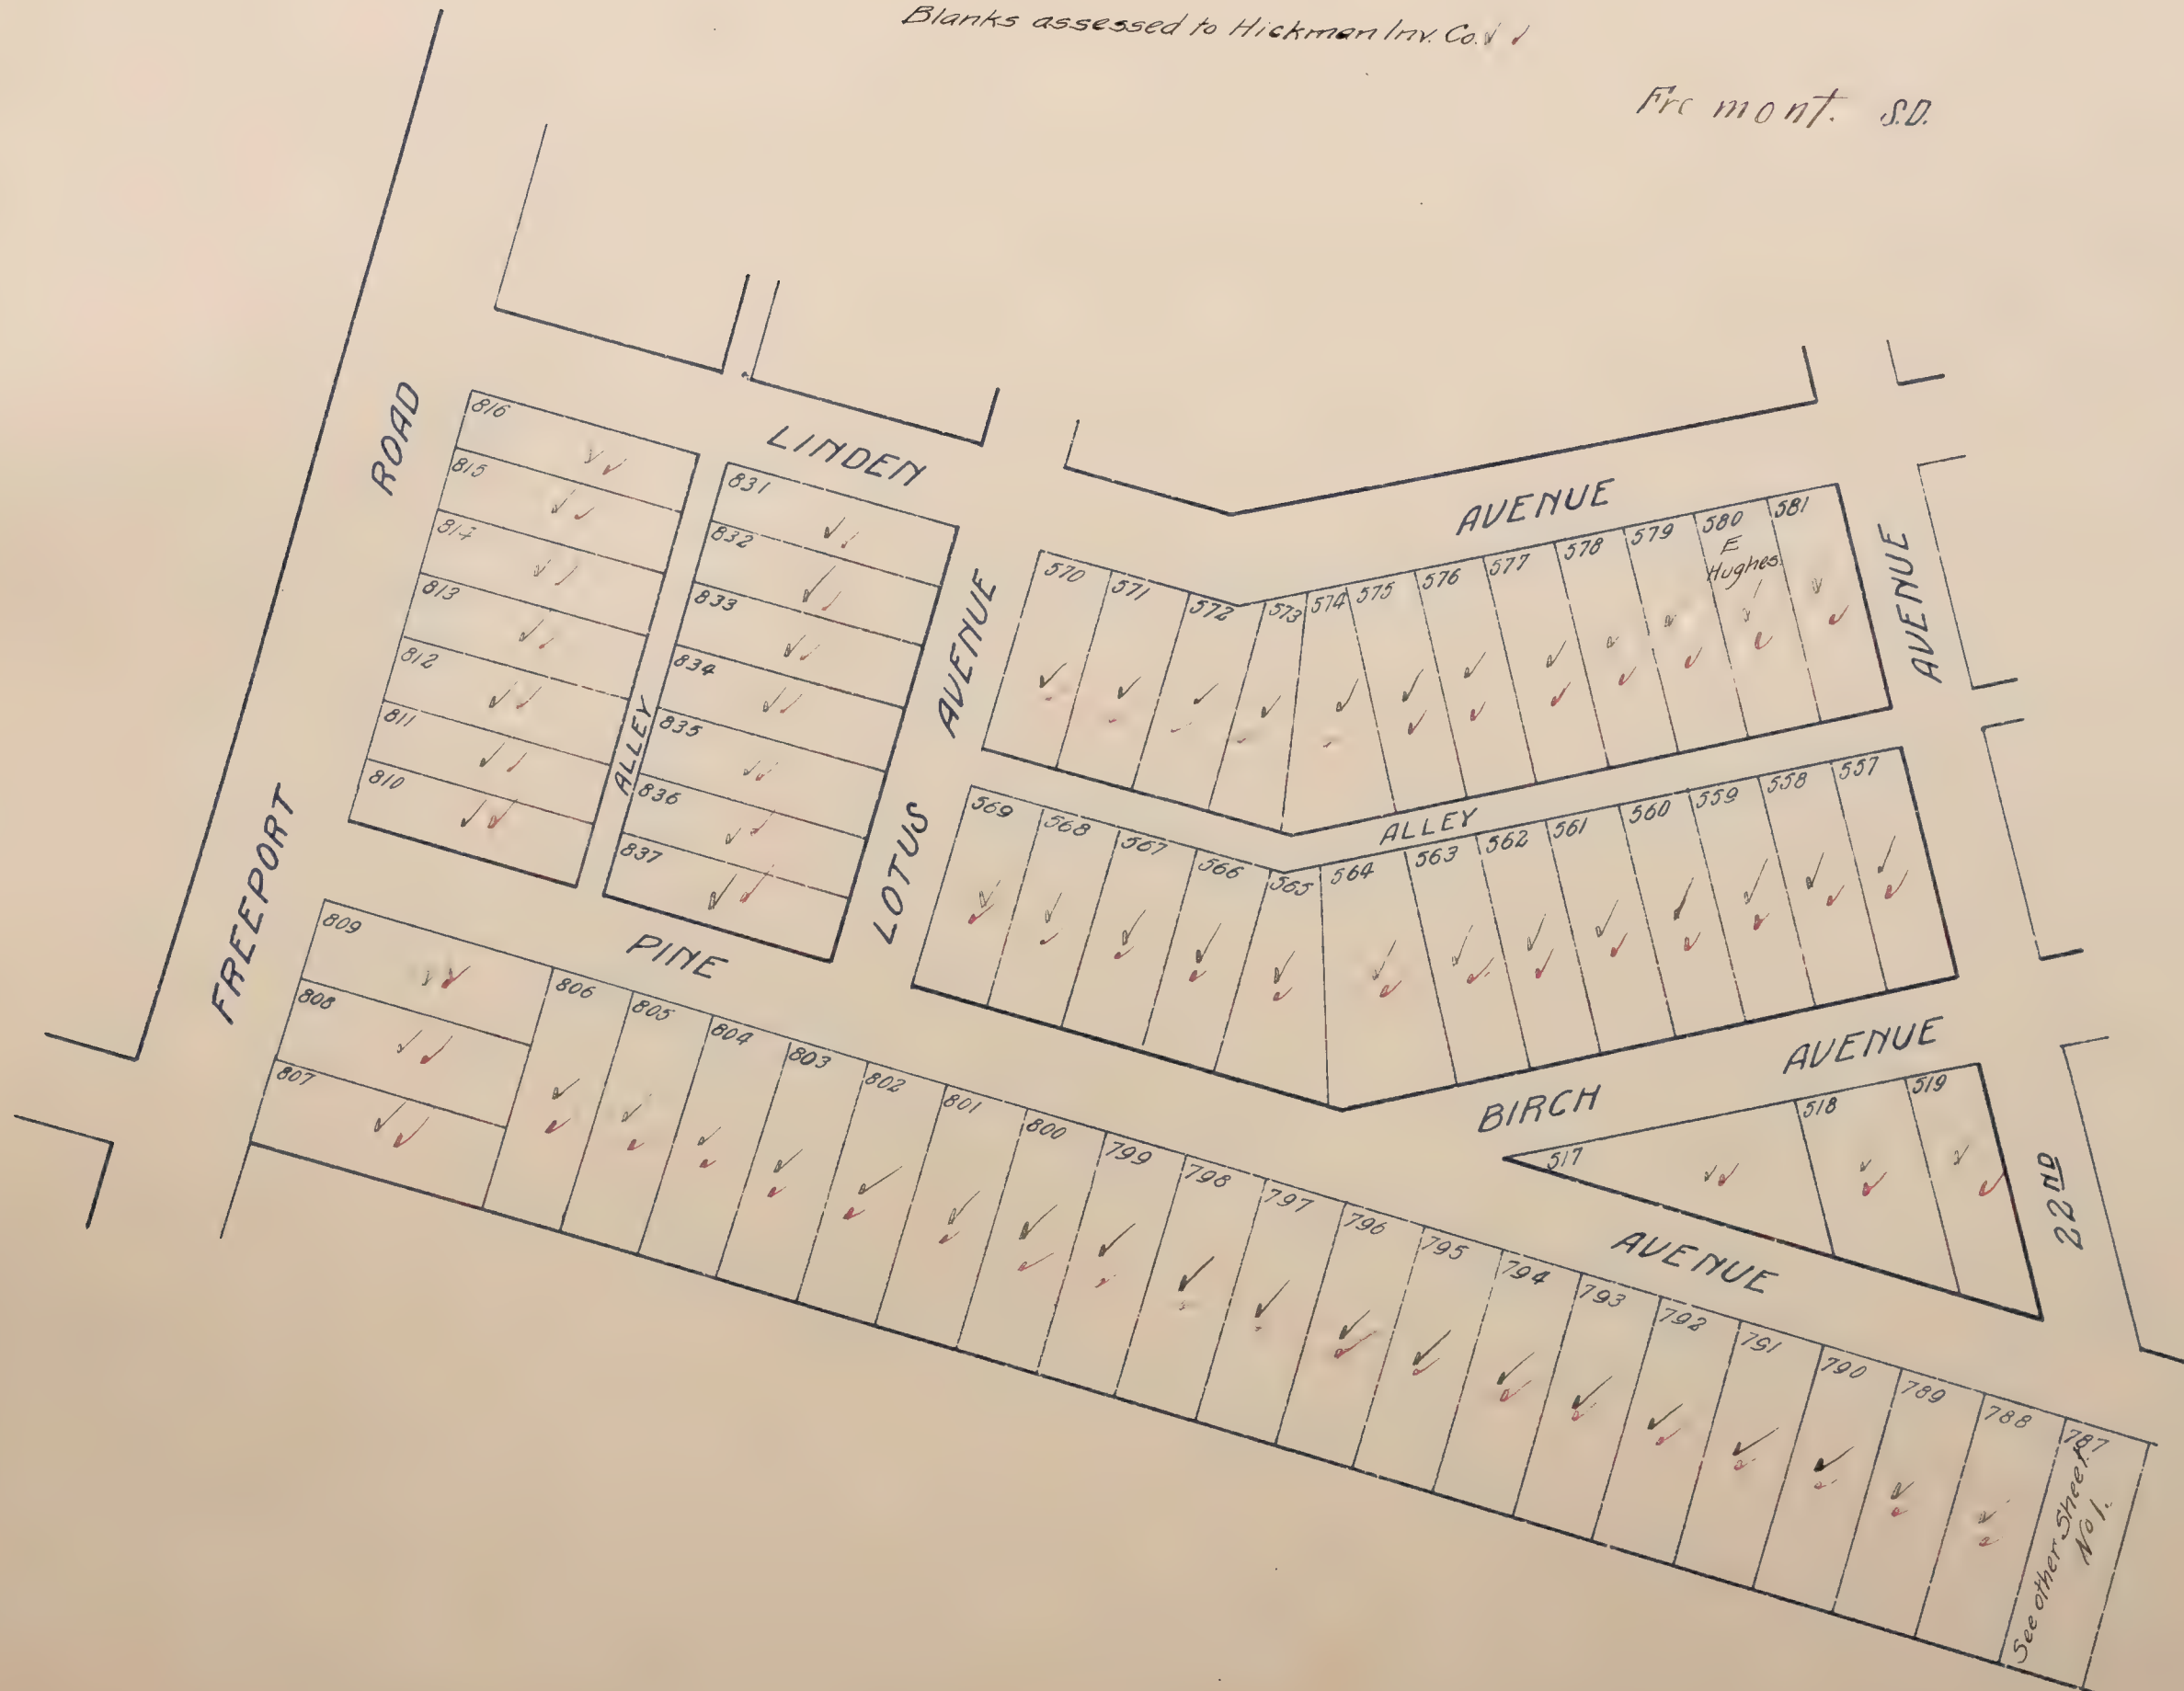

Mapped.

Black Ink-1919 Ownership
Red Ink-1920 Ownership

CARLETON

LOCATED IN THE
N. 1/2 of Sec. 24, T. 8 N., R. 5 E.
Scale: 100' = 1"

Sheet No 3.

Blanks assessed to Hickman Inv. Co. ✓✓

Fremont, S.D.



Mapped.

Black Ink-1919 Ownership
Red Ink-1920 Ownership


CARLETON

LOCATED IN THE
N. 1/2 of Sec. 24, T. 8 N., R. 5 E.
Scale: 100' = 1"

Sheet No 4.

Freemont S.D.


Blanks assessed to Hickman Inv Co. ✓✓

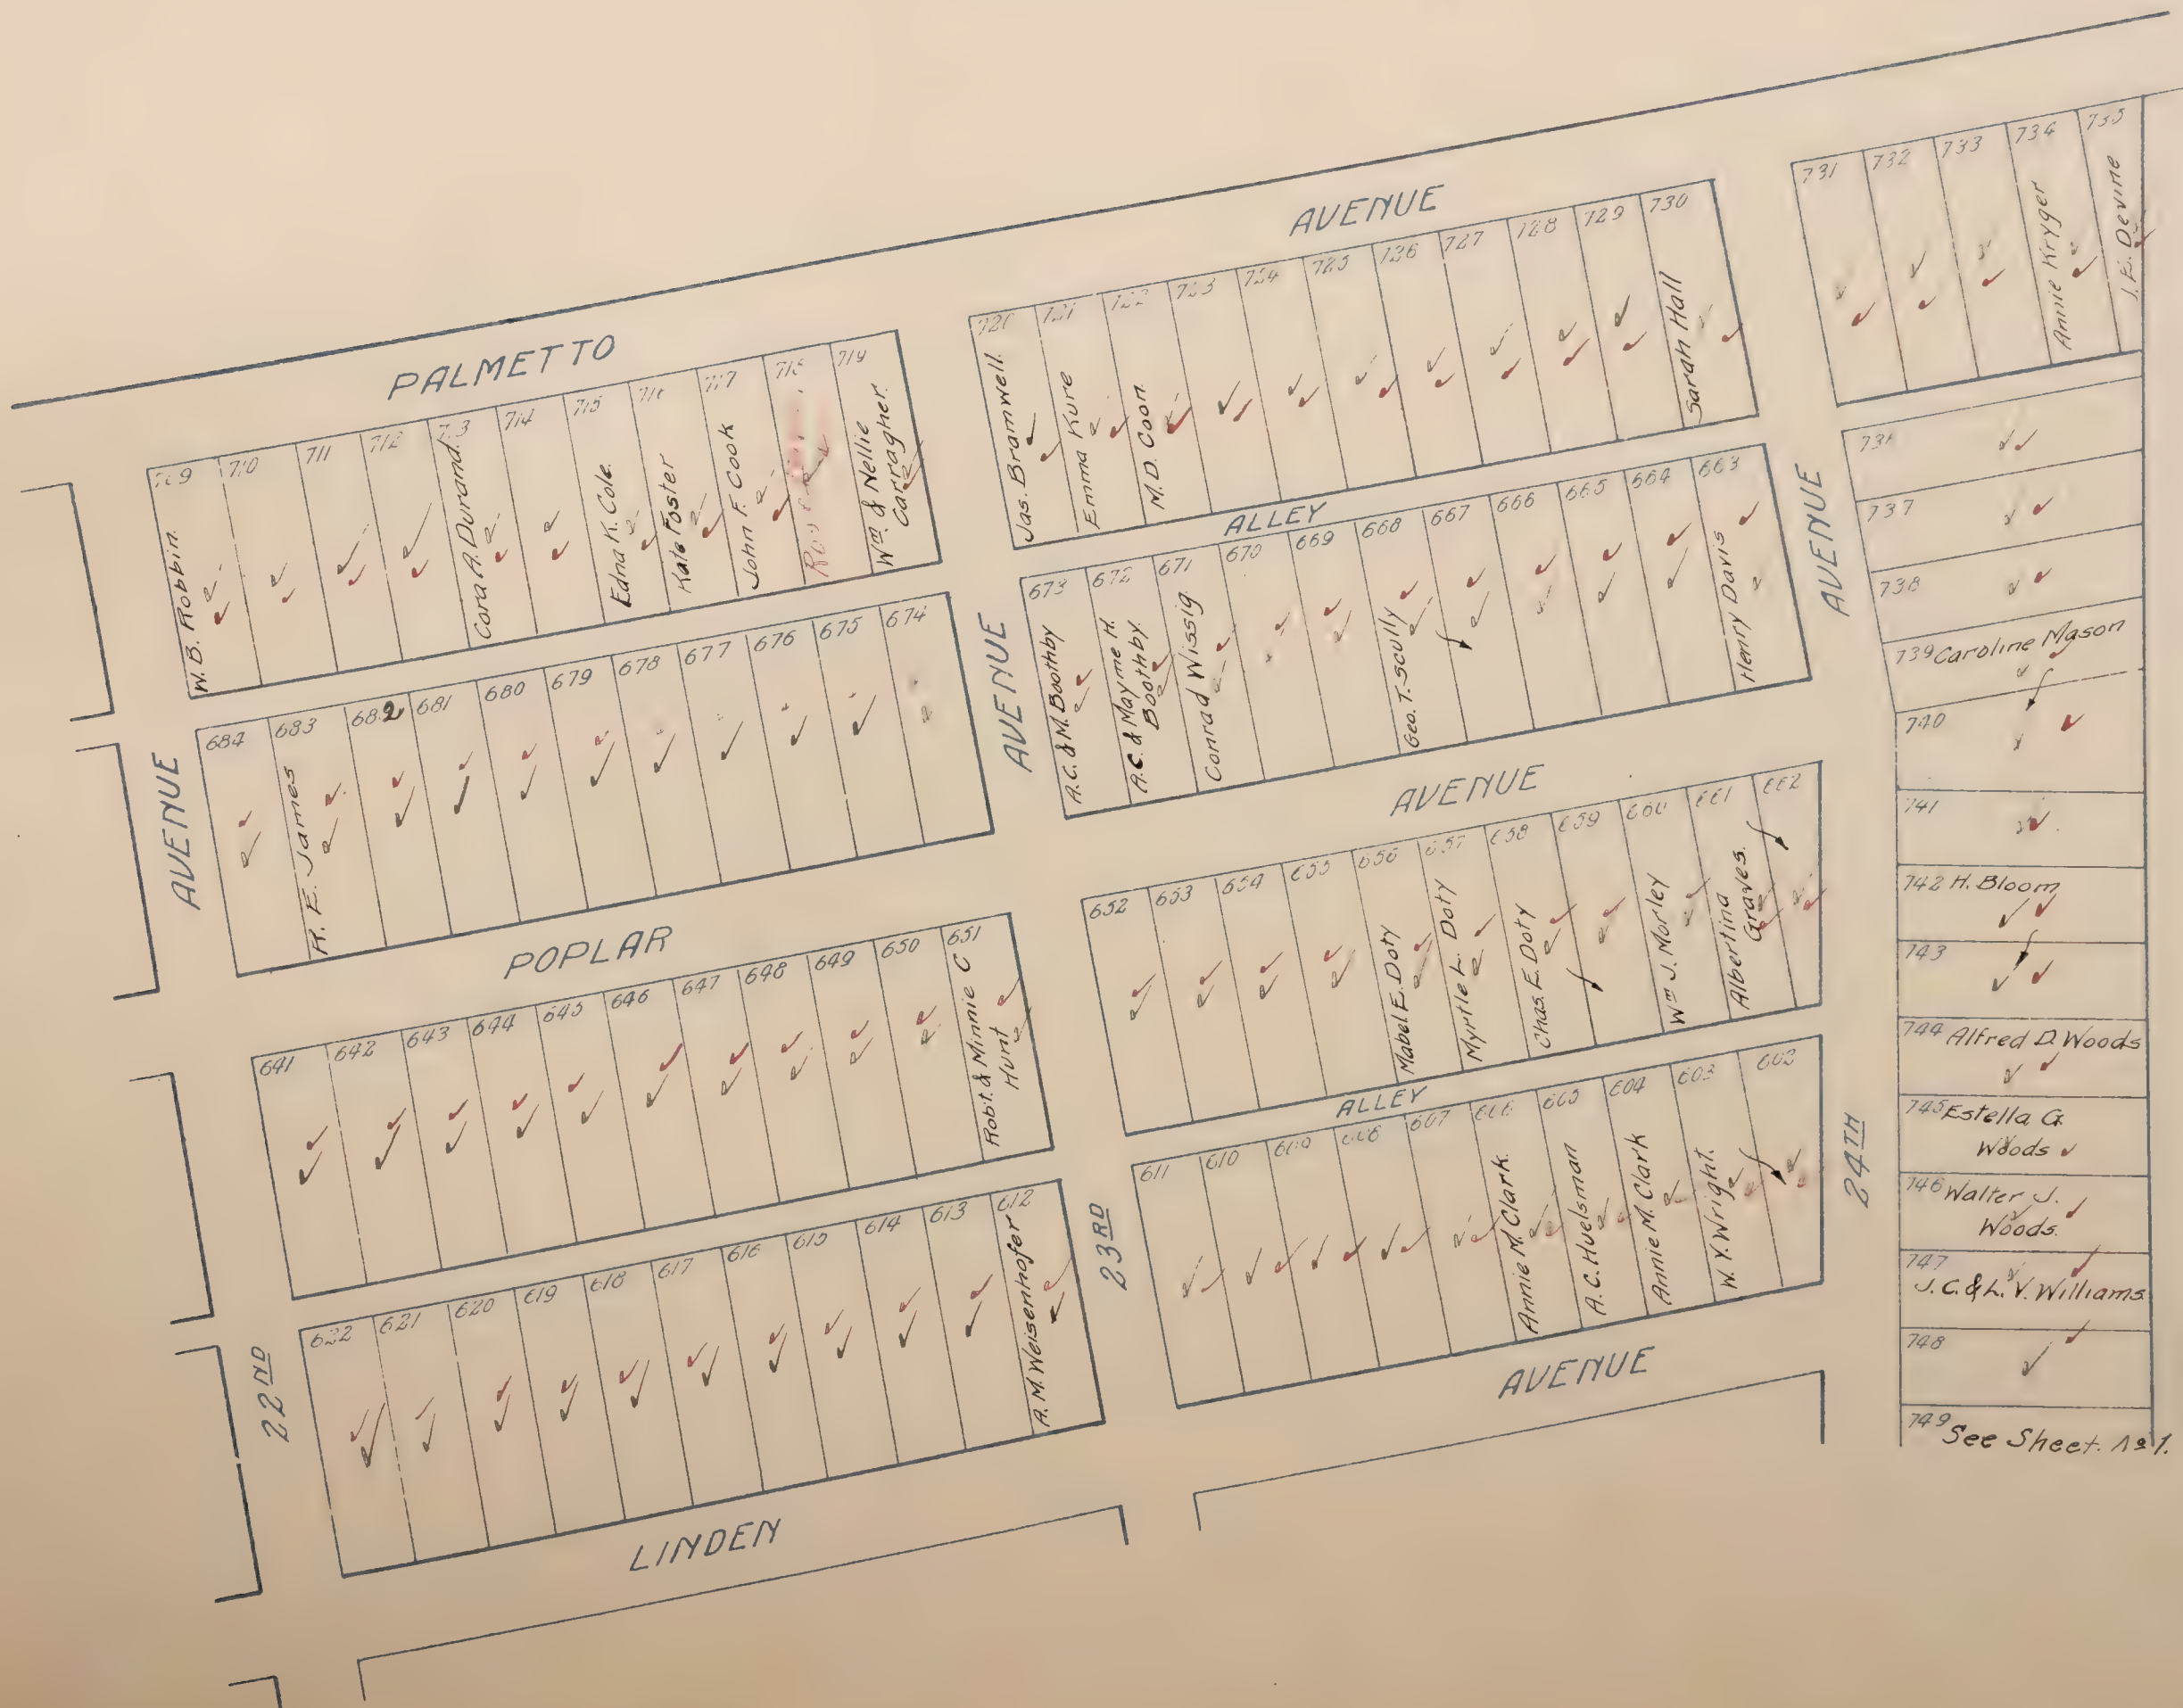

MADRID.

Carmichael
~~San Diego E.D.~~

Black Ink-1919 Ownership
Red Ink-1920 Ownership

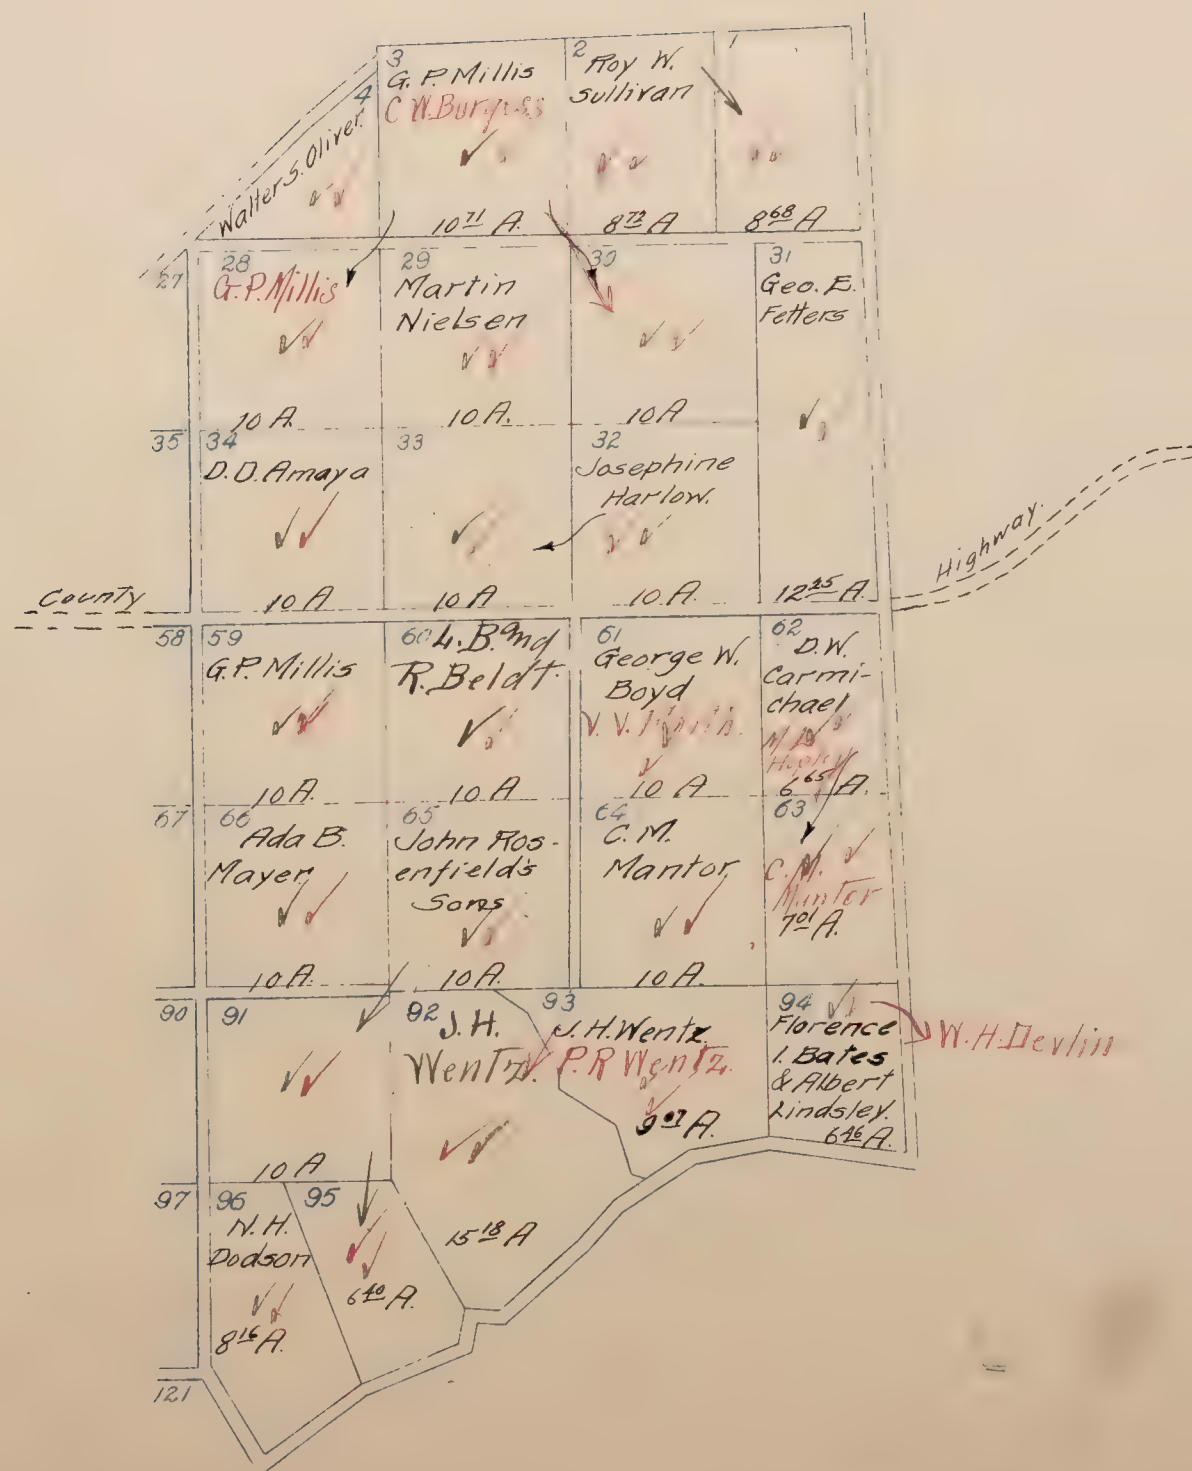


CARMICHAEL

CARMICHAEL COLONY

LOCATED 11'
San Juan Grant
Scale 600' = 1"

Black Ink-1919 Ownership
Red Ink-1920 Ownership

Blanks to John Rosenfields Sons ✓
All Lots 10 Acres unless otherwise noted

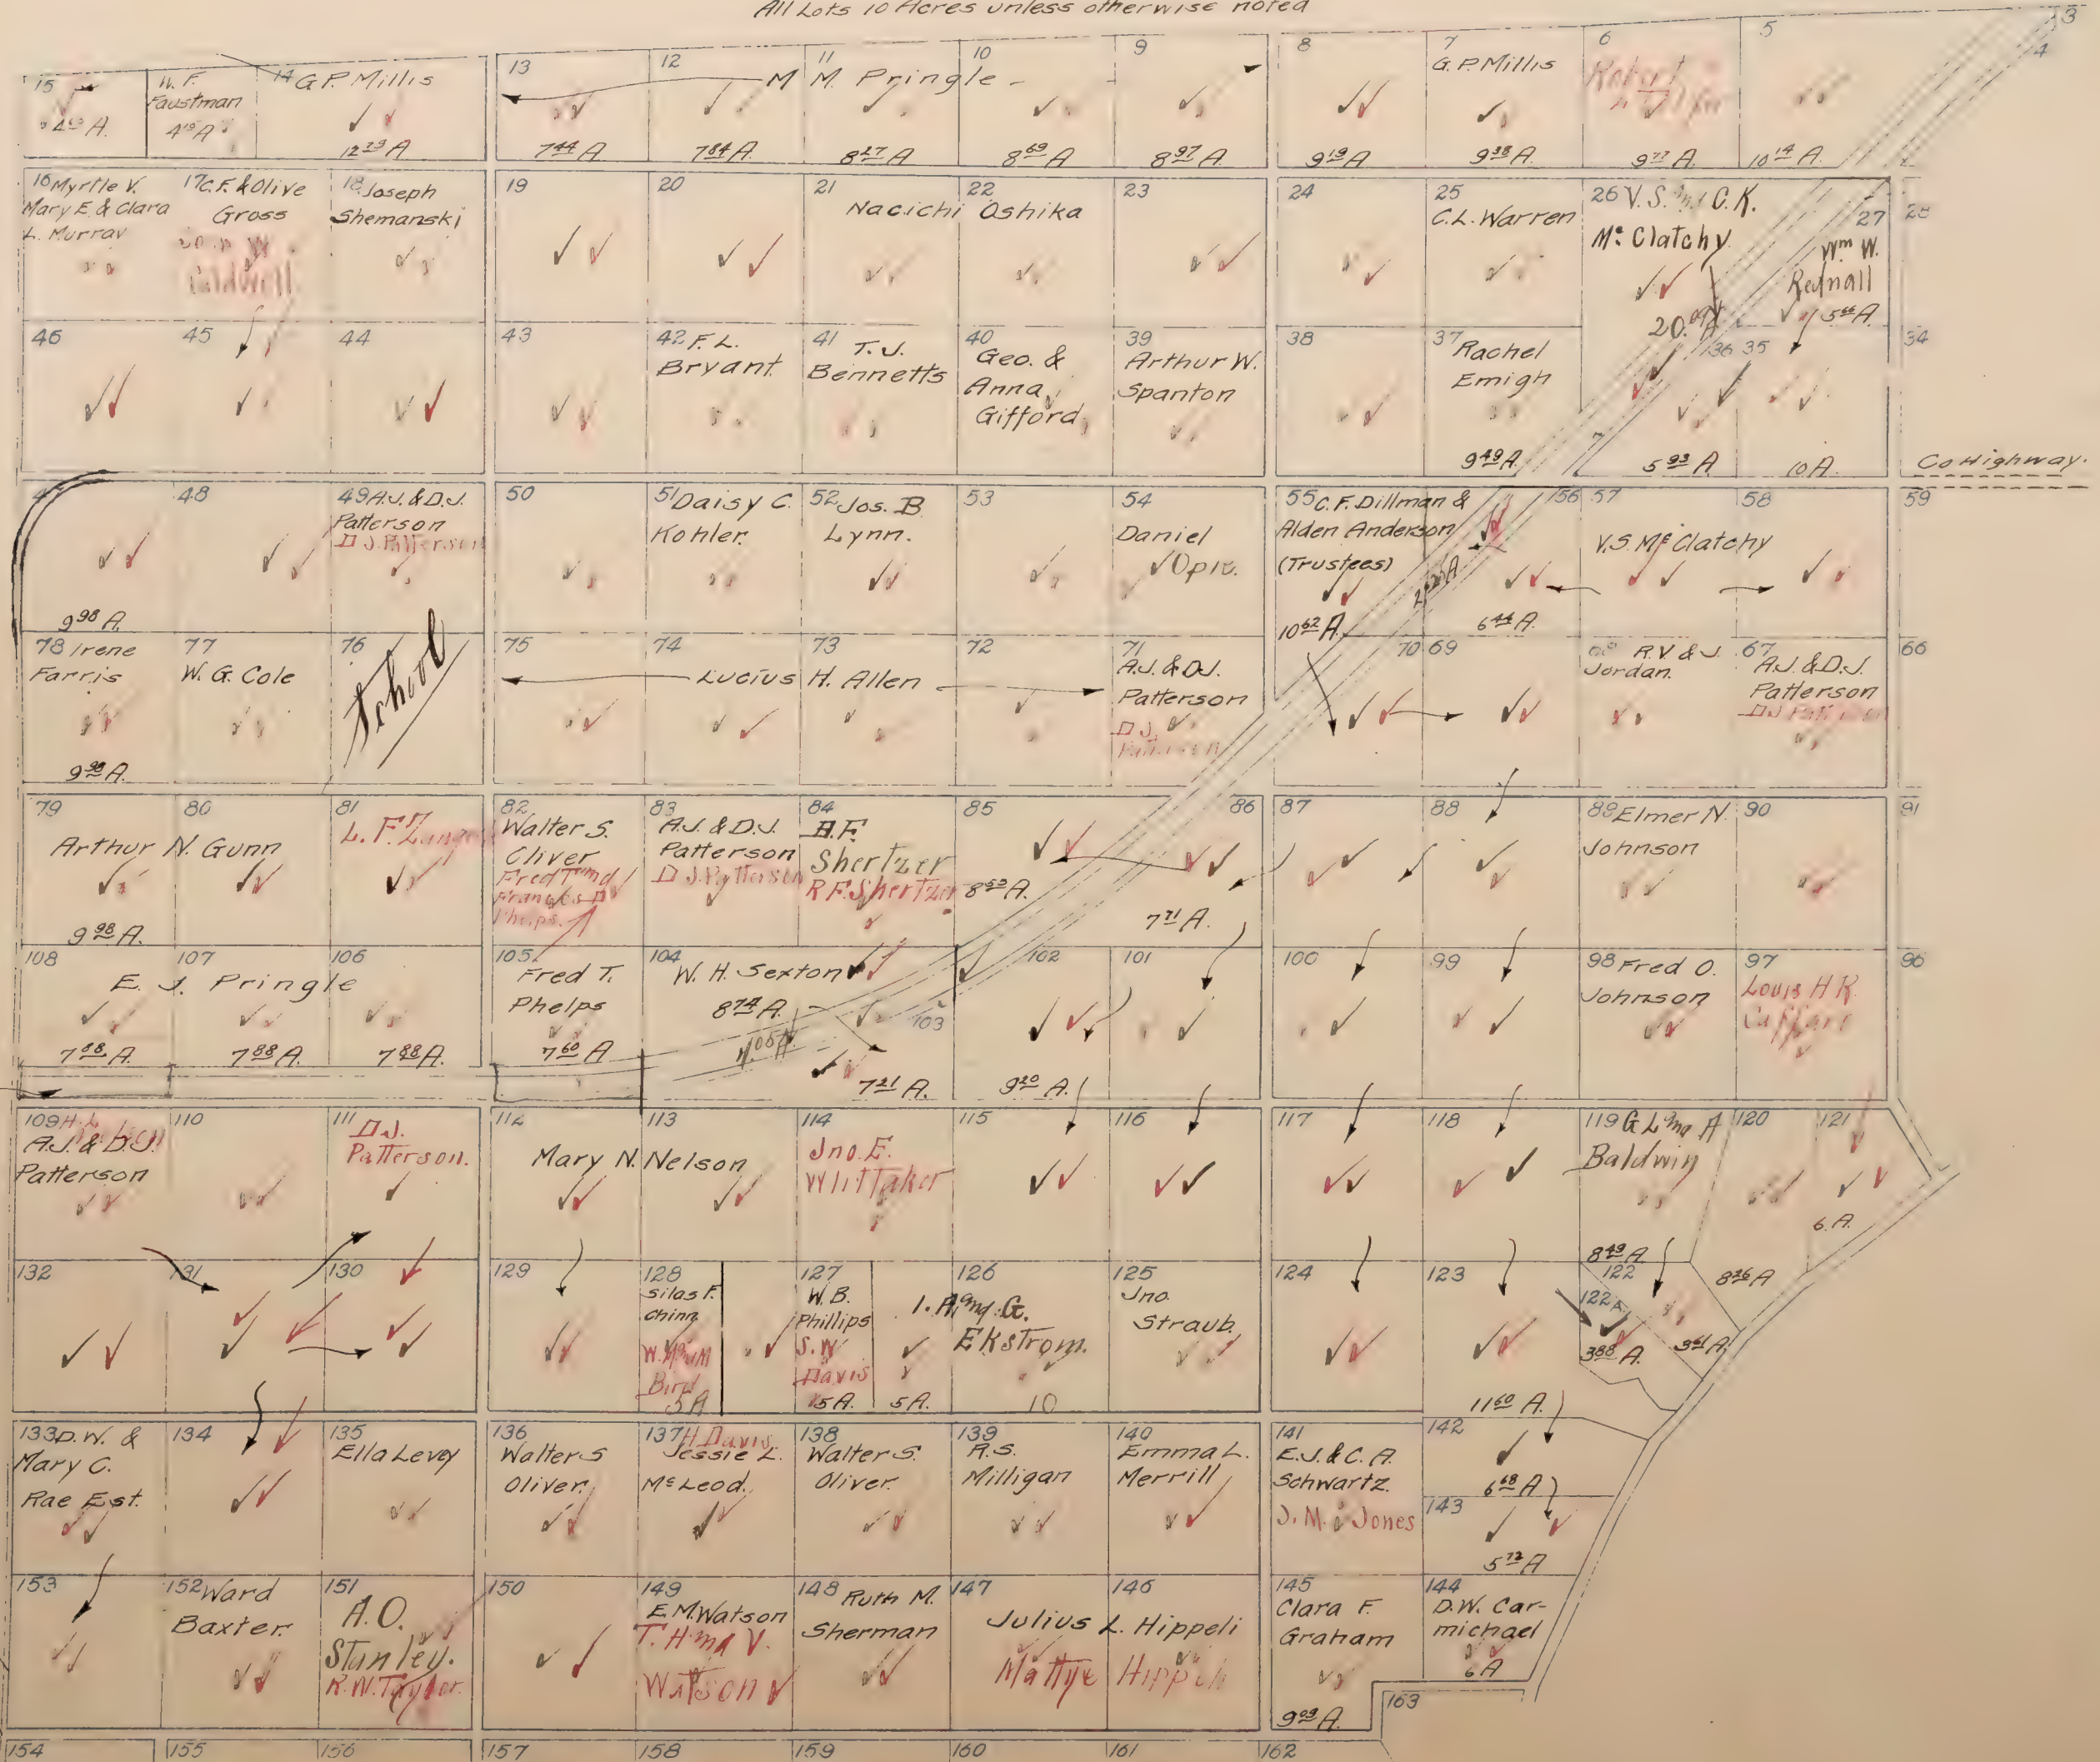

D.W. Carmichael - Strip of land reserved for Sacto & Sierra Ry. running thru Carmichael Col. 23.95 A.


County Highway

Co Highway

CARMICHAEL COLONY

LOCATED IN
San Juan Grant
Ink-1919 Ownership
Ink-1920 Ownership

Blanks to John Rosenfields Co. ✓
All Lots 10 Acres unless otherwise noted.

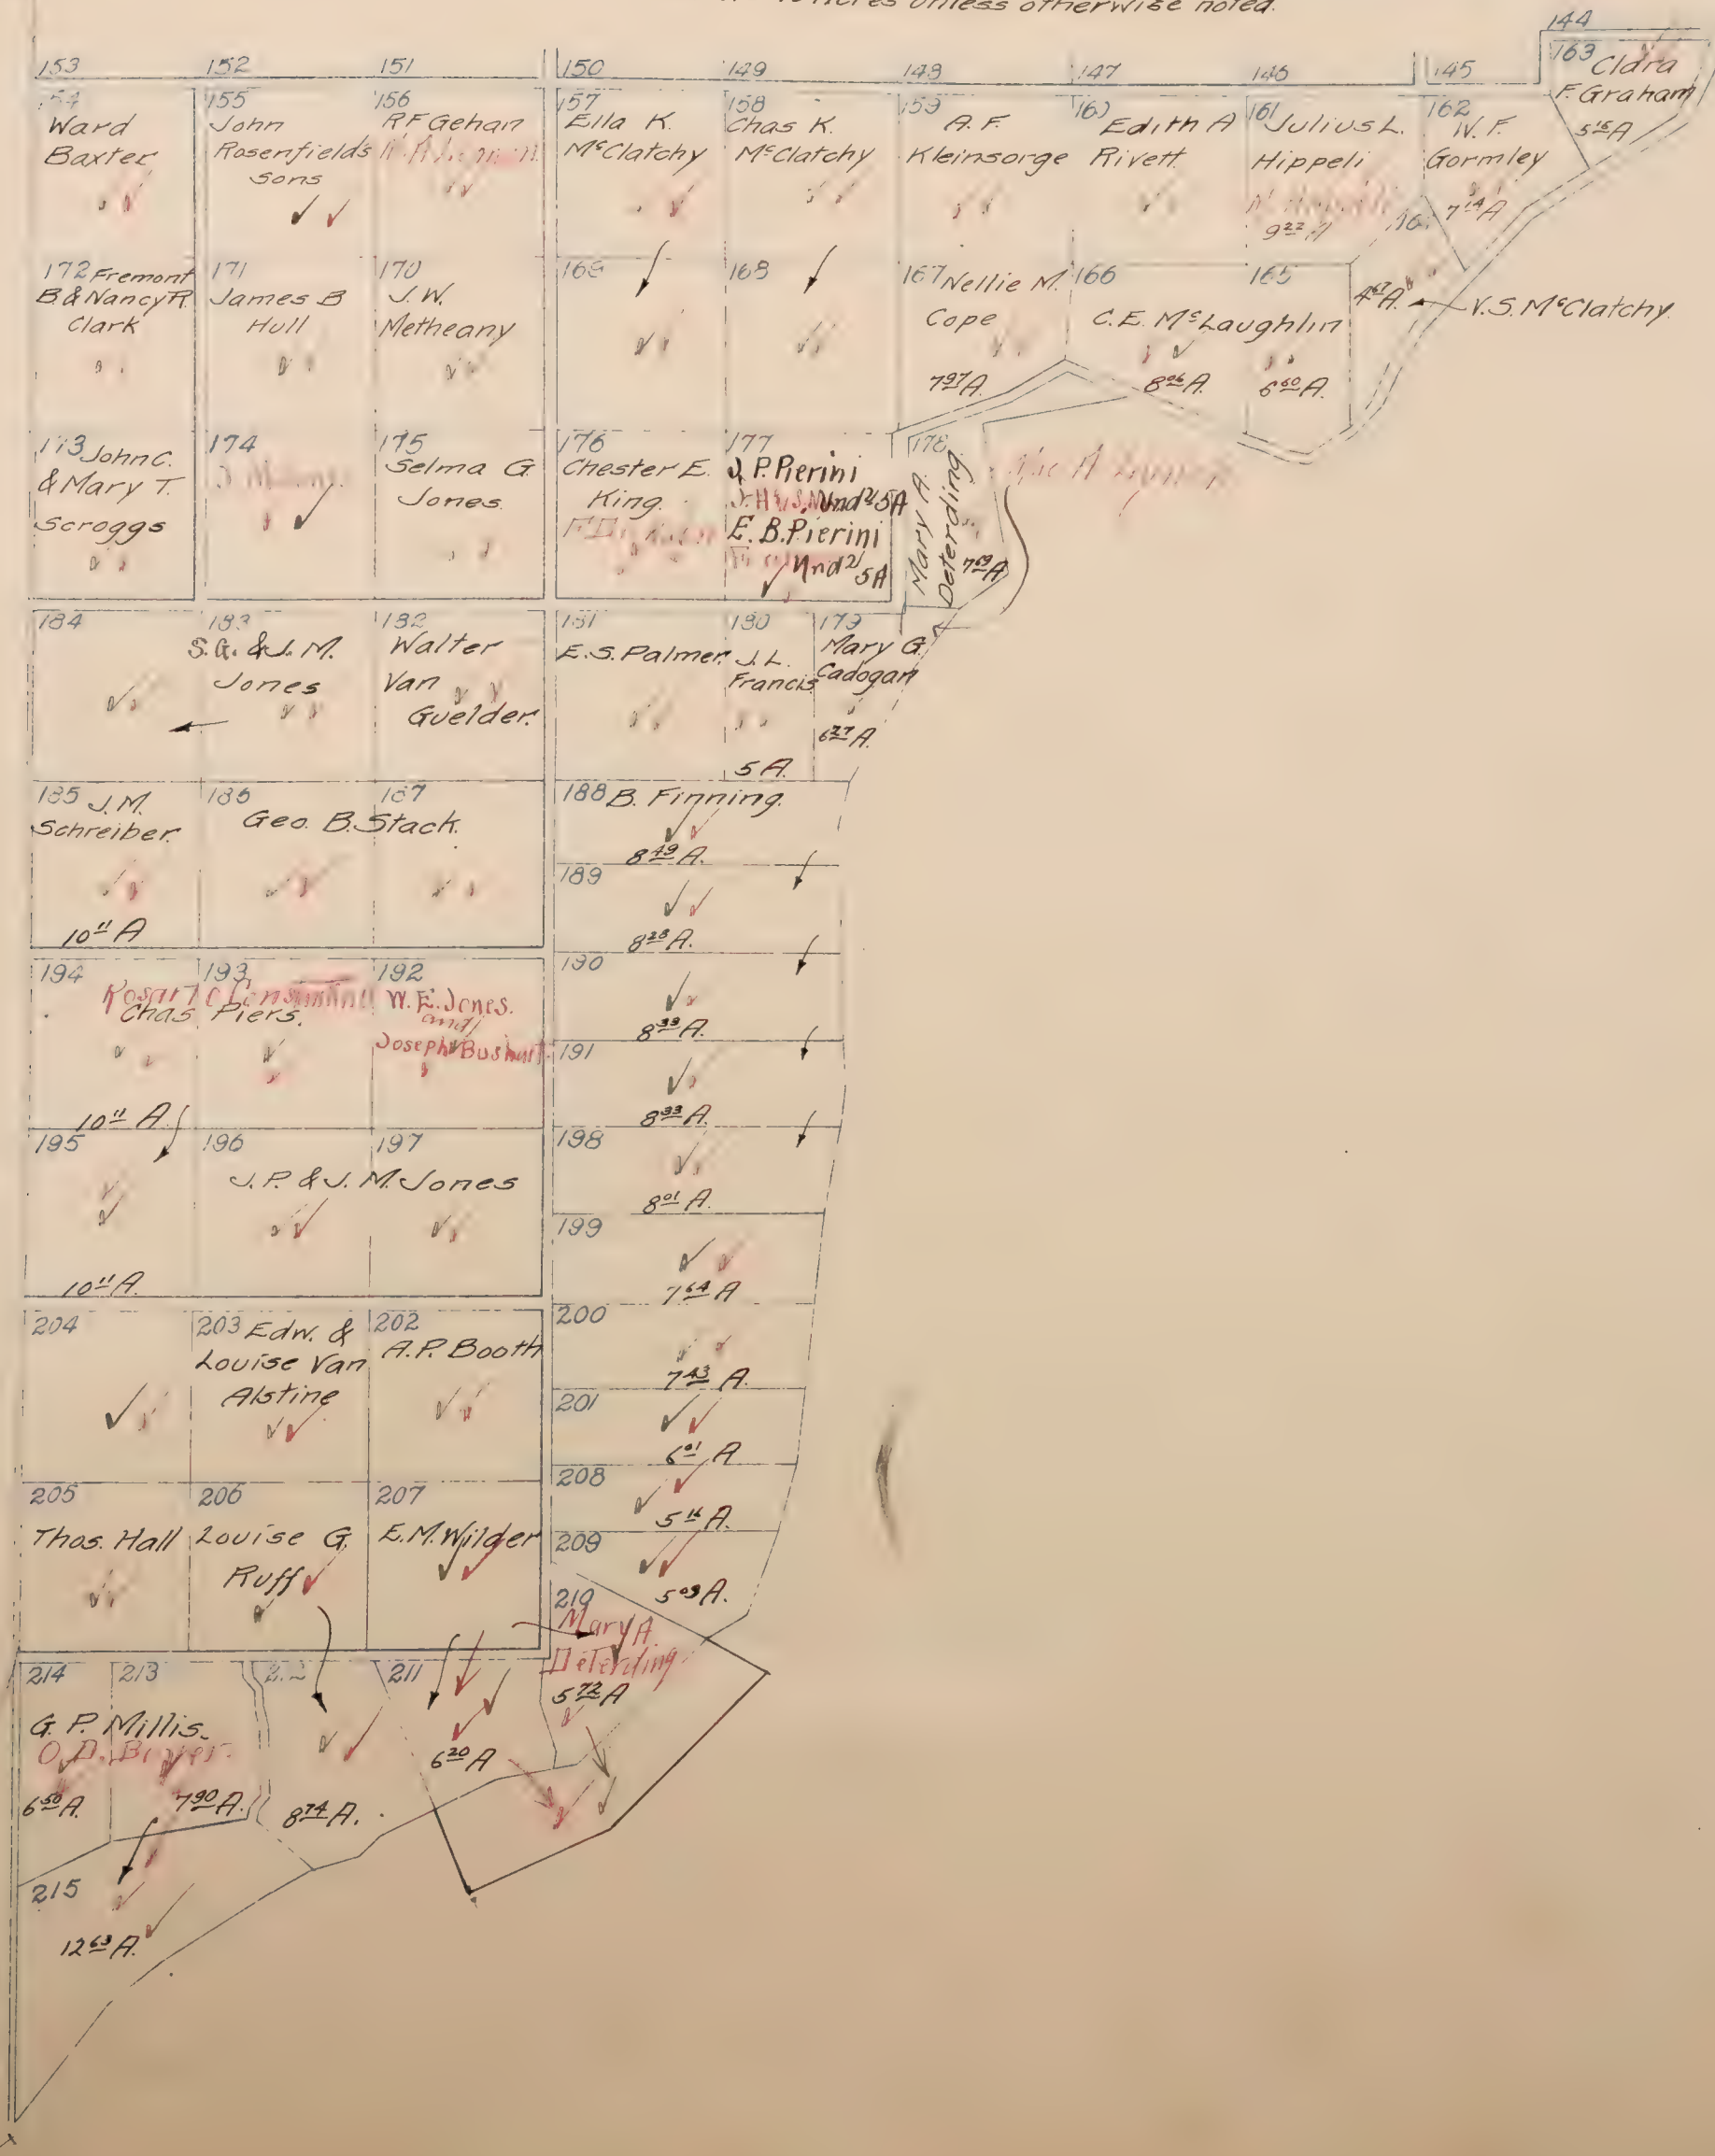

Black Ink-1919 Ownership
Red Ink-1920 Ownership

CARMICHAEL COLONY NO. 2

located in

Sec's 55 & 56 Rancho Del Paso

Scale: 1" = 600 feet

Carmichael
Secs 55 & 56

Charles W. Burgess
Blanks to D.W. Carmichael & Henry Mitau. ✓
All lots 10 Acres unless otherwise noted.

Archie McDonnell

1 ✓✓	2 ✓✓	3 ✓✓	4 ✓✓	5 ✓✓	6 ✓✓✓	7 ✓✓ 10 ²¹ A.
15 ✓✓	14 ✓✓	13 ✓✓	12 ✓✓	11 ✓✓	10 ✓✓	8 Lottie L. Thompson 10 ²¹ A.
						9 ✓✓ 10 ²⁰ A.
16 Christine Slangerup ✓✓	17 ✓✓	18 ✓✓	19 ✓✓	20 H. Long A. F. Long ✓✓	21 Nelson H. L. ✓✓	22 ✓✓ 10 ²⁰ A.
30 -	29 Under F.W. Richards Under A.I. Richards ✓✓	28 W. V. Cowan ✓✓	27 ✓✓	26 B. E. Smith ✓✓	25 B. Graves ✓✓	23 ✓✓ 10 ²⁰ A.
						24 Mabel C. Warren ✓✓ 10 ²⁰ A.
31 ✓✓	32 ✓✓	33 ✓✓	34 ✓✓	35 Joe Gedeon ✓✓	36 ✓✓	37 S. F. Sears ✓✓ 10 ²⁰ A.
45 ✓✓	44 ✓✓	43 ✓✓	42 ✓✓	41 ✓✓	40 P. A. Riebe ✓✓	38 B. E. Smith B. Graves ✓✓ 10 ¹⁹ A.
						39 ✓✓ 10 ¹⁹ A.
46 ✓✓	47 ✓✓	48 ✓✓	49 ✓✓	50 Fred R. Becker ✓✓	51 ✓✓	52 ✓✓ 9 ²⁰ A.
60 ✓✓	59 ✓✓	58 ✓✓	57 ✓✓	56 Olga Bowman A.C. Dittrock ✓✓	55 Geo. F. Meyer ✓✓	53 M. L. Sears ✓✓ 9 ²⁰ A.
10 ⁴⁵ A.	10 ⁴⁵ A.	10 ⁴⁴ A.	10 ⁴⁴ A.	10 ⁴⁴ A.	10 ⁴⁴ A.	54 A. F. Mumm ✓✓ 10 ⁴⁹ A.
61	62	63	64	65	66	67

CARMICHAEL COLONY NO. 1

Mapped.

Black Ink-1919 Ownership
Red Ink-1920 Ownership

CARMICHAEL COLONY NO. 2

located in

Sec's 55 & 56 Rancho D. Paso


Scale: 1" = 600 feet

*Carmichael &
San Juan S.D.*

Charles W. Burgin

Blanks to D.W. Carmichael & Henry Mitau.

All lots 10 Acres unless otherwise noted

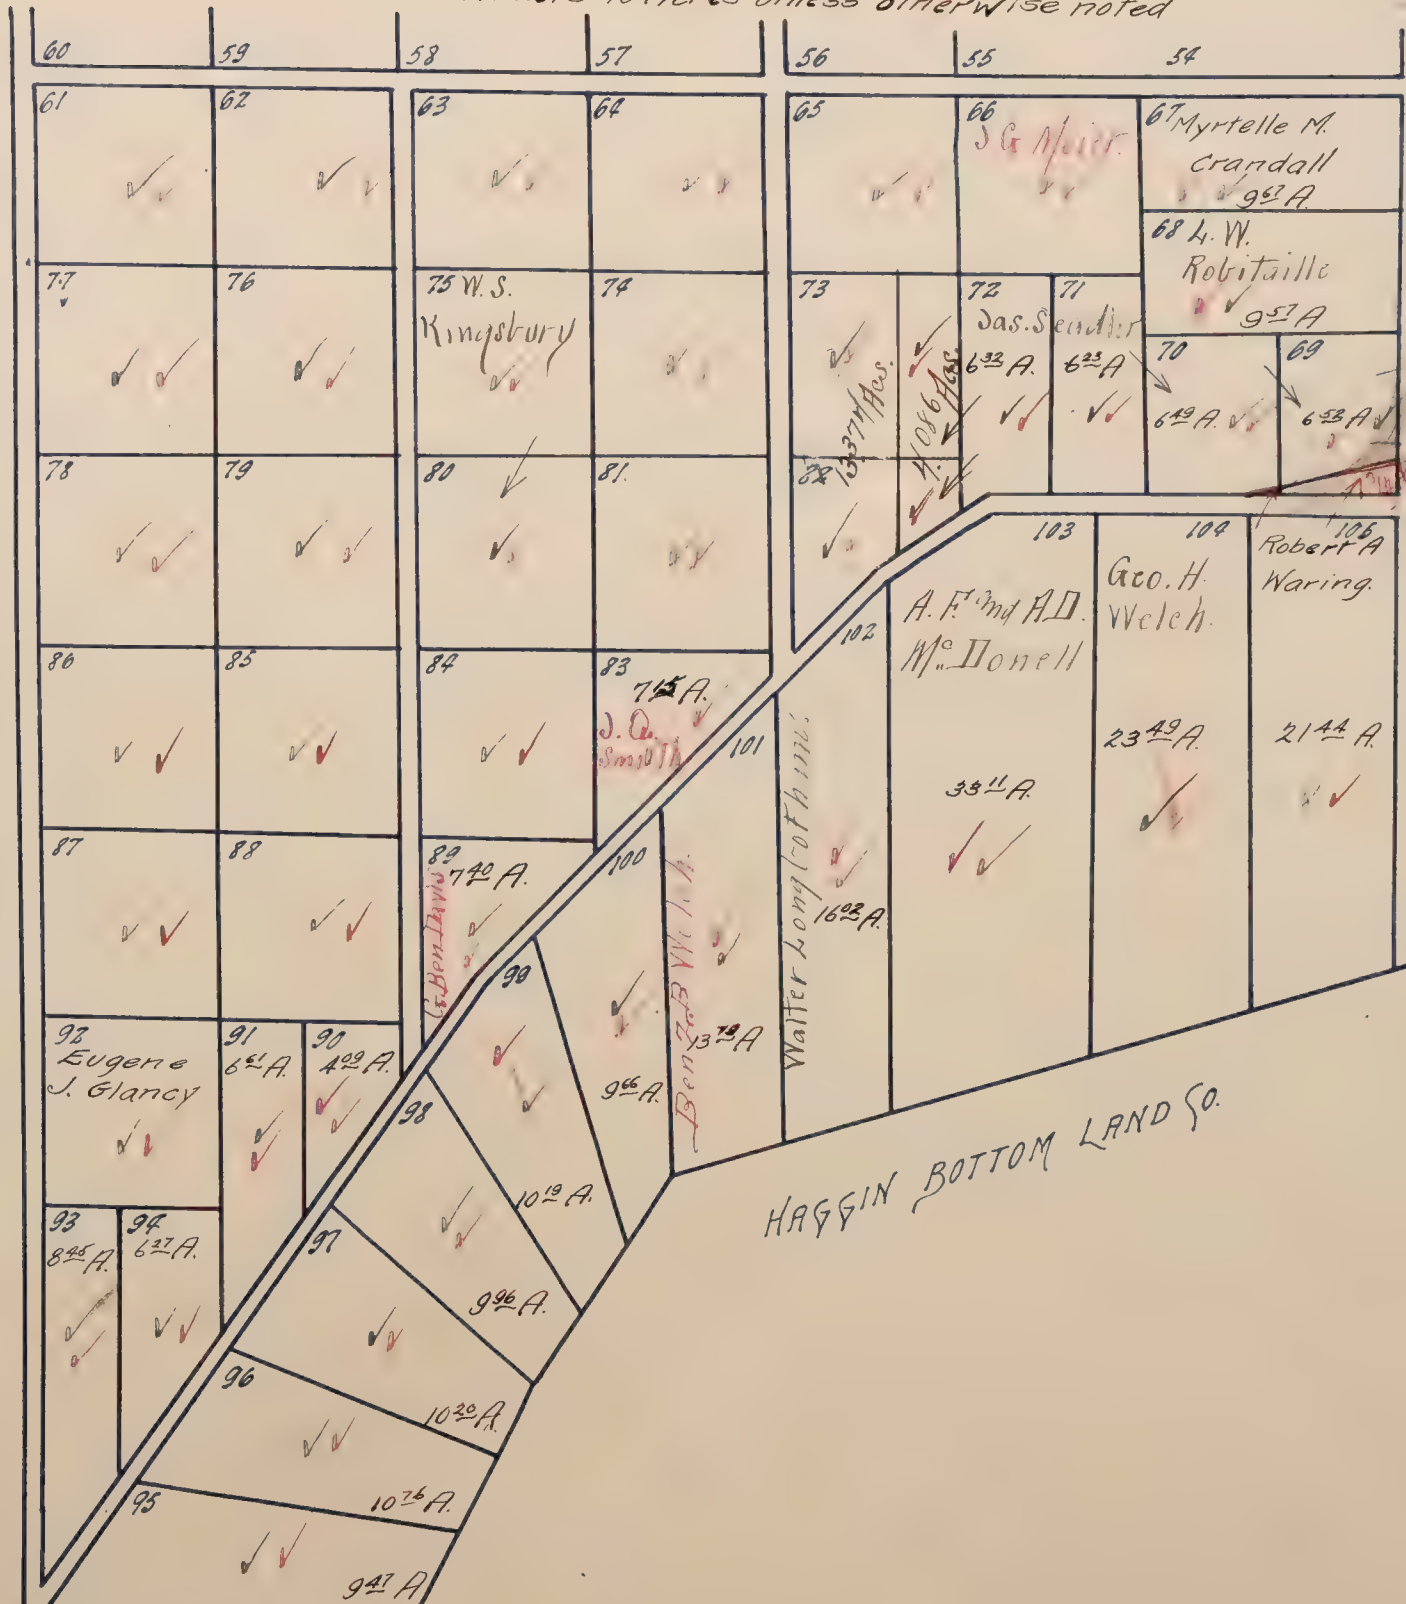

Black Ink-1919 Ownership
Red Ink-1920 Ownership

CEDARHURST

OR
H.J.GOETHE CO'S. SUBD. N° 91
LOCATED IN THE
N.W.¼ of Sec.23, T.8N., R.5E.
Scale: 3 Chs.=1"

COUNTY ROAD	9101 Anna Roseman	9103 Joseph C. Sanderson	9104 Mary Sanderson	9105 J. H. Briggs	9106 Chas. H. Lyons	9107 Washington S.H.	9108 Mary L. Lyons
	9102 W.L. Ford & Roy L. Brooke						

Mapped.

Black Ink-1919 Ownership
Red Ink-1920 Ownership

CENTRAL CALIFORNIA TRACTION COLONY NO.1.

LOCATED IN

Sections 17, 19, 20, T.5 N. R. 7 E.

Scale: 600 ft. = 1 inch.

Blanks to Herald Realty Co. ✓✓

All lots 10 Acres unless otherwise noted.

5 Brown

129	72 Frederick ✓✓ 5 ²² A.	71 W. Schmalzing ✓✓ 7 ²² A.	70 ✓ 16 ²² A.	69 ✓ 16 ²² A.	68 Delphine ✓ 8 ²² A.	67 Snyder ✓✓ 9 ²² A.	66 M. A. Shilkret. ✓ 9 ²² A.	65 ✓ 9 ²² A.
144	73 F. W. Dart ✓✓	74 ✓✓	75 Anna L. Willing ✓✓	76 R. C. Jones. ✓✓	77 Herbert Bull ✓✓	78 Margit. L. Douglas ✓✓	79 Joe Dancak J. and E. Stofka	80 ✓
145	82 ✓	87 John Neumeis- ter H. C. Taylor.	86 ✓	85 P. R. Fairbairn ✓✓	84 J. W. Keltner H. L. Taylor	83 ✓	82 ✓	81 ✓
160	89 ✓	90 ✓✓	91 ✓✓	92 ✓✓	93 ✓✓	94 ✓✓	95 Chas. A. & Mabel C. McGill. ✓✓	96 A. E. Ebey ✓✓
	104 John Neumeister H. C. Taylor	103 ✓✓	102 G. Roggia ✓✓	101 Gustave & Hazel Tanner	100 ✓✓	99 ✓	98 E. G. Spjuth ✓	97 Arved Spjuth ✓
	105 ✓✓	106 ✓	107 ✓✓	108 ✓✓	109 ✓✓	110 ✓✓	111 ✓	112 ✓
	120 M. F. McCollm ✓✓	119 Emil Klement. ✓✓	118 ✓	117 Fred Stirnkorb ✓✓	116 Herman Reichert. ✓✓	115 ✓	114 ✓	113 ✓
	121 J. W. McDonald ✓✓	122 Otto Klement ✓✓	123 Gary Bruckhach. ✓✓	124 R. L. Ebey C. A. Stenwall ✓✓	125 ✓✓	126 ✓✓	127 ✓✓	128 ✓✓
	10 ²⁵	6 ²⁰ A.	12 ²⁰ A.	11 ²⁰ A.	11 ²⁰ A.	11 A.	10 ²⁰ A.	10 ²⁰ A.

Black Ink-1919 Ownership
Red Ink-1920 Ownership

CENTRAL CALIFORNIA TRACTION COLONY NO.1.

LOCATED IN
Sections 17, 19, 20, T.5 N. R. 7 E.

Scale 600 ft = 1 inch.

Blanks to Herald Realty Co. ✓

All Lots 10 Acres unless otherwise noted

AR 631112

1 ✓	7 ✓	6 ✓	5 Martha & Mary Garmby ✓	4 ✓	3 E. Patrizia ✓	2 Spencer M. Smith ✓	1 ✓
8 ¹² A ✓	8 ¹⁵ A ✓ T. Ellison ✓	8 ¹⁶ A ✓	8 ¹⁸ A ✓ Charles Malic ✓	9A ✓ Geo. Overbeck ✓	9 ¹ A ✓	9 ¹¹ A ✓ O.O. ✓ Yarbrough & L.F. Denning ✓	7 ¹⁸ A ✓ E.J. ✓ Haynes ✓
8 ¹³ A ✓ Margaretta, Ernest A, Carl C. & Harold C. Bruntsch & Tasca Sales ✓	24 ✓ J.J. Teague ✓	25 ✓ W.H. ✓ Nettelmann ✓	20 ✓ A.H. Erickson ✓	19 ✓	18 ✓	17 ✓	16 ✓
8 ¹⁴ A ✓ 25 ✓ E.A. Bruntsch ✓	26 ✓	27 ✓ Frank Lucas ✓	28 ✓	29 ✓	30 Emma Matheson ✓	31 ✓ Thos. Smith ✓ Smith ✓	32 ✓
8 ¹⁹ A ✓	40 ✓ C.E. Wilson ✓	39 ✓ F. Jasper ✓	37 ✓	36 ✓ F.J. Kaelber ✓	35 W.E. Tuft ✓	34 Edith M. Warner ✓	33 Emma L. Hiller ✓
8 ²⁰ A ✓ 41 Blake D. & Martha M. Myers ✓	42 Hannah M. Shaw ✓ 5A ✓	43 ✓ G.L. Smith ✓	44 ✓	45 ✓ S.M. Chambers ✓	46 ✓	47 ✓	48 ✓
8 ²¹ A ✓ 56 ✓ C.F. & Myrtle Correll ✓	55 ✓	54 ✓	53 ✓	52 ✓	51 ✓	50 ✓	49 ✓
8 ²⁶ A ✓ 57 ✓	58 ✓	59 ✓	60 ✓	61 ✓	62 ✓	63 ✓ C.H. Gordon ✓	64 ✓
10 ²⁷ A ✓	10 ²⁸ A ✓	11 ²⁷ A ✓	11 ²⁸ A ✓	11 ²⁹ A ✓	10 ²⁹ A ✓	10 ²⁸ A ✓	10 ²³ A ✓
72	71	70	69	68	67	66	65

Black Ink-1919 Ownership
Red Ink-1920 Ownership

CENTRAL CALIFORNIA TRACTION COLONY NO. 1

LOCATED IN
SECTIONS 12, 13, 20, 75 & 76
Scale 600 ft. = 1 inch.

Blanks assessed to Herald Realty Co.
All Lots 10 Acres unless otherwise noted

Brown 5-11

✓✓	✓✓	F.E. Allen H.C. Taylor Jr.	Frederick W. Schmalzing	F.J. Luebbert.
14 ²³ A.	10 ⁹⁵ A.	10 ⁷² A.	10 ⁵⁰ A.	10 ²⁴ A.
✓✓	✓✓	✓✓	✓✓	✓✓
13 ²⁵ A.		Fredk E. Allen		10 ⁵⁴ A. Ella Bunch
✓✓	✓✓	✓✓	✓✓	✓✓
13 ¹⁸ A.	H.A. H.H.J. and M.L. MacGregor	J.J. Simon		10 ⁴² A. Lillian A. Krumm 10 ²⁵ A. Minnie F. Donaldson
13 ² A.		Daisy Nicholson		10 ²⁵ A.
✓✓	✓✓	✓✓	✓✓	✓✓
13 ²⁵ A.		Anna A. Nicholson	10 ²³ A.	
Anthony Garry	✓✓	✓✓	✓✓	
12 ²⁸ A.			9 ²⁴ A.	10 ²⁴ A.
Elmer L. Lewis	E.M. Lewis	B.E. & Julia B. Porter		
12 ²⁴ A.	✓✓	✓✓	10 ²³ A.	
✓✓	✓✓	✓✓	✓✓	
12 ²⁵ A.		9 ²⁵ A.		

*See Enlarged
Sec. 19. 5-17*

Black Ink-1919 Ownership
Red Ink-1920 Ownership

CENTRAL CALIFORNIA TRACTION COLONY NO 2.

LOCATED IN
Sections 5, 8, & 9 T. 5 N. R. 7 E.

Scale 600 ft = 1 inch.

Blanks to R.E. Wallace ✓
All lots 10 Acres unless otherwise noted

Alabama S.D.

184 ✓ Arthur C. Folsom Geo. K. Porter Jr.	185 ✓ Paul E. Miller	186 ✓ Dora Strathaus	187 ✓ John A. Erickson
7 ⁸⁴ A	189 W. W. Gilkey	190 Louis & Emily Rouppert	191 John D. Riley
192 Angus McMillan A.P. MacMillan	193 W. B. Field	194 John A. Erickson	195 Carl Zitter
7 ⁸⁵ A	196	197	198
204 C.F. May	205	206 John D. & Adelaide Graales	207 T.E. McKee
8 ¹³ A	208	209 Walter M. Ross	210
211	212	213	214
215	216	217	218
219	220	221	222
1343	1344	1345	1346
1347			

Mapped.



Black Ink-1919 Ownership
Red Ink-1920 Ownership

CENTRAL CALIFORNIA TRACTION COLONY NO.2

LOCATED IN
Sections 5, 8, & 9 T.5 N. R.7 E.
Scale 600 ft.=inch.

Alabama S.D.

Blanks to R.E. Wallace. ✓
All Lots 10 Acres unless otherwise noted.

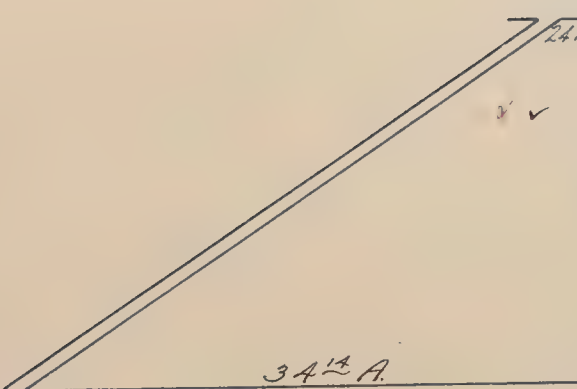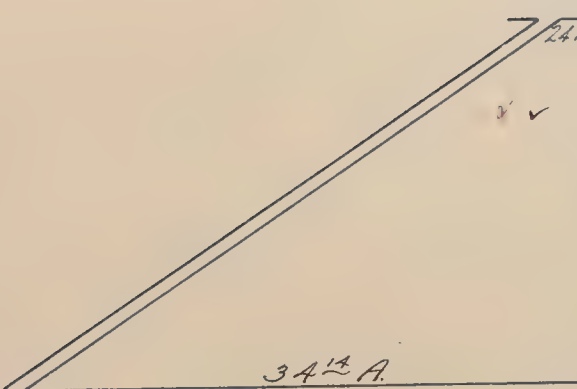		237 ✓ Mary Elma Owens 8 1/2 A.	236 ✓ Owens 9 1/2 A.	235 Alfred Thurtell ✓ 9 1/2 A.	234 ✓ 9 1/2 A.
		238 ✓ J.W. Fuller 9 1/2 A.	239 ✓ Joseph O'Connor 9 1/2 A.	240 ✓ John Thorr. 9 1/2 A.	241 ✓ 9 1/2 A.
		245 ✓ 9 1/2 A.	244 ✓ 9 1/2 A.	243 ✓ M.S. Ryder 9 1/2 A.	242 ✓ 9 1/2 A.
		246 ✓ Rosalia Rozvado. 20 1/2 A.	248 ✓ Rasmussen Sevendy G. 15 A.	249 ✓ 9 1/2 A.	250 ✓ S.W. Ryder C.A. Ryder Herman Ryder 4 1/2 A. 5 1/2 A.
		256 ✓ H.M. Ott 9 1/2 A.	255 ✓ Wm. S. Smith 9 1/2 A.	254 ✓ Richard L. Ingalsbe 9 1/2 A.	253 ✓ O.L. West 9 1/2 A.
		257 ✓ Harry R. Hyink B.C. Street 10 1/2 A.	258 ✓ W.E. & Bessie Teass 10 1/2 A.	259 ✓ E.J. Ryder 10 1/2 A.	260 ✓ 9 1/2 A.
		Checked in Garage.		262 ✓ 9 1/2 A.	261 ✓ Benson C. Weaver 9 1/2 A.
				263 ✓ 10 1/2 A.	264 ✓ 10 1/2 A.

Black Ink-1919 Ownership
Red Ink-1920 Ownership

CENTRAL CALIFORNIA TRACTION COLONY NO.3.

LOCATED IN

Section 7. T.5N. R.7E.

Scale: 300 ft. = 1 inch.

Blanks assessed to San Juan Invest. Co. ✓✓

Alabama S.D.

267 Louise M. Muller ✓ 9 ⁴⁵ A	266 ✓✓ 10 A.	265 ✓ Connie D. Muller 10 A.	264 1/2 ✓ 10 ²² A.	
268 ✓✓ 9 ⁴⁵ A.	269 Henry P. Berk ✓ 10 A.	270 Edwin J. & Geo. Birchenall & Arthur Power 10 A.	271 ✓ 10 ²⁵ A.	
276 ✓✓ 9 ⁴⁵ A.	275 Geo. Enders 10 A.	274 ✓✓ 10 A.	273 J. V. & B. M. Church ✓ A ⁹⁰ A. ✓✓ A ⁹⁰ A.	272 ✓✓ 10 ²⁵ A.
277 ✓✓ 9 ⁴⁵ A.	278 ✓✓ 10 ²² A.	279 M. L. Lowrey ✓ 10 ²² A.	280 ✓✓ 10 ²⁷ A.	281 ✓✓ 10 ²⁵ A.
287 ✓✓ 9 ⁴⁵ A.	286 ✓✓ Herald Realty Co. → 10 A.	285 ✓✓ 10 A.	284 Mary S. Lucas ✓ Herald's Realty Co. 75.5 Acres 2 ⁰⁴⁵ A.	283 Herald Realty Co. ✓✓ 10 ²⁵ A.
288 ✓✓ 9 ⁴⁵ A.	289 ✓✓ Herald Realty Co. → 10 ¹² A.	290 ✓✓ 10 ²⁵ A.	291 Mary S. Lucas ✓ 1 ⁴⁵ A. 8 ¹²⁵ A.	292 ✓ 10 ²⁵ A.
				293 ✓ 10 ⁴² A.

Amador Branch S.P. Railroad.

Mapped.

Black Ink-1919 Ownership
Red Ink-1920 Ownership

CENTRAL CALIFORNIA TRACTION COLONY NO.4.

LOCATED IN
Sections 16, 22, T.5 N. R.7 E.
Scale: 400 ft. = 1 inch

Alabama S.H.

Blanks assessed to San Juan Investment Co. & Geo. A. Starkweather ✓✓

294 ✓✓	295 ✓✓	296 ✓✓	297 ✓✓
10 ²³ A. 301 ✓✓	10 ²³ A. 300 ✓✓	10 ²³ A. 299 ✓✓	10 ²³ A. 298 ✓✓
10 A.	10 A.	10 A.	10 A.
302 ✓✓	303 ✓✓	304 ✓✓ Arthur J. Moore	305 ✓✓
10 ²³ A. 309 ✓✓	10 ²³ A. 308 ✓✓	10 ²³ A. 307 ✓✓	10 ¹² A. 306 Victor W. Winfrey ✓✓
10 A.	10 A.	10 A.	9 ²² A.

Black Ink-1919 Ownership
Red Ink-1920 Ownership

CENTRAL CALIFORNIA TRACTION COLONY NO. 4.

LOCATED IN
Sections 16, 22, T.5 N. R.7 E.
Scale: 400 ft. = 1 inch.

Brown H. - J. L.

Blanks assessed to San Juan Inv. Co.


310 ✓✓	311 ✓✓	312 ✓✓	313 ✓✓
10 ¹⁰ A. 317 ✓✓	10 ¹³ A. 316 F.M. Kocher ✓✓	10 ²³ A. 315 ✓✓	10 ¹⁴ A. 314 ✓✓
10 A. 318 ✓✓	10 ²³ A. 319 ✓✓	10 A. 320 ✓✓	10 ²⁷ A. 321 ✓✓
10 A. 325 ✓✓	10 A. 324 ✓✓	10 A. 323 ✓✓	10 ¹⁰ A. 322 ✓✓
10 A.	10 ¹¹ A.	10 A.	10 ¹¹ A.

CENTRAL CALIF. TRACTION UNIT NO. 5

LOCATED IN
Sec's. 1 & 2 T. 6 N. R. 6 E. & 6-7 T. 6 N. R. 7 E.
Scale: 1 in. = 600 feet.


Blanks to Herald Realty Co.

Black Ink-1919 Ownership
Red Ink-1920 Ownership

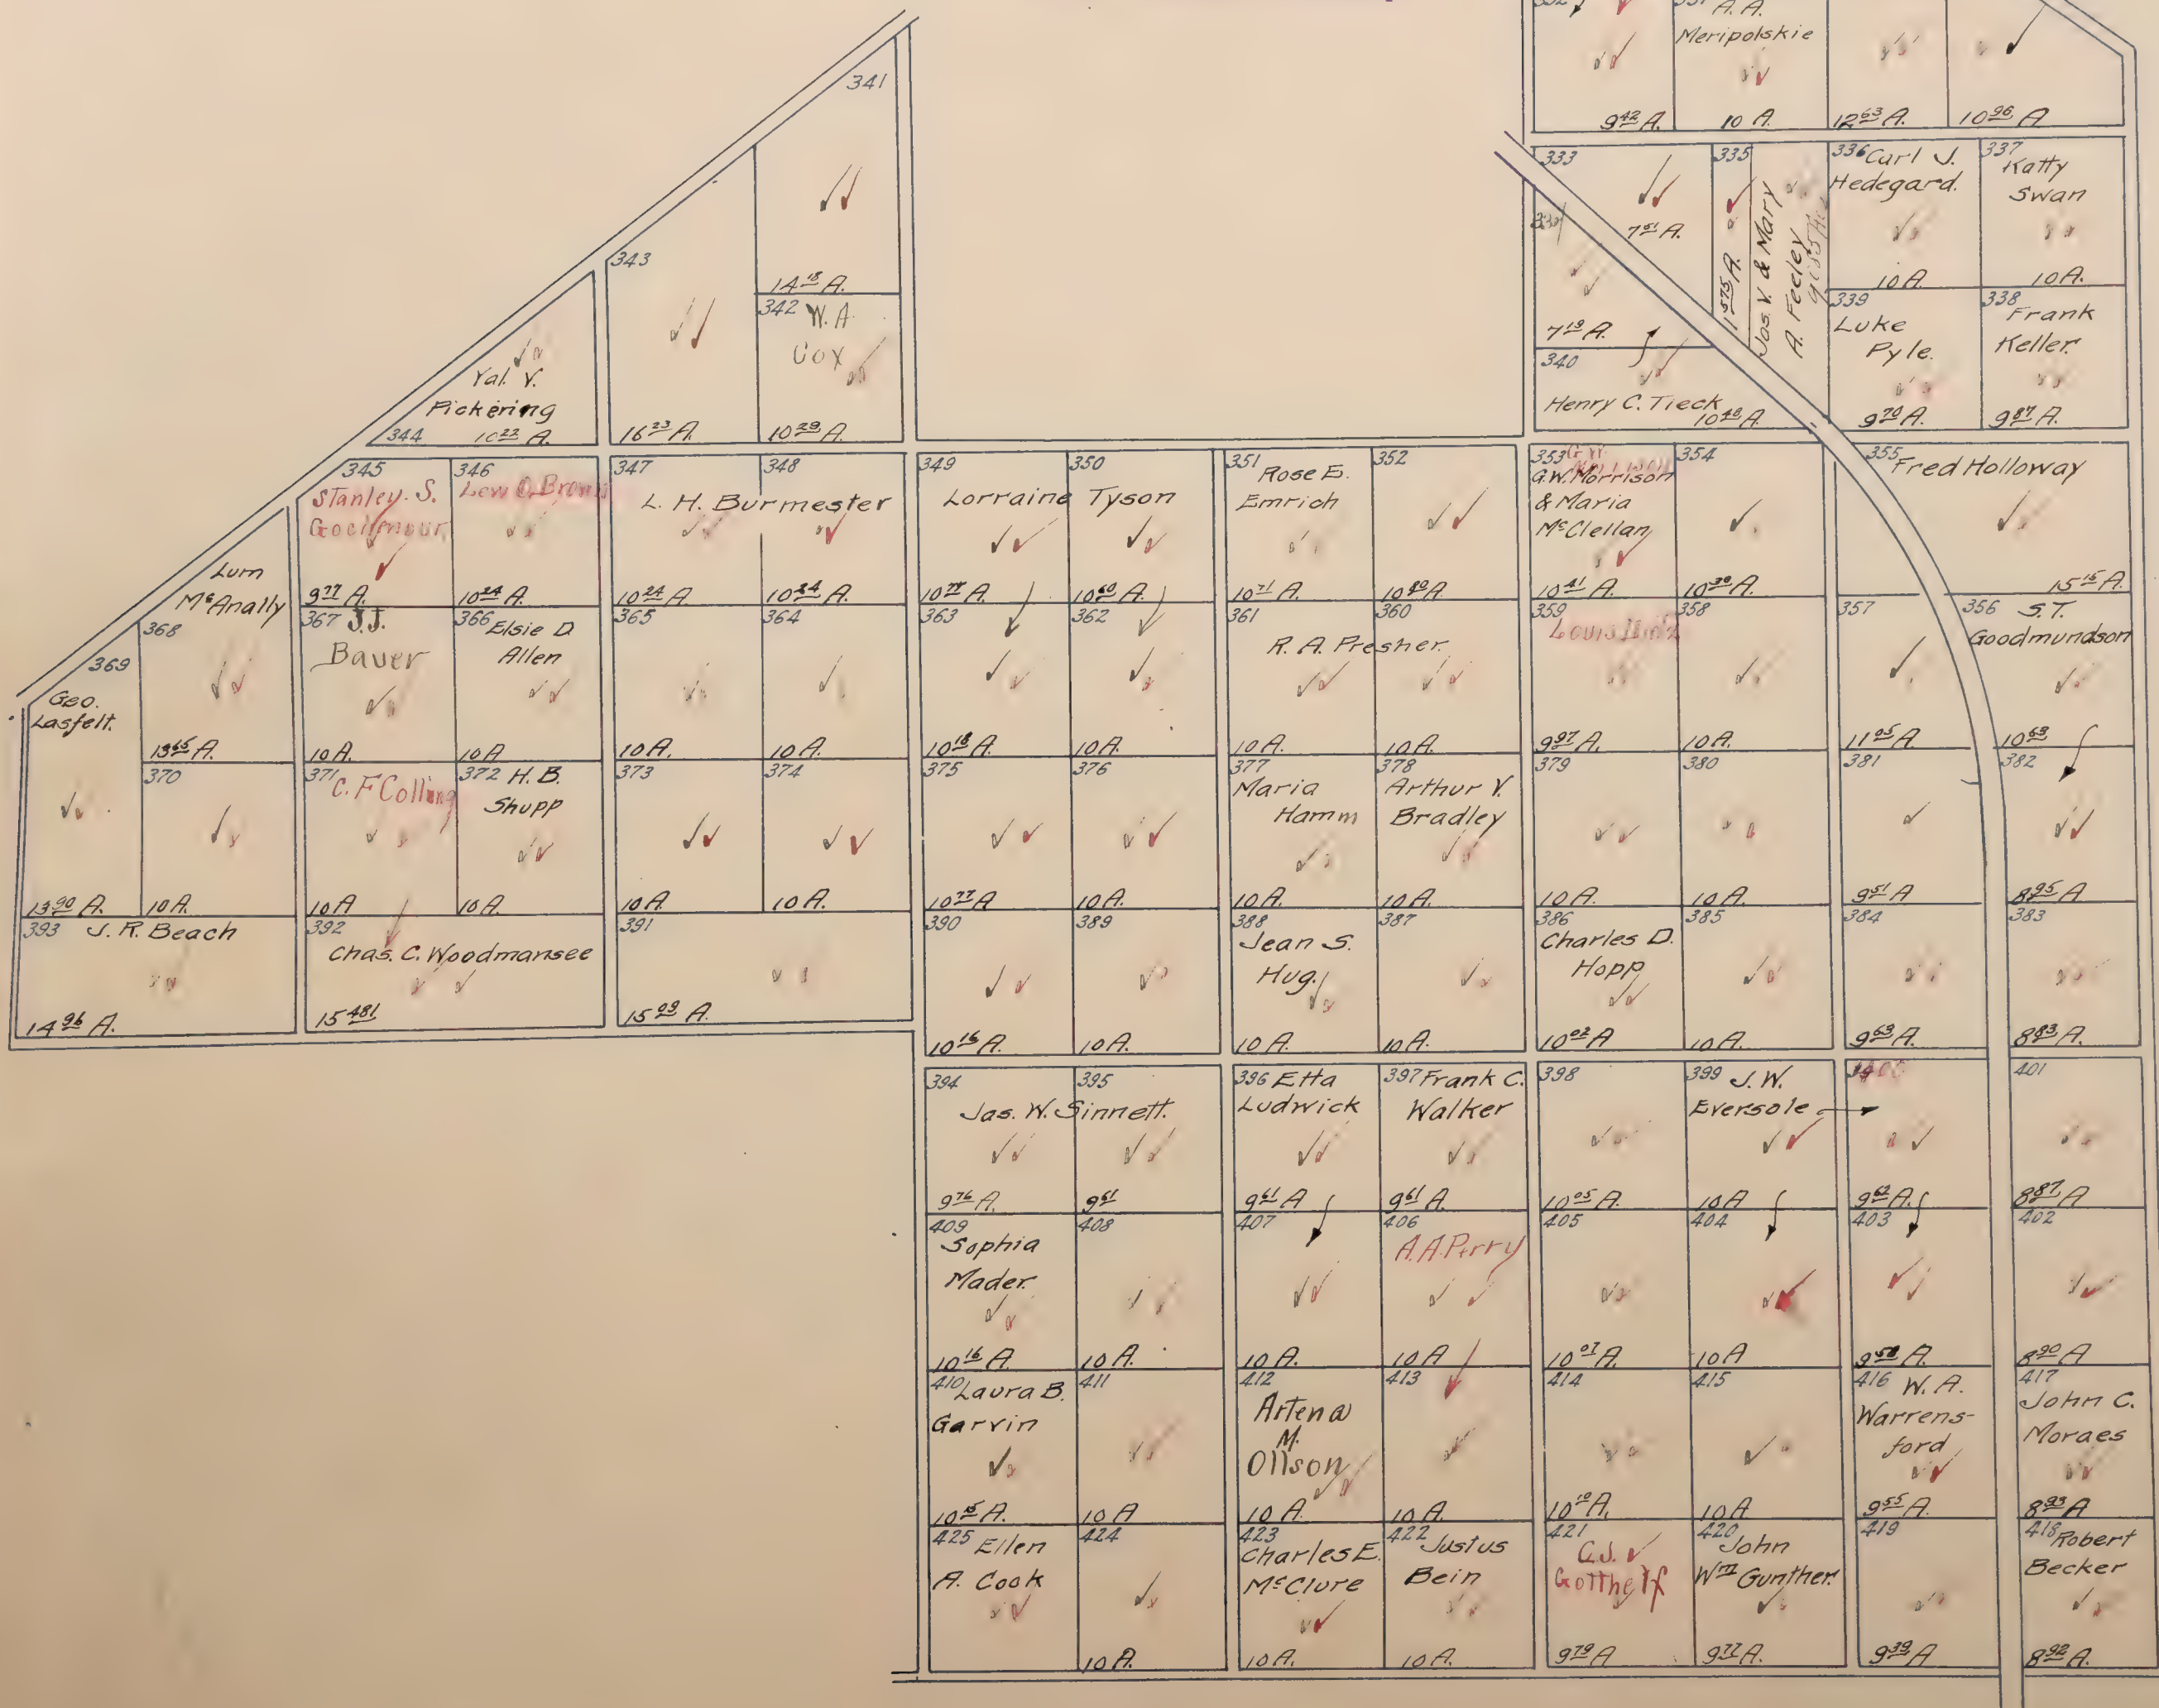

located in
Section 1; 2-12 T.6N.R.6E & 6 T.6N.R.7E & Hartnell Grant
Scale 1" = 600 ft.

Pillard. S.D.
Davis S.D.

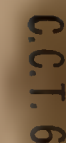

Mapped.

C.C.T. UNIT NO. 7


located in
Hartnell Grant
Section 6004

Black Ink-1919 Ownership
Red Ink-1920 Ownership

100 S.D.

Dillard S.D.

Blanks to Eleanor Investment Co. ✓

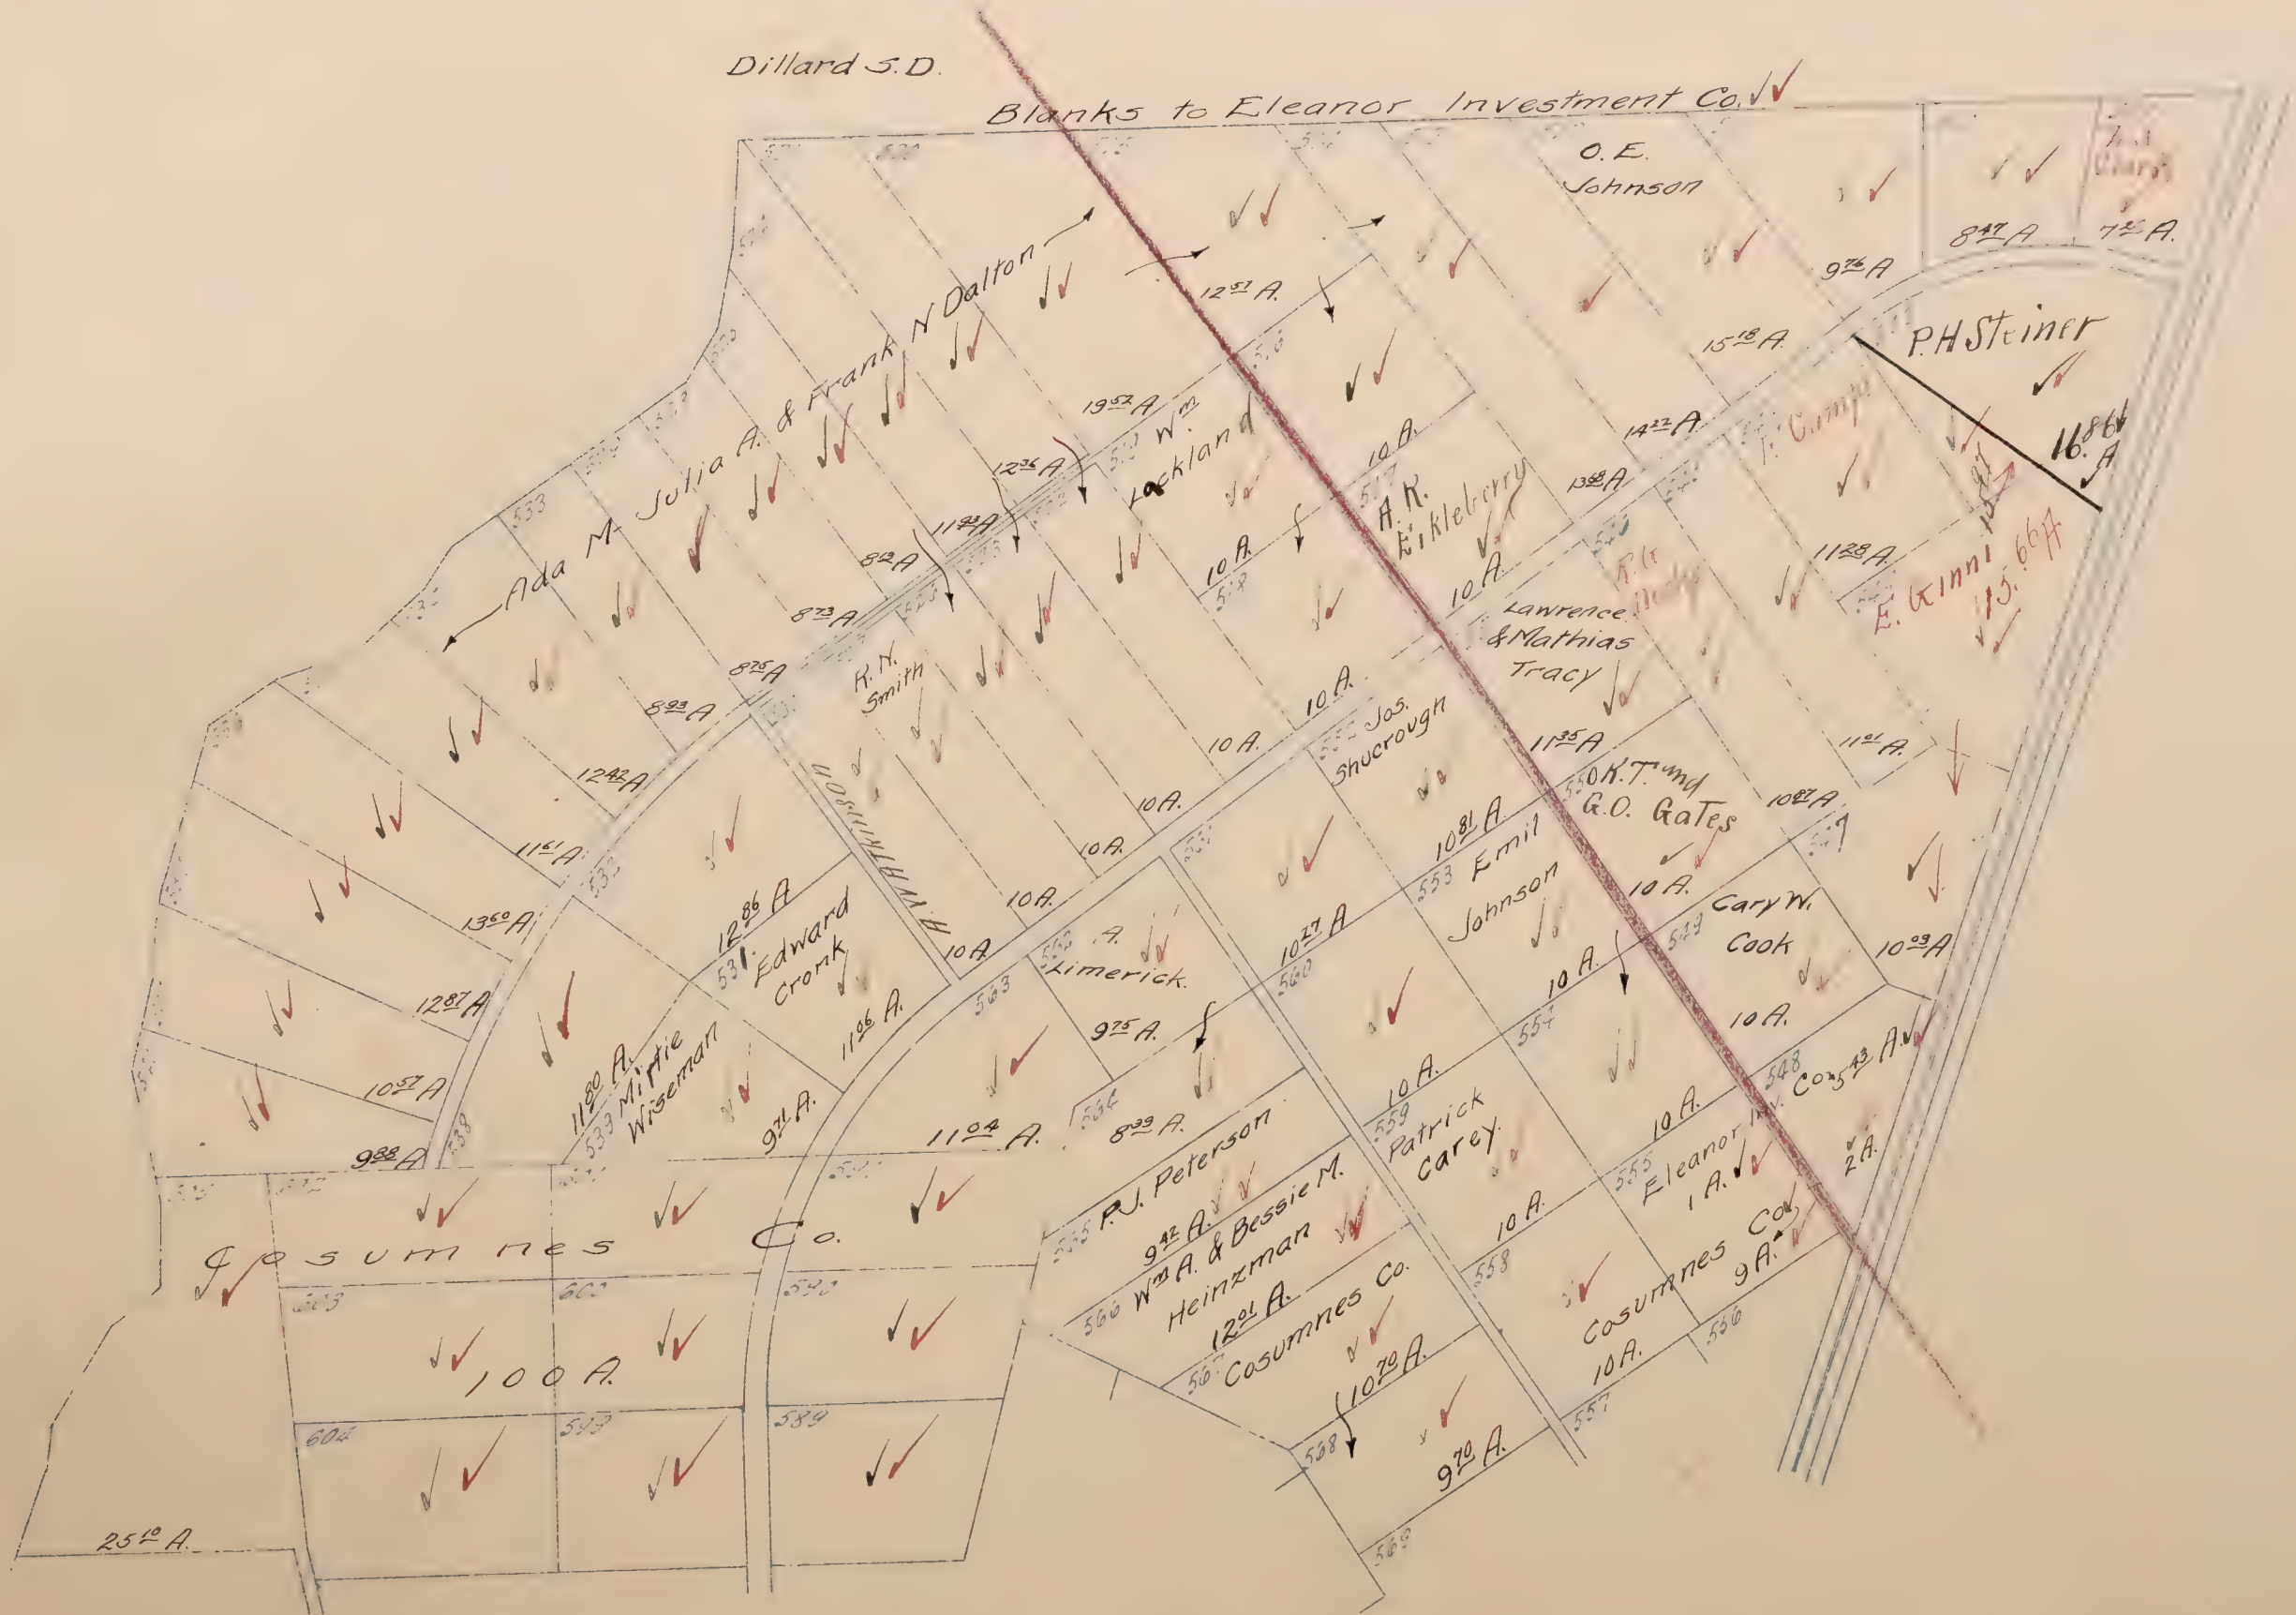


Black Ink-1919 Ownership
Red Ink-1920 Ownership

C.C.T UNIT NO. 7

located in
Hortnell Grant
6002 1000 Dillard 100

Blanks assessed to Casumnes Co. 1

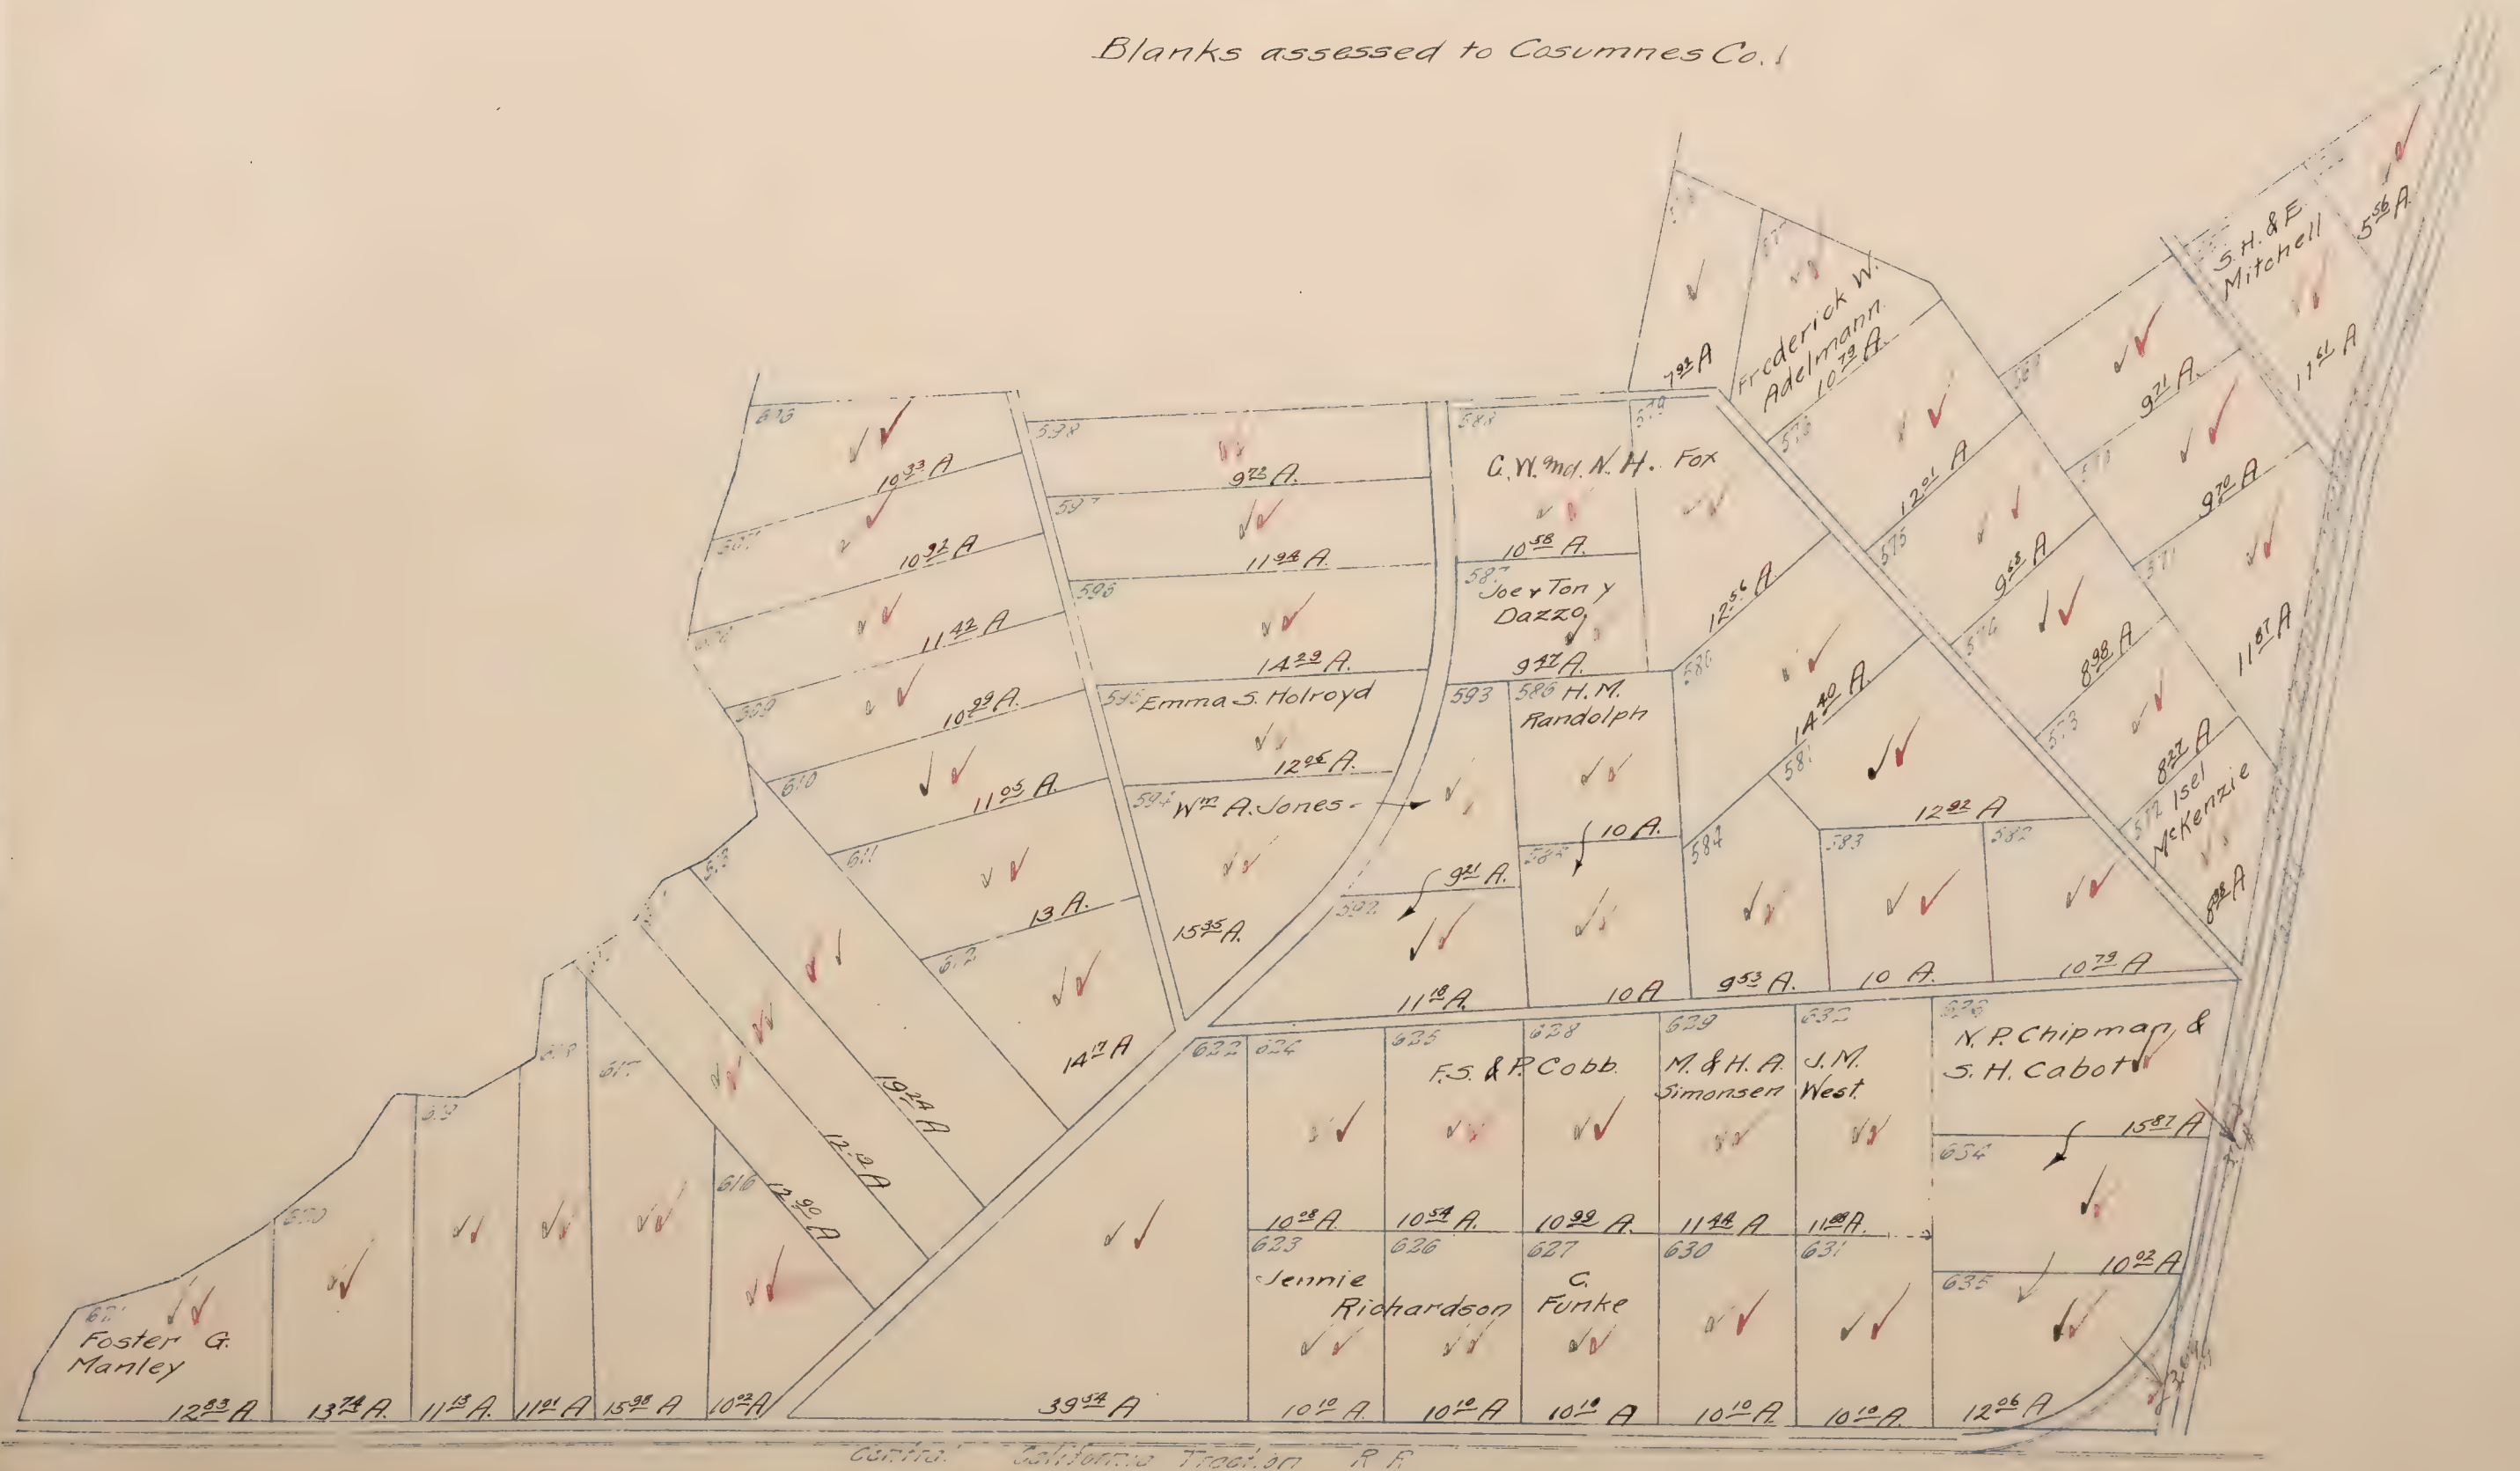


Black Ink-1919 Ownership
Red Ink-1920 Ownership

C.C.T. UNIT NO. 6

10000 S. 10th St.
10000 S. 10th St.
10000 S. 10th St.

Blanks to Eleanor Investment Co.

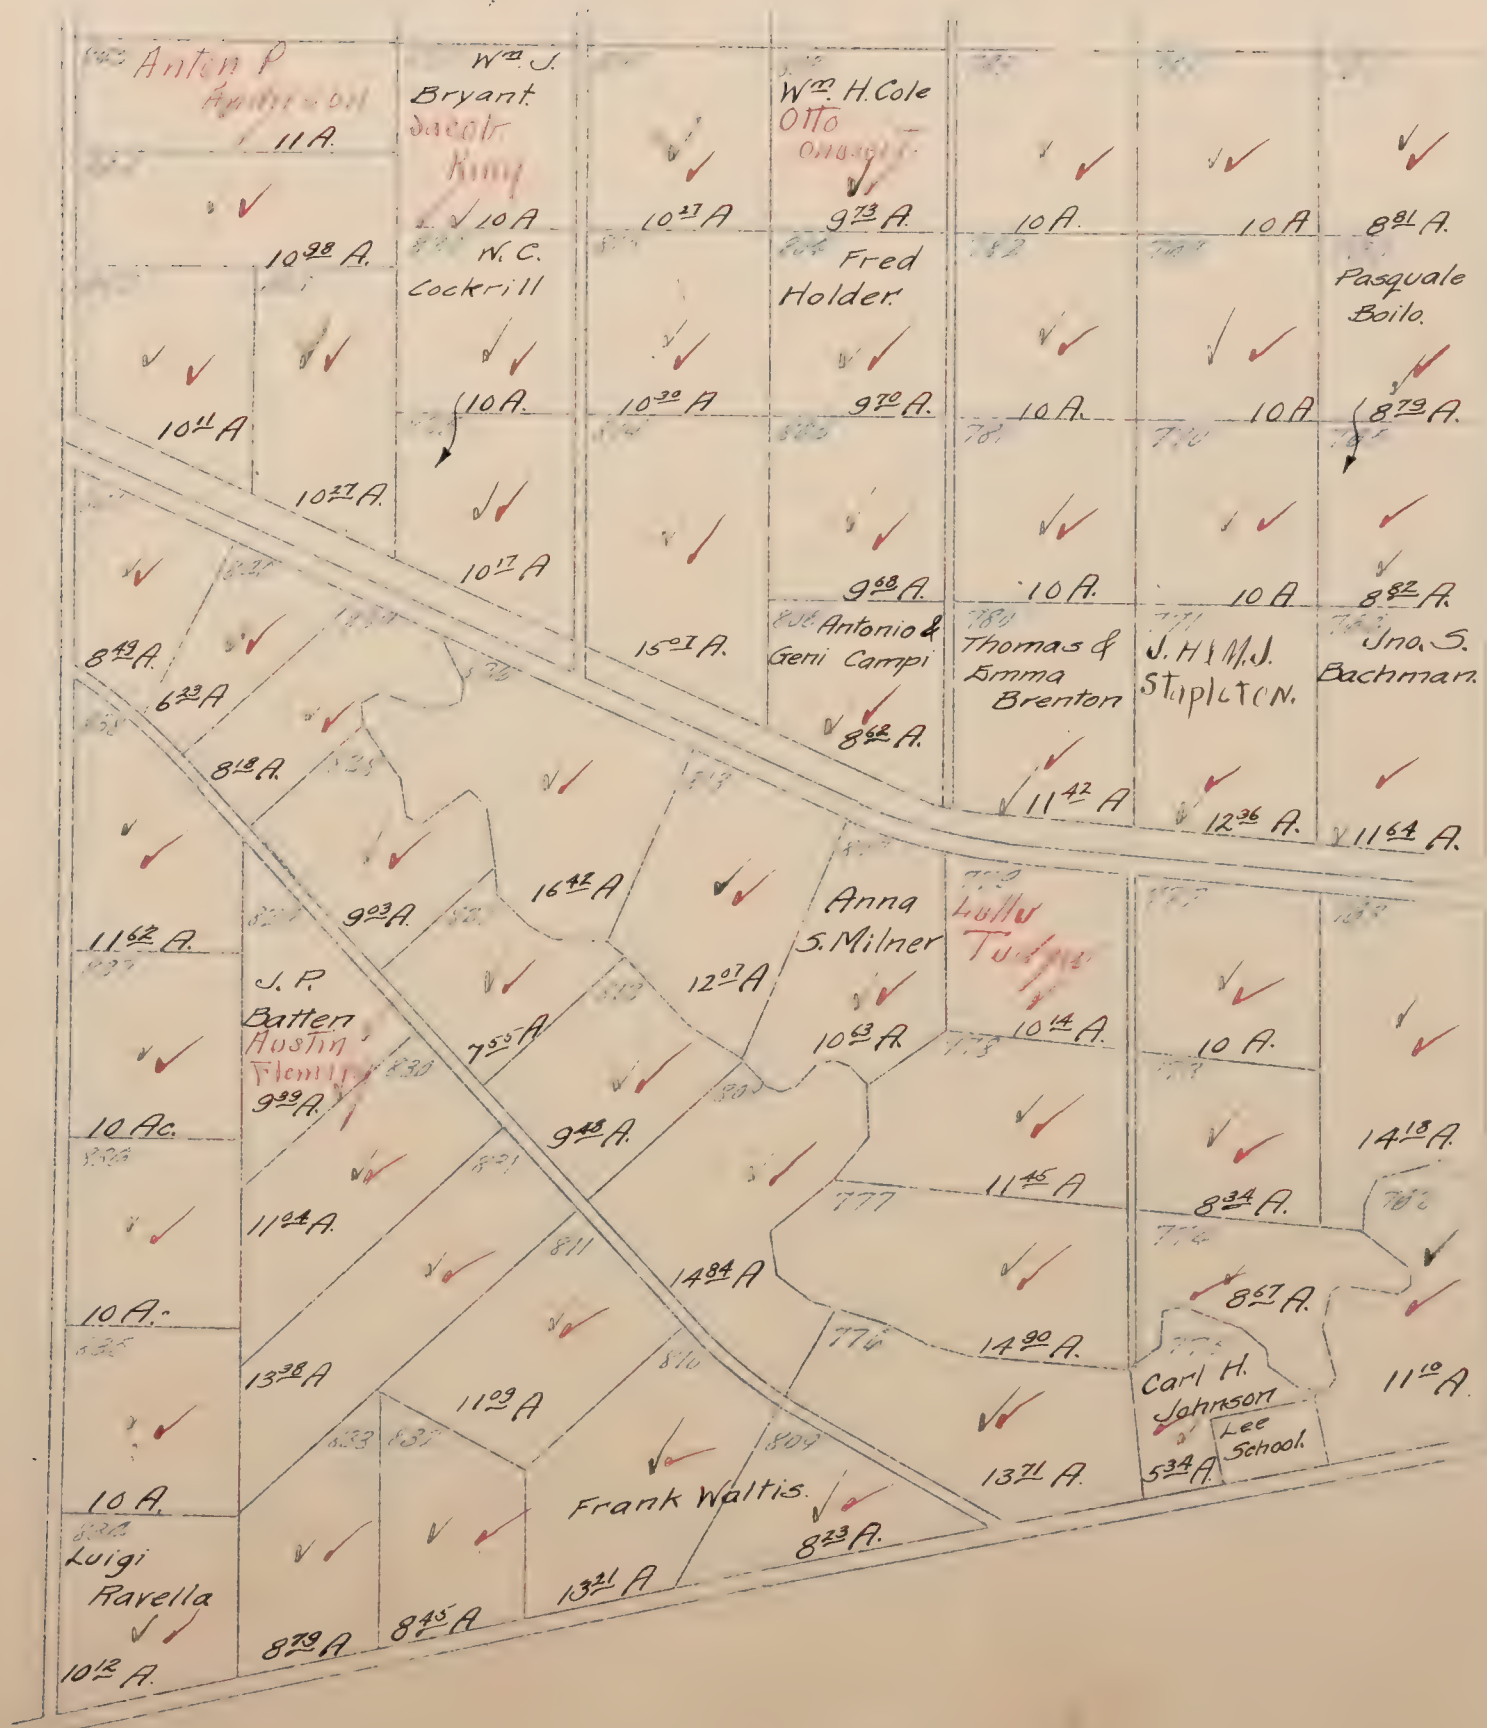

Mapped.

C.C.T. UNIT NO. 8


located in

Lot 9 Hartnell Grant

Black Ink-1919 Ownership

Red Ink-1920 Ownership

Blanks to Eleanor Investment Co. ✓✓ Lee S.D.

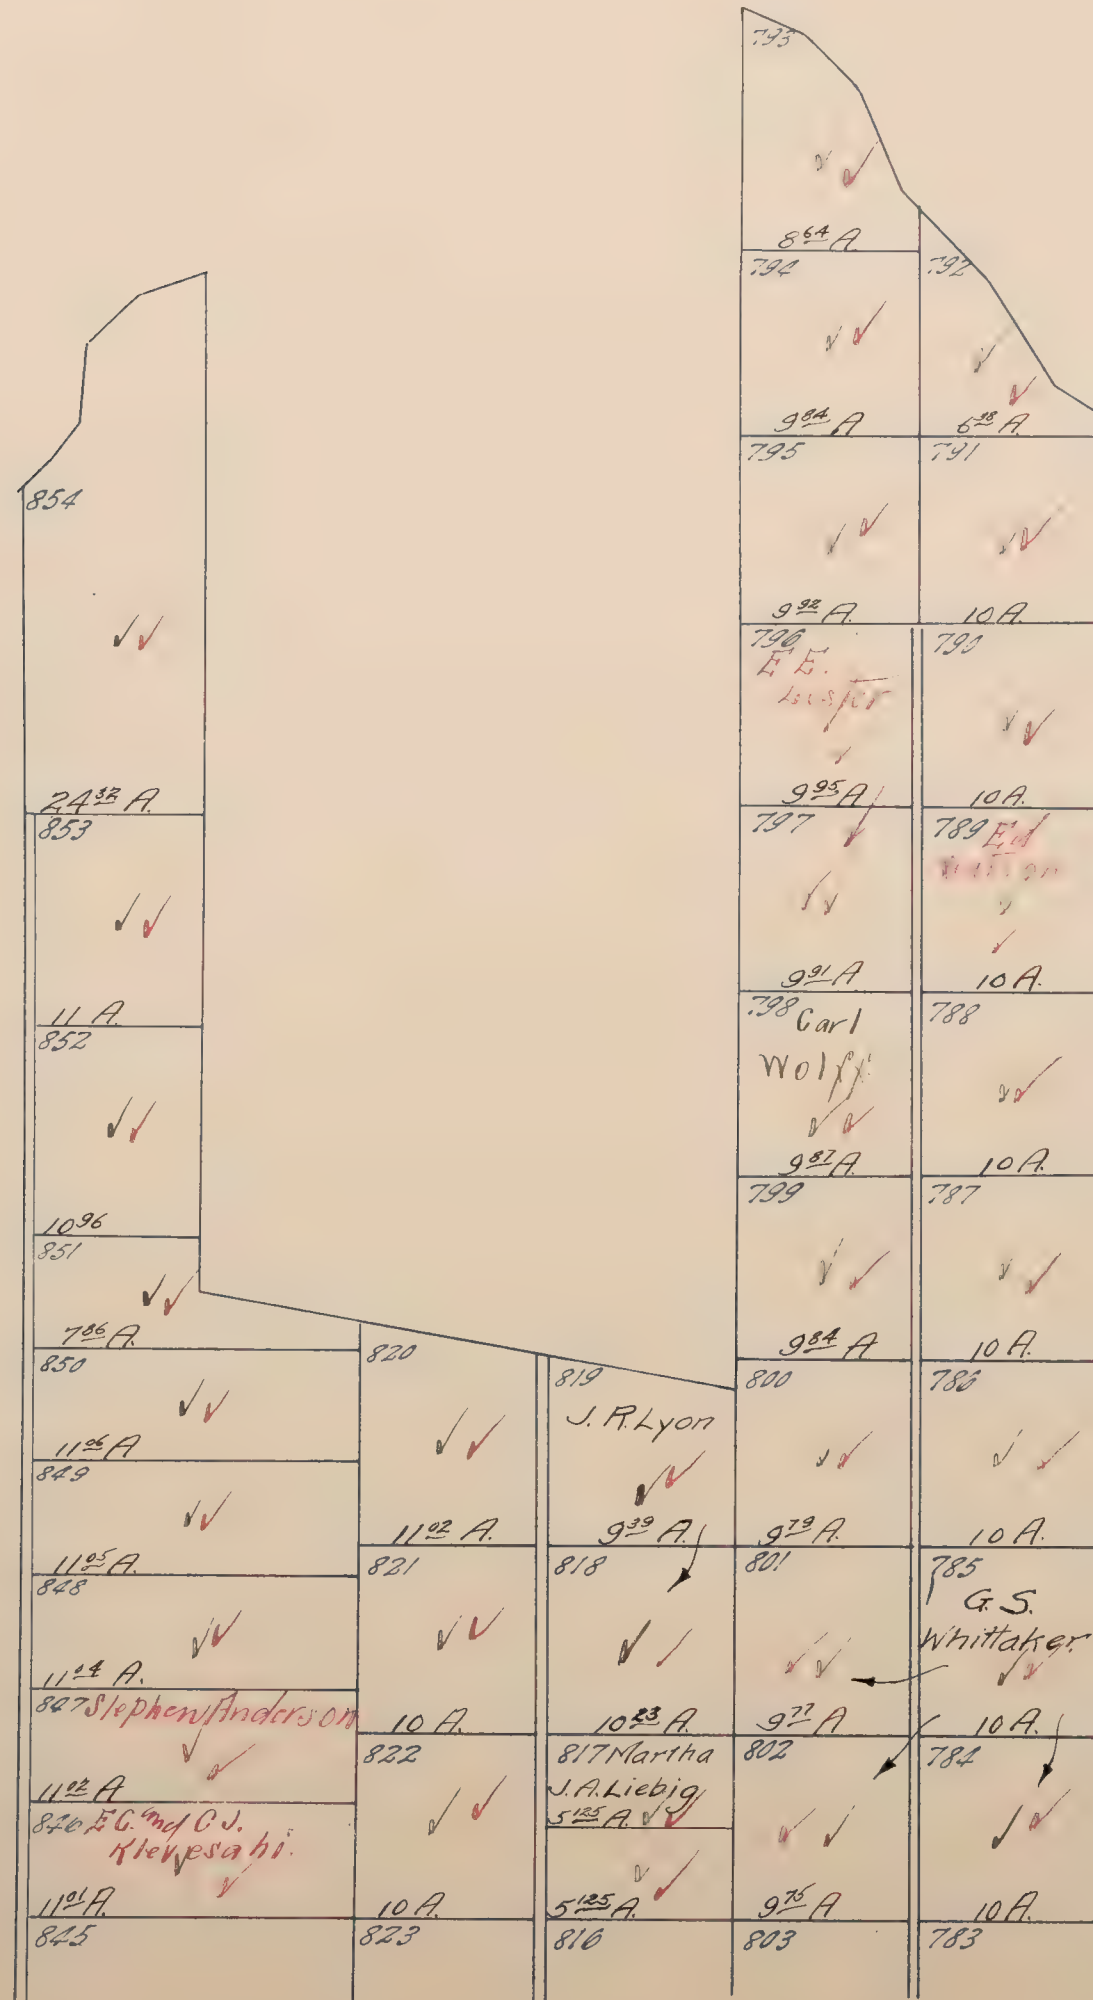

Mapped.

C.C.T. UNIT NO. 9

located in

Section 28, T.7N.R.6E.

Scale 1" = 200 ft

Black Ink - 1919 Ownership

Red Ink - 1930 Ownership

Pleasant Grove S.D.

Blanks to Hamilton Investment Co ✓✓

636	637	638	639 <i>Mr. & Mrs. Hoff</i>
✓✓ 9 ²² A.	✓✓ 10 ²⁵ A.	✓✓ 9 ²² A.	✓✓ 10 ²⁵ A.
643	642	641	640 <i>John H. Lewis</i>
✓✓ 9 ²² A.	✓✓ 10 ²⁵ A.	✓✓ 9 ²² A.	✓✓ 10 ²⁵ A.
644	645 <i>Chas. C. & Dailey Case</i>	646	647
✓✓ 9 ²⁵ A.	✓✓ 10 ²⁵ A.	✓✓ 9 ²² A.	✓✓ 10 ²² A.
650	651 <i>In. Acreage to D. M. Hurman</i>	649	648
✓✓ 10 A.		✓✓ 9 ²² A.	✓✓ 10 A.

Black Ink-1919 Ownership
Red Ink-1920 Ownership

C.C.T. UNIT. NO. 10.

located in
Section 22 T.7N.R.6E
Scale 1" = 300 ft

Pleasant Grove S.D.

C.C.T. 10



C.C.T. UNIT. NO. 11

located in
NE 1/4 Sec. 20 T7N. R6E.
Scale 1" = 200 ft

Black Ink - 1919 Ownership
Red Ink - 1920 Ownership

Rease S.D.

Blanks to Sheldon Township & Realty Co. ✓

683	684 <i>Harry W. Benner</i>	685	686
✓✓ 10 Ac.	✓✓ 10 Ac.	✓✓ 10 Ac.	✓✓ 10 Ac.
689	689 Thomas M. O'Hagan	688 Marcel Labrousseorf	687 Geo J. Backman
✓✓ 10 Ac.	✓✓ 10 Ac.	✓✓ 10 Ac.	✓✓ 5 Ac.
691 G. Scottini	692 Margt O'Hagan	Kathleen Mc Carrn. <i>Agnes Flynn</i> <i>Kathleen</i> <i>Mc Carrn.</i>	693 <i>Giuseppe Lepriusti</i>
✓✓ 10 A.	✓✓ 5 A.	✓✓ 5 A.	✓✓ 10 A.
698	697 Margt. O'Hagan	Agnes Flynn <i>Kathleen</i> <i>Agnes Flynn</i>	696
✓✓ 10 ³² A.	✓✓ 5 ²¹ A.	✓✓ 3 ²¹ A.	✓✓ 10 ¹¹ A.
			695
			✓✓ 10 ²⁴ A.
			✓✓ 10 ²⁰ A.

Mapped.

C.C.T. UNIT NO. 12

located in
Section 10, T.7N.R.6E.
Scale: 1" = 200 ft.

Black Ink-1919 Ownership
Red Ink-1920 Ownership

Excelsior SD

Blanks to Sheldon Townsite & Realty Co. ✓✓

699 ✓✓	700 ✓✓	701 ✓✓	702 ✓✓
10 A.	10 A.	10 A.	10 ⁰³ A.
706 ✓✓	705 ✓✓	704 ✓✓	703 ✓✓
10 A.	10 A.	10 A.	10 ⁰² A.
707 Thomas Tyler ✓✓	708 ✓✓	709 ✓✓	710 Archibald McKenzie ✓✓
10 A.	10 A.	10 A.	10 A.
714 ✓✓	713 ✓✓	712 P. Natis. ✓✓	711 Maud Natis. ✓✓
9 ⁹¹ A.	9 ⁹² A.	9 ⁹³ A.	9 ⁹⁴ A.

Black Ink-1919 Ownership
Red Ink-1920 Ownership



~~Lower 1/2 of Lot 1 and Upper 1/2 Lot 2~~

~~Lower Daylor region Omposchittles Grant~~

Scale: 1"=400ft.

Pleasant Grove S. D.

Blanks to Sheldon Townsite & Realty Co. ✓✓

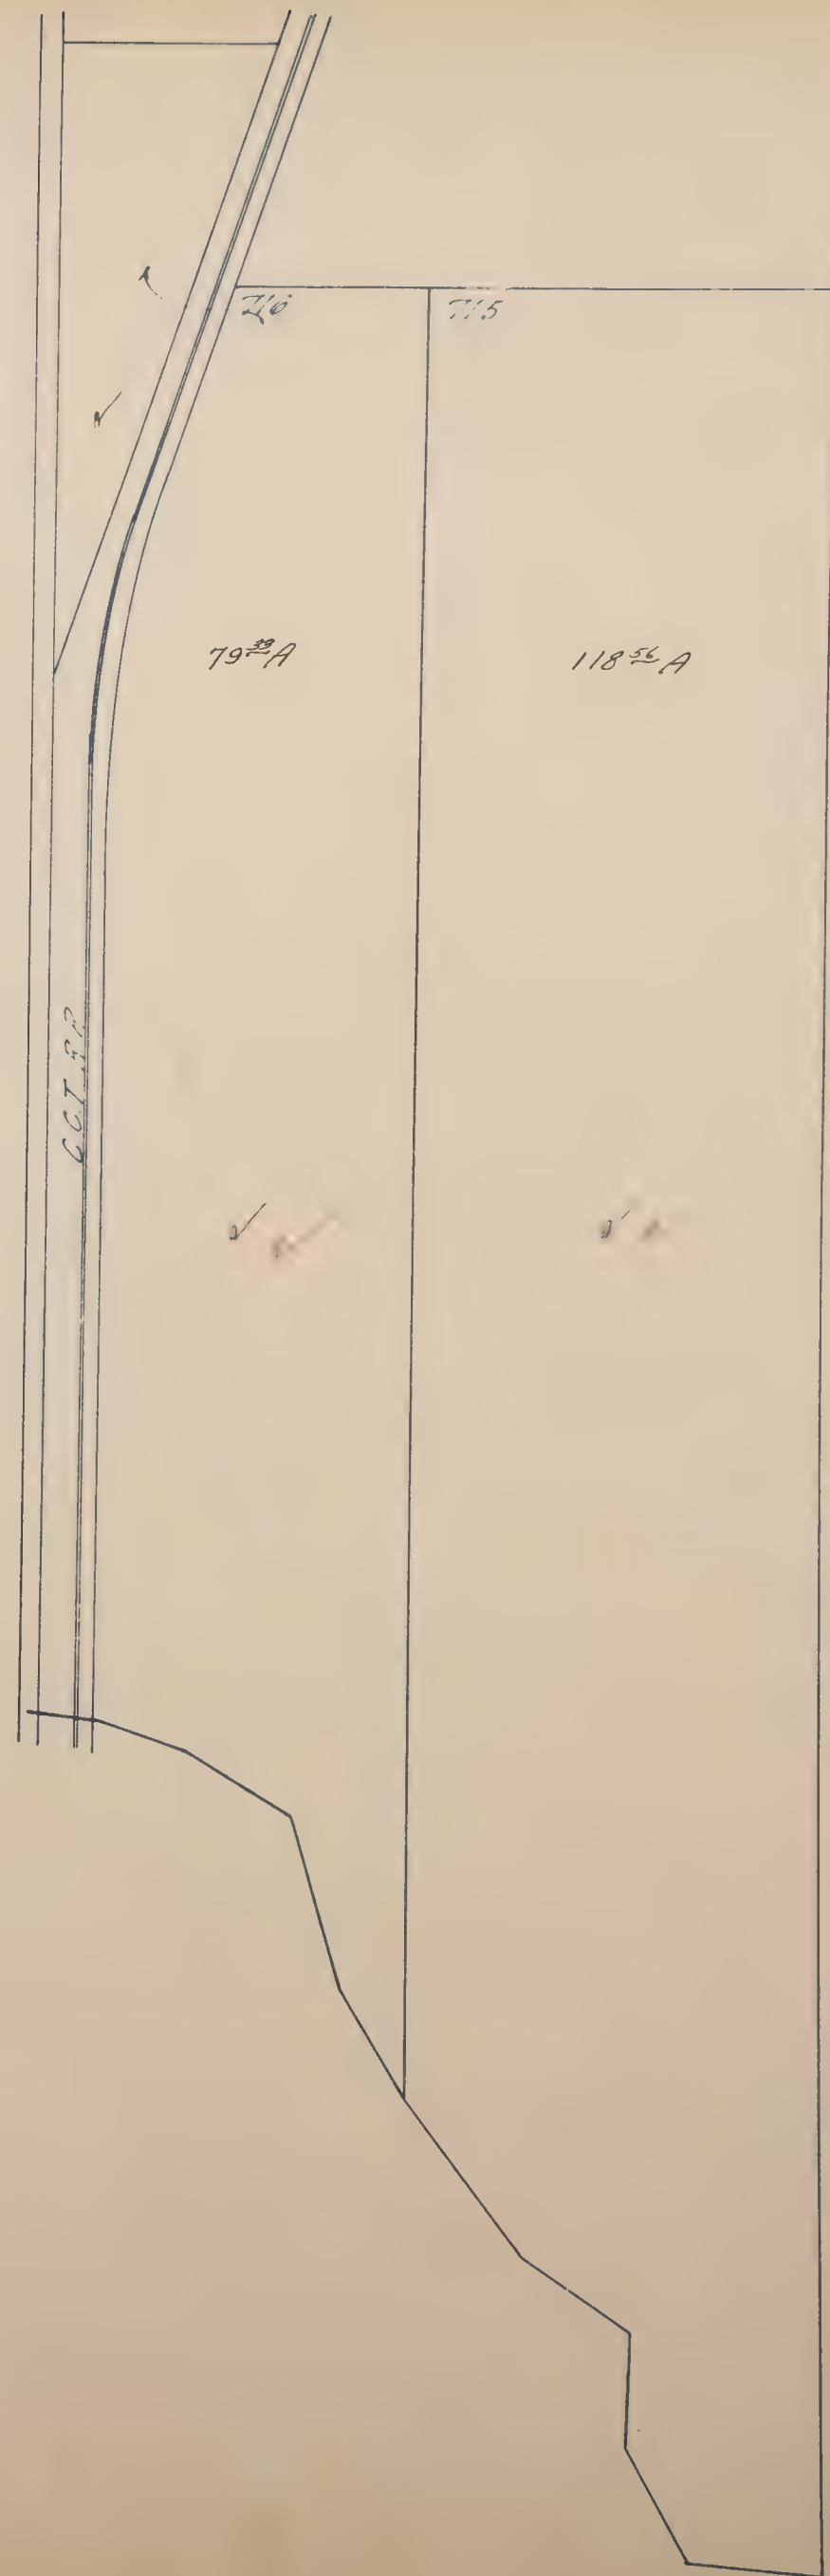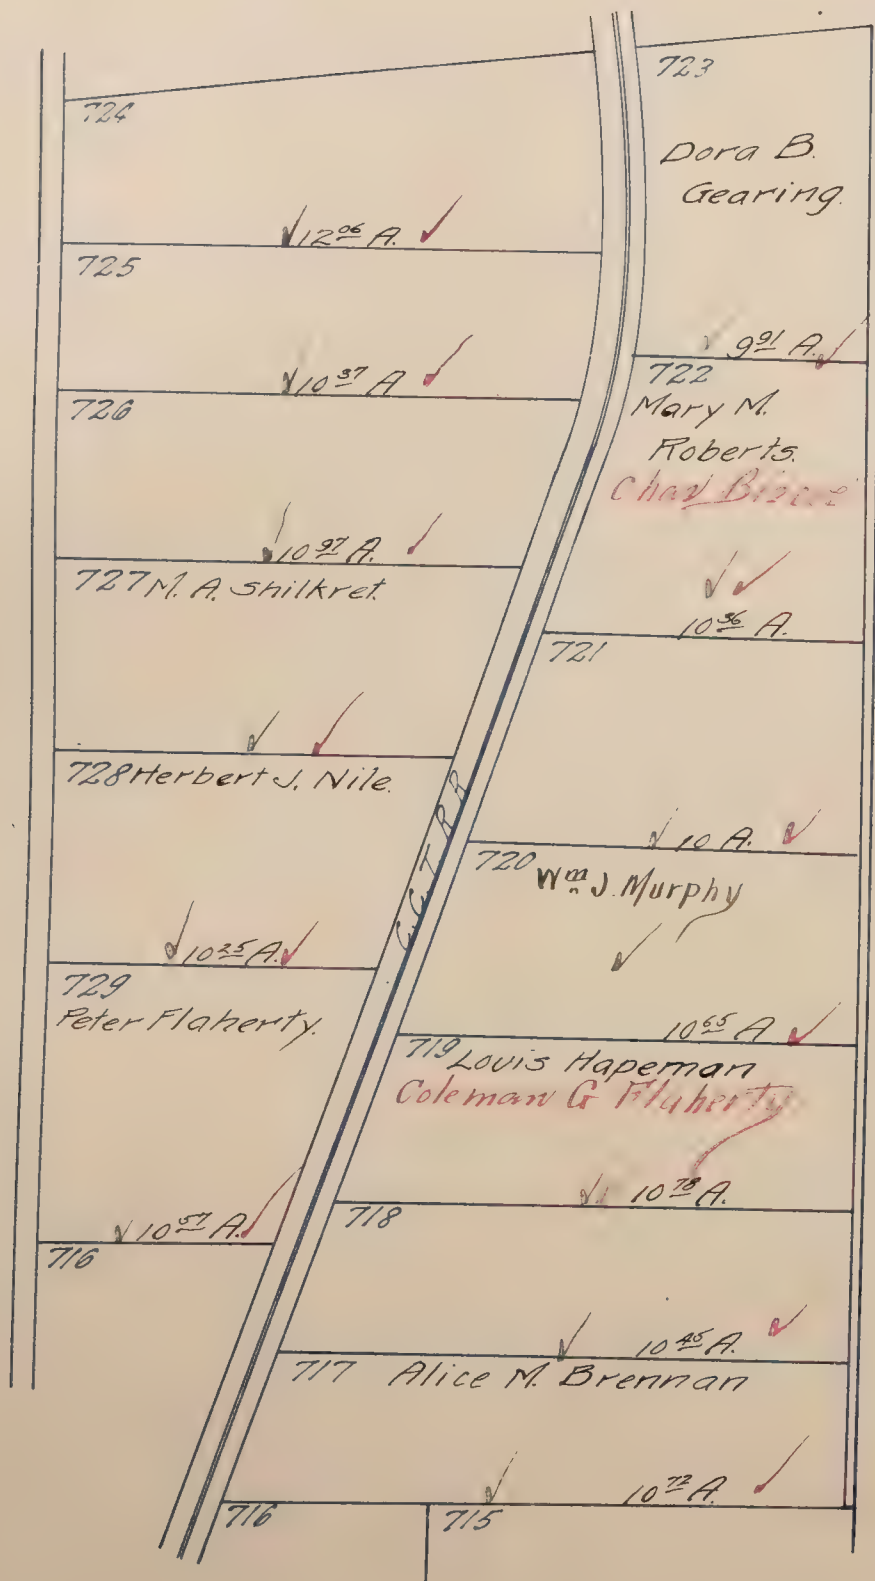

CEN. CAL. TRAC. UNIT NO. 14

located in
Hartnell Grant
Scale: 1"=600'

Black Ink-1919 Ownership
Red Ink-1920 Ownership
Lee S.D.

Blanks to Eleanor Investment Co. ✓
All Lots 10 Acres unless otherwise noted.

CENTRAL CALIFORNIA TRACTION UNIT NO. 16

955 134	954 ✓✓	953 ✓✓	952 ✓✓	951 ✓✓	950 ✓✓	949 ✓✓	948 ✓✓	947 ✓✓	946 ✓✓	945 ✓✓
935 10 ²⁵ A.	936 ✓✓	937 ✓✓	938 ✓✓	939 ✓✓	940 ✓✓	941 ✓✓	942 ✓✓	943 ✓✓	944 ✓✓	945 11 ²⁵ A.
932 11 ²⁵ A.	931 ✓✓	930 ✓✓	929 Hattie Hooker ✓✓	928 ✓✓	927 ✓✓	926 ✓✓	925 ✓✓	924 ✓✓	923 ✓✓	922 19 ²⁵ A.
912 Lee Hall ✓✓	913 ✓✓	914 ✓✓	915 ✓✓	916 ✓✓	917 ✓✓	918 ✓✓	919 ✓✓	920 ✓✓	921 ✓✓	922 ✓✓
911 11 ²⁵ A.	910 Mabel Wilson ✓✓	909 ✓✓	908 ✓✓	907 ✓✓	906 ✓✓	905 ✓✓	904 ✓✓	903 ✓✓	902 ✓✓	901 15 ²⁵ A.
889 Josef & Louise Nicolowski ✓✓	890 ✓✓	891 Beatrice Coyne ✓✓	892 ✓✓	893 ✓✓	894 ✓✓	895 ✓✓	896 ✓✓	897 ✓✓	898 ✓✓	899 ✓✓
888 7 ²⁵ A.	887 ✓✓	886 Philip E. & Fannie L. Benson ✓✓	885 ✓✓	884 ✓✓	883 ✓✓	882 ✓✓	881 ✓✓	880 ✓✓	879 ✓✓	878 ✓✓
867 ✓✓	866 ✓✓	865 Antonio Maranta ✓✓	864 Margherita Abbondio ✓✓	863 ✓✓	862 ✓✓	861 ✓✓	860 ✓✓	859 ✓✓	858 ✓✓	857 ✓✓
866 8 ²⁵ A.	865 ✓✓	864 ✓✓	863 ✓✓	862 ✓✓	861 ✓✓	860 ✓✓	859 ✓✓	858 ✓✓	857 ✓✓	856 15 ²⁵ A.
865 6 ²⁵ A.	864 12 ²⁵ A.	863 12 ²⁵ A.	862 12 ²⁵ A.	861 12 ²⁵ A.	860 12 ²⁵ A.	859 12 ²⁵ A.	858 12 ²⁵ A.	857 12 ²⁵ A.	856 12 ²⁵ A.	855 6 ²⁵ A.



CEN. CAL TRAC UNIT NO. 14

located in Hartnell Grant
 Scale: 1"=600'

Black Ink-1919 Ownership
 Red Ink-1920 Ownership

Blanks to Eleanor Investment Co. *Lee S.D.*
 All Lots 10 Acres unless otherwise noted.

CEN. CAL. TRAC. UNIT No. 8

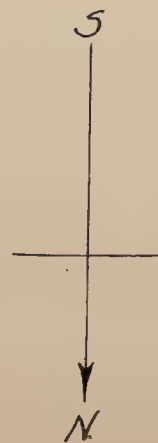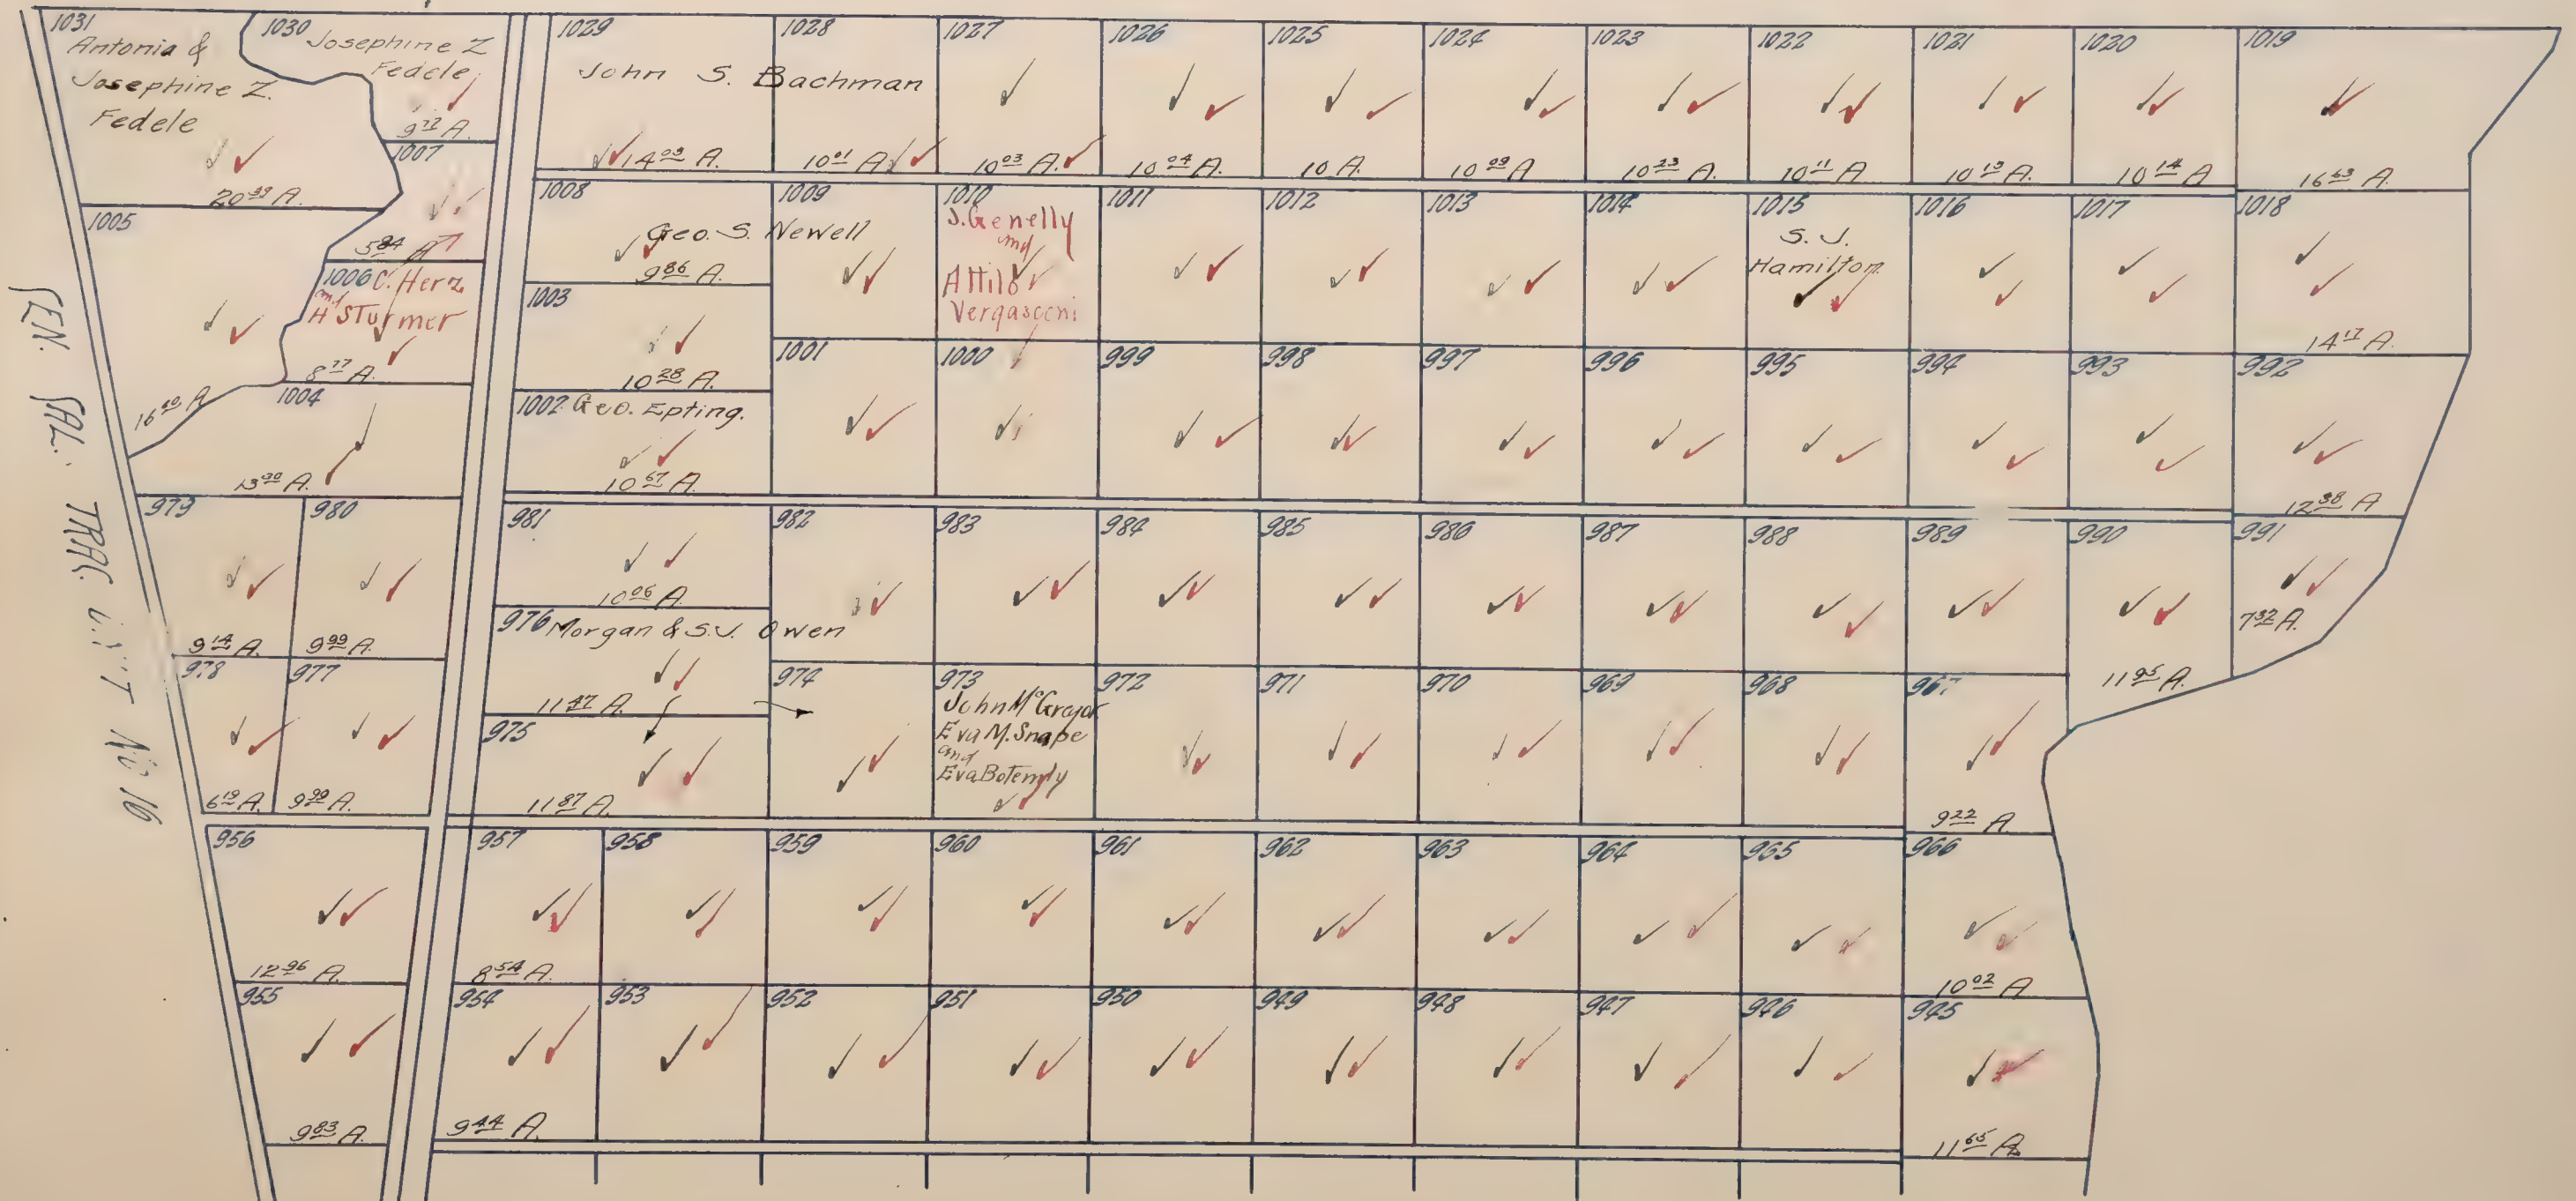

Mapped.

Black Ink-1919 Ownership
Red Ink-1920 Ownership

C.C.T UNIT NO. 15

being
W 1/2 Sec. 32 T. 6 N. R. 7 E.
Scale 1" = 300 ft.

Blanks to Inland Realty Co. ✓✓ Colony S.D.
Alabama S.D.
All Lots 10 Acres unless otherwise noted.

Alabama S.D.

Colony S.D.

758 ✓	757 ✓	750 Ernest L. Nagle ✓✓	749 ✓✓	742 ✓✓	741 Ella M. Lockwood ✓✓	734 ✓✓	733 Frederick J. and O. P. Parades ✓✓
759 ✓	756 ✓	751 ✓	748 ✓✓	743 ✓✓	740 ✓✓	735 ✓✓	732 10 ²⁵ A. ✓✓
760 ✓	755 ✓	752 ✓✓	747 ✓✓	744 ✓✓	739 ✓✓	736 ✓✓	731 10 ³⁰ A. ✓✓ Douglas H. Bernard
761 F. R. M. Bloomer ✓✓	754 ✓	753 ✓✓	746 ✓✓	745 ✓✓	738 Fletcher Fogg ✓✓	737 ✓✓	730 10 ²⁵ A. ✓✓
9 ⁹⁹⁹ A.	9 ⁹⁸⁴ A.	9 ⁹⁷² A.	9 ⁹⁷⁰ A.	10 ²² A.	10 ²⁰ A.	10 ¹⁸ A.	10 ²⁵ A.

Mapped.

CEN. CAL. TRAC. UNIT NO. 16

located in

Hartnell Grant & Sec. 24 T.7N. R.7E.

Scale: 1"=800ft.

Lee S.D.

Blanks to Eleanor Investment Co. ✓✓

All Lots 10 Acres unless otherwise noted.

Black Ink-1919 Ownership
Red Ink-1930 Ownership

CENTRAL CALIFORNIA TRACTION UNIT NO. 14



CEN. CAL. TRAC. UNIT NO.16

located in

Hartnell Grant & Sec 24 T.7N. R7E.

Scale: 1"=800'

Blanks to Eleanor Investment Co. *Lee S.D.*

Black Ink-1919 Ownership

Red Ink, 1920 Ownership

ORANGE

Wesley

CENTRAL CALIFORNIA TRACTION UNIT NO 14

[illegible]

CENTRAL CALIFORNIA TRACTION UNIT No 17

Located in

HARTNEL GRANT AND SEC. 2 T 6 N. R. 7 E. & SEC. 35 T 7 N. R. 7 E.

Scale, 1" = 800'

Blanks to Eleanor Investment Co.

Lee S.D.

C. C. T. UNIT No. 16

Back in Greengate - 1920

C. C. T. UNIT No. 8



Mapped.

CHAFFINS ADDITION TO ELVERTA

LOCATED IN
Section 21. T.10N. R.5E.
Sacramento County California
Scale 1" = 300.

Blanks to Loring Chaffing.

Black Ink - 1919 Ownership
Red Ink - 1920 Ownership

Lincoln S. II

Mapped.

CHERRY HILL


LOCATED IN

N.E. 1/4 of N.W. 1/4 of Sec. 19 T.8N., R.5E.

Scale: 40' = 1"

Black Ink-1919 Own
Red Ink-1920 Own

Palmetto S.D.

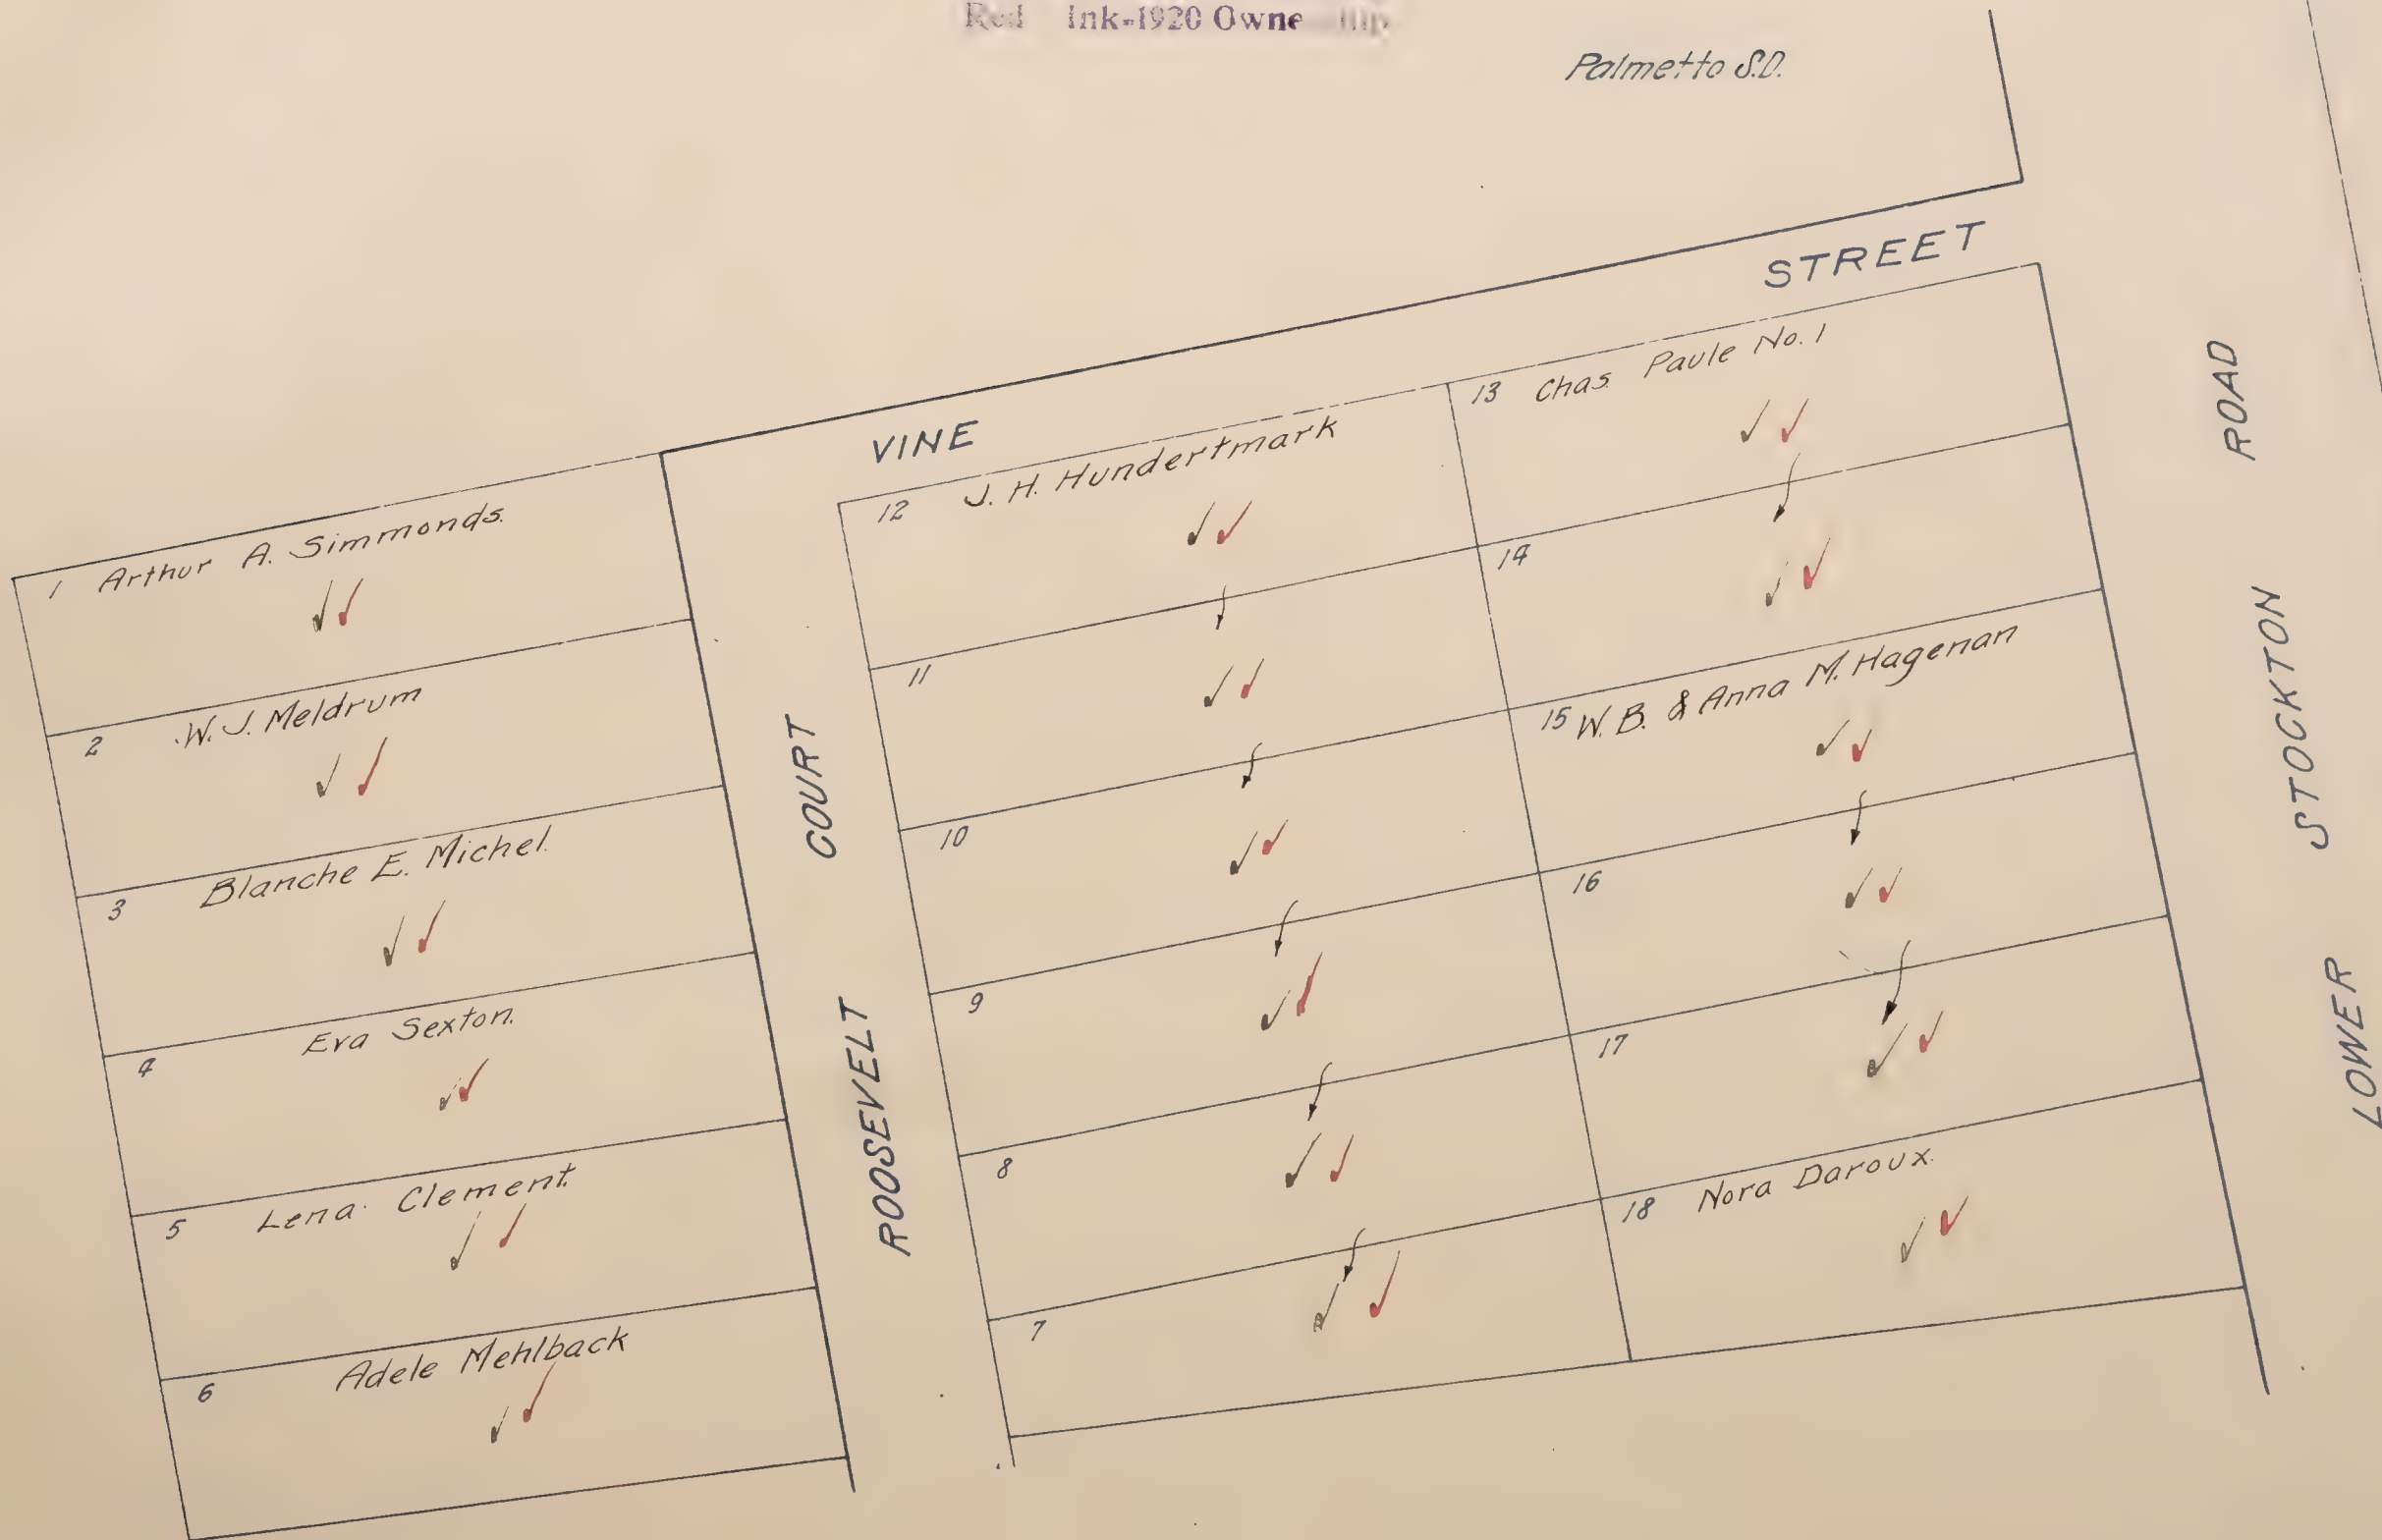

CITRUS HEIGHTS

LOCATED IN

Sec's 22 35

T.9210N R.6E

Scale 600' = 1"

*By Grant
Sept 11, 1917* 5D

All Lots 10 Acres unless otherwise noted.

GREENBACK AVENUE		AVENUE	
Thas. Lindsay	John & Grace Dexter	A.W. Leonard	Oliver Youngs Jr.
12.12 A. 1/2	11.36 A. 1/2	11.92 A. 1/2	11.09 A. 3/4
Maggie & John Odgers	cline C. Stewart	J.W. Wadsworth	Eva Armstrong
M. Matthiesen	Trainor & Desmond Est.	W.R. Wadsworth	Trainor & Desmond Est.
Bessie S. Beedle	W.R. Wadsworth	C.E. Wittenberg	
Walter E. Pratt		E.M. Thompson	
T.A. Farrell	Chas Bona	H. A. Lewis	
Mary E. Jones	J. Kochin	Samuel Sailor	
W.E. Trainor	H. A. Lewis	H. A. Lewis	
Bernhard Hellmich	J.S.K. Wile and David Brittson	David & Sophia Arnst.	
Trainor & Desmond Est.	W.E. Trainor	Martin McLaughlin	
E. G. West	C.C. Wiley	Trainor & Desmond Est.	
W.E. Trainor	W.B. Schickedanz	W.E. Trainor	
		10.03 A.	
OLIVE AVENUE		AVENUE	


Black Ink-1919 Ownership
Red Ink-1920 Ownership

CITRUS HEIGHTS ADDN.

LOCATED IN
S 1/2 of Sec 3 T.9N.R.6E
Scale: 1"=400'

Blanks to G.A. Starkweather

Summichael S.D.

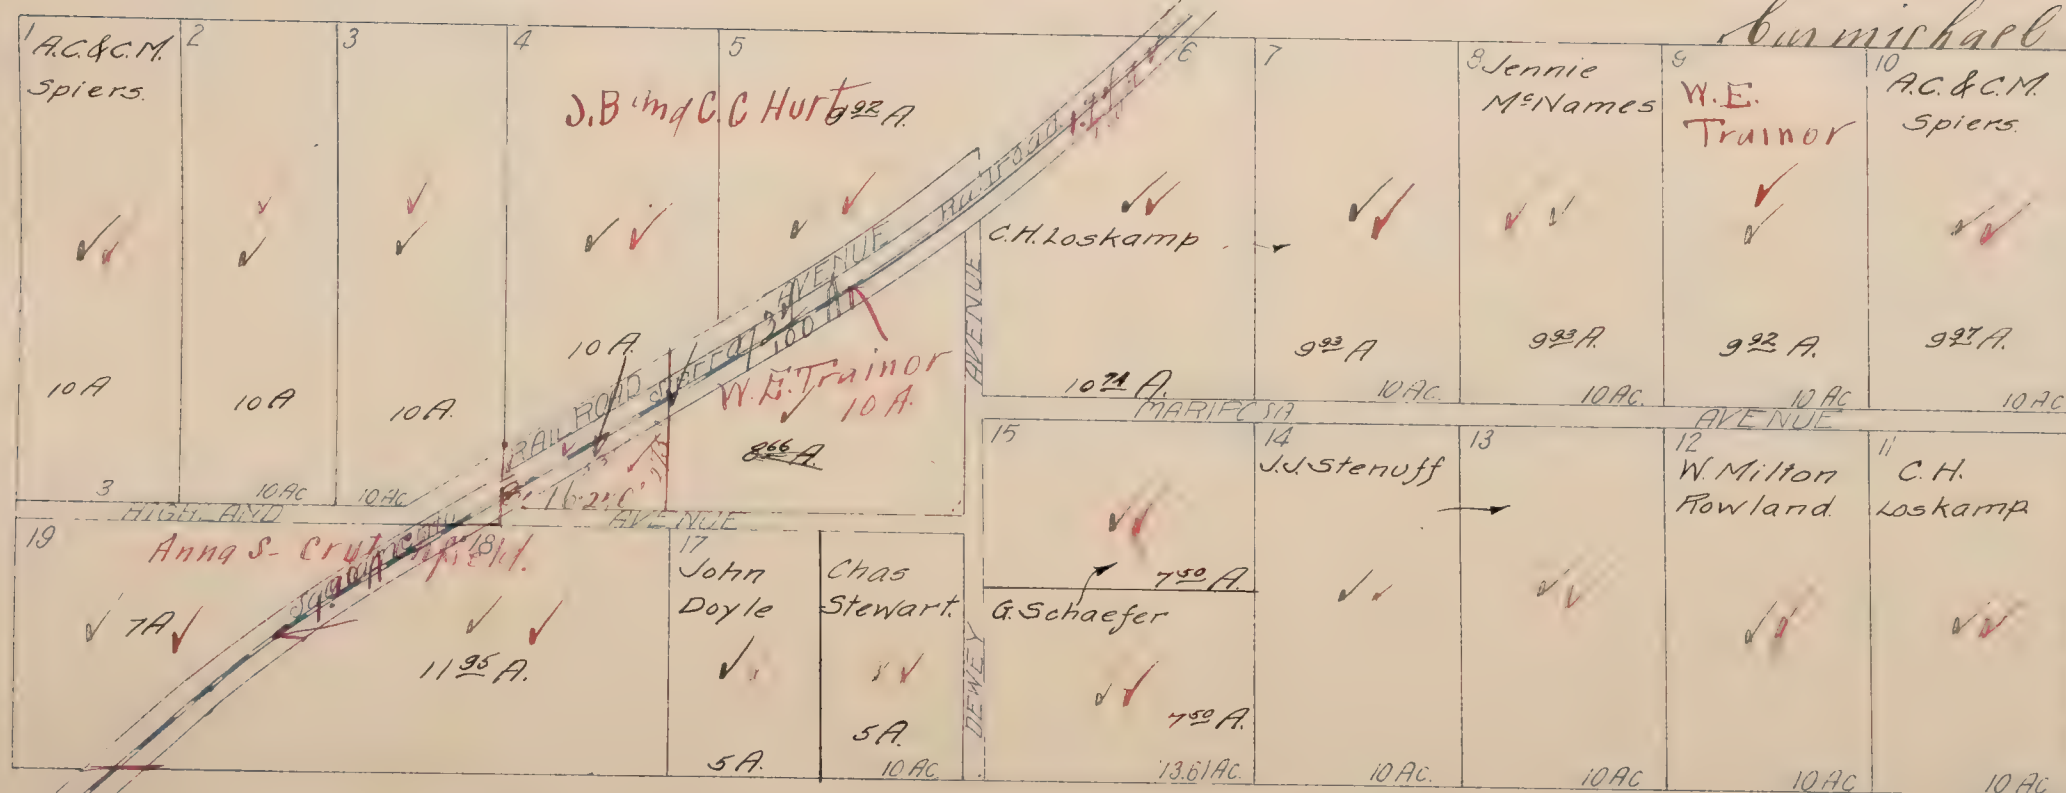


Mapped.

CITRUS HEIGHTS ADDITION N^o 2

LOCATED IN
W 1/2 of Sec. 2 T.9 N. R. 6 E.
Scale: 1"=200'

Black Ink-1919 Ownership
Red Ink-1920 Ownership


Carmichael S. D.

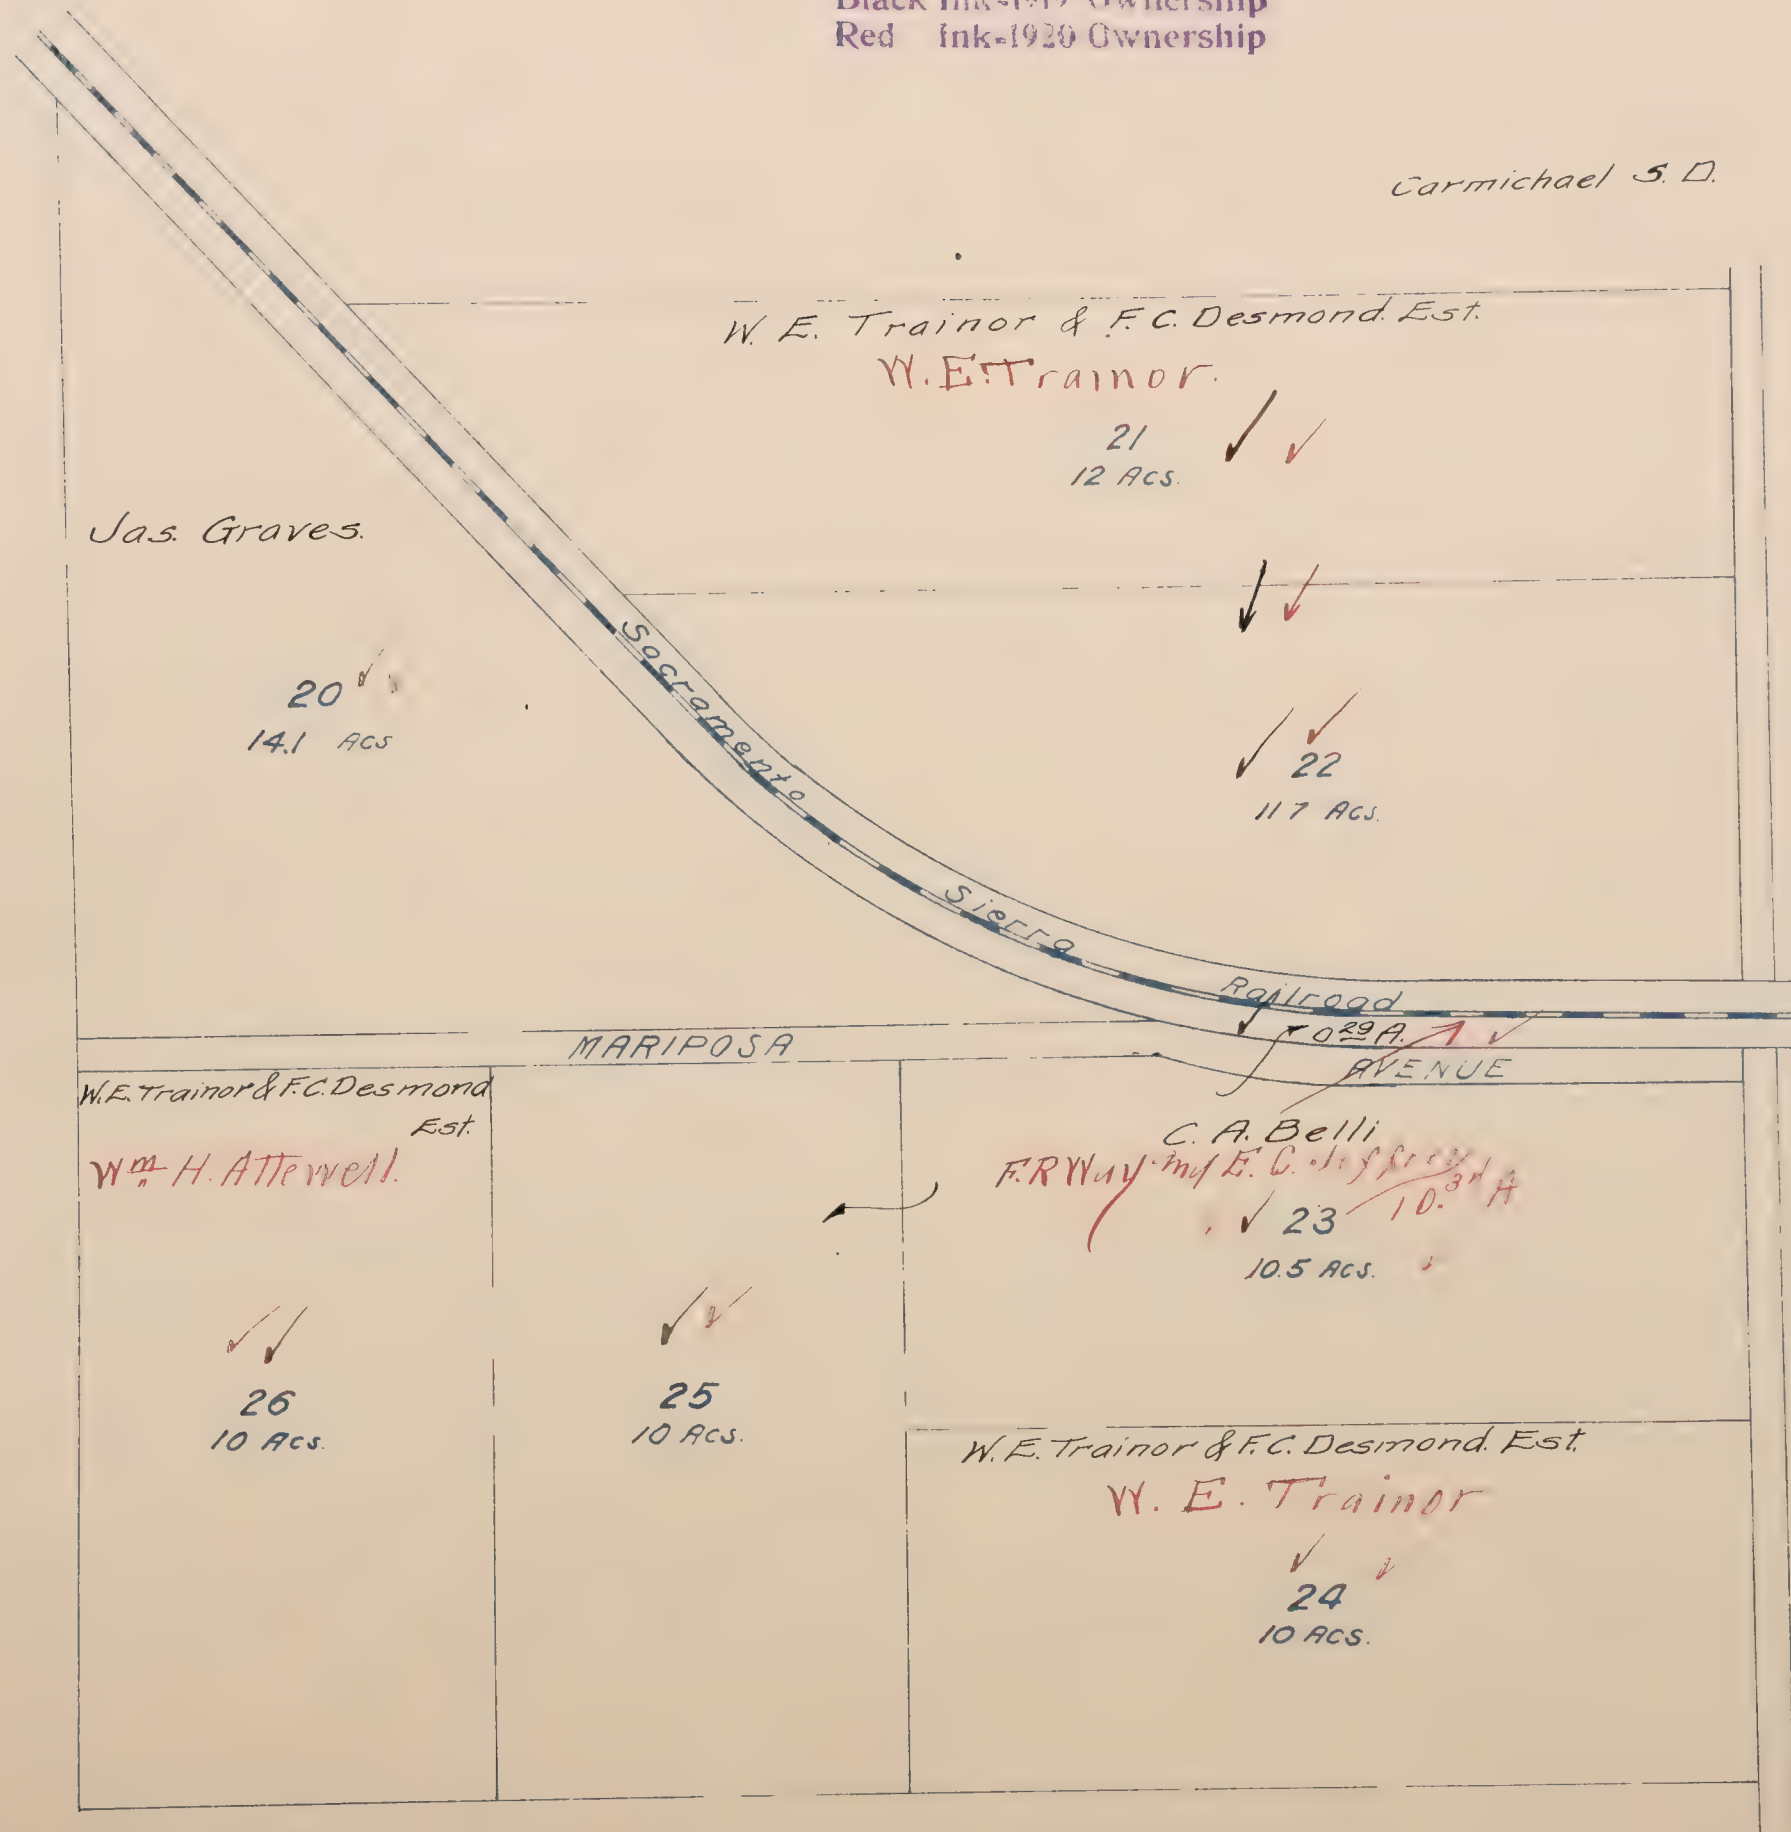

Appendix.

Black Ink-1919 Ownership
Red Ink-1920 Ownership

Sylvan S. D.

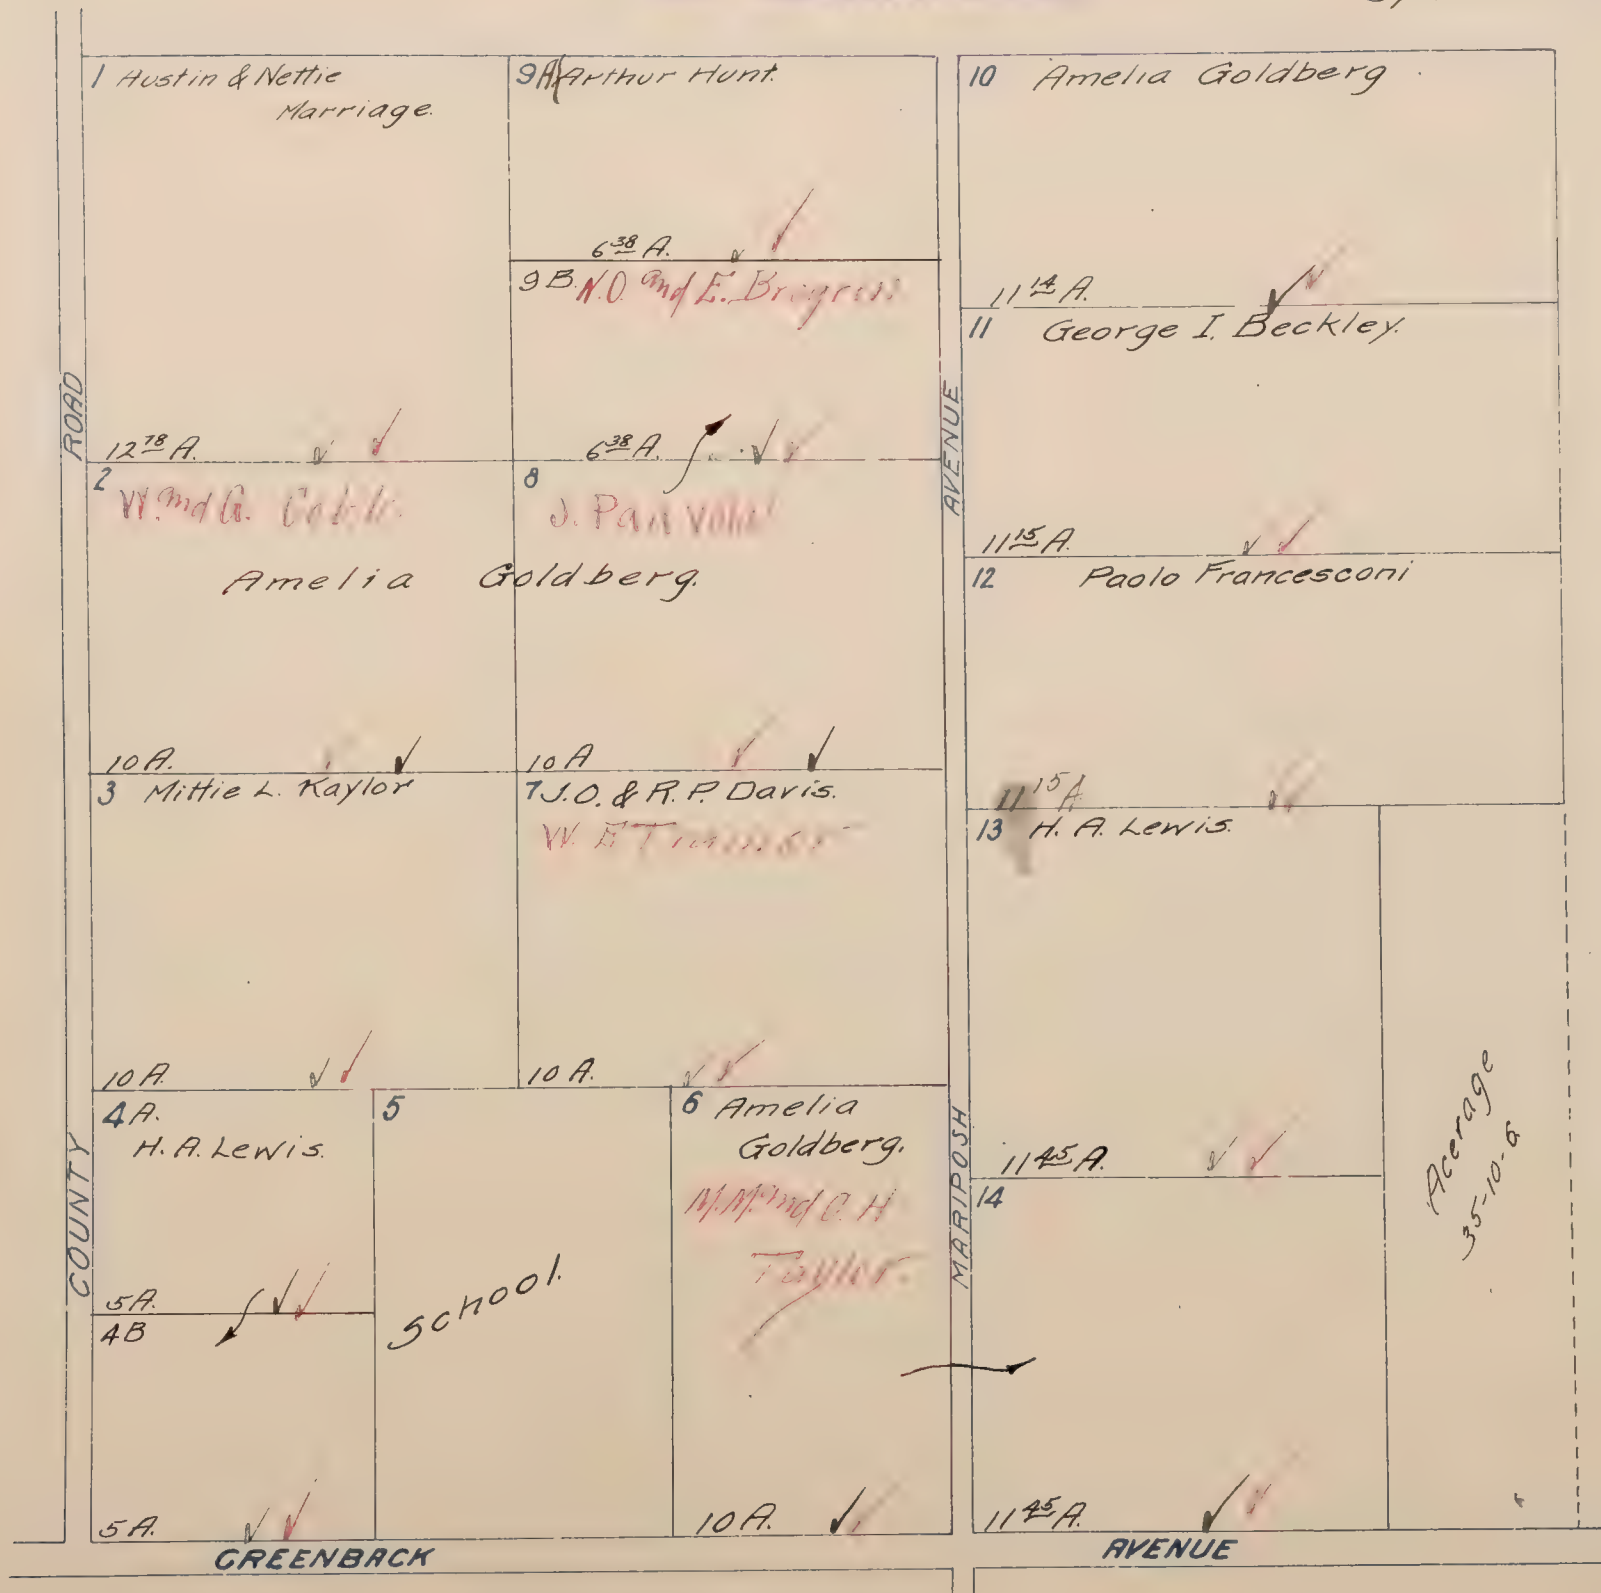

Black Ink-1919 Ownership
Red Ink-1920 Ownership

CITRUS HEIGHTS ADDITION NO. 4

LOCATED IN
S.E. 1/4 Section 6 T.9 N. R. 7 E.
Scale: 1 inch = 300 feet.


Roberts. S. II.

80 R. M. Richardson W. E. Trainor.	89	80 Margaret H. Bell.
9	89 J. O. & Rose Couture Rose Couture	81 R. W. Chattermole.
92 E. L. Burg W. E. Trainor	87 A. F. & L. Couture	82 Mattie N. Smith
93 Sam Ginnotti	86 W. S. Gregson	83 G. L. Perrin.
94 Jas. & Frank Ginotti	85 Emma Couture	84 Ray D. Meeker.
95 Joseph Broadley		

Mapped.
 Black Ink-1919 Ownership
 Red Ink-1920 Ownership
CITRUS HEIGHTS ADDITION NO. 5
 LOCATED IN
 Sections 23 24, 25 & 26, T.10N. R.6E.
 Scale 1 inch = 400 feet.

Sylvan 10

Blanks to W. E. Trainor ✓

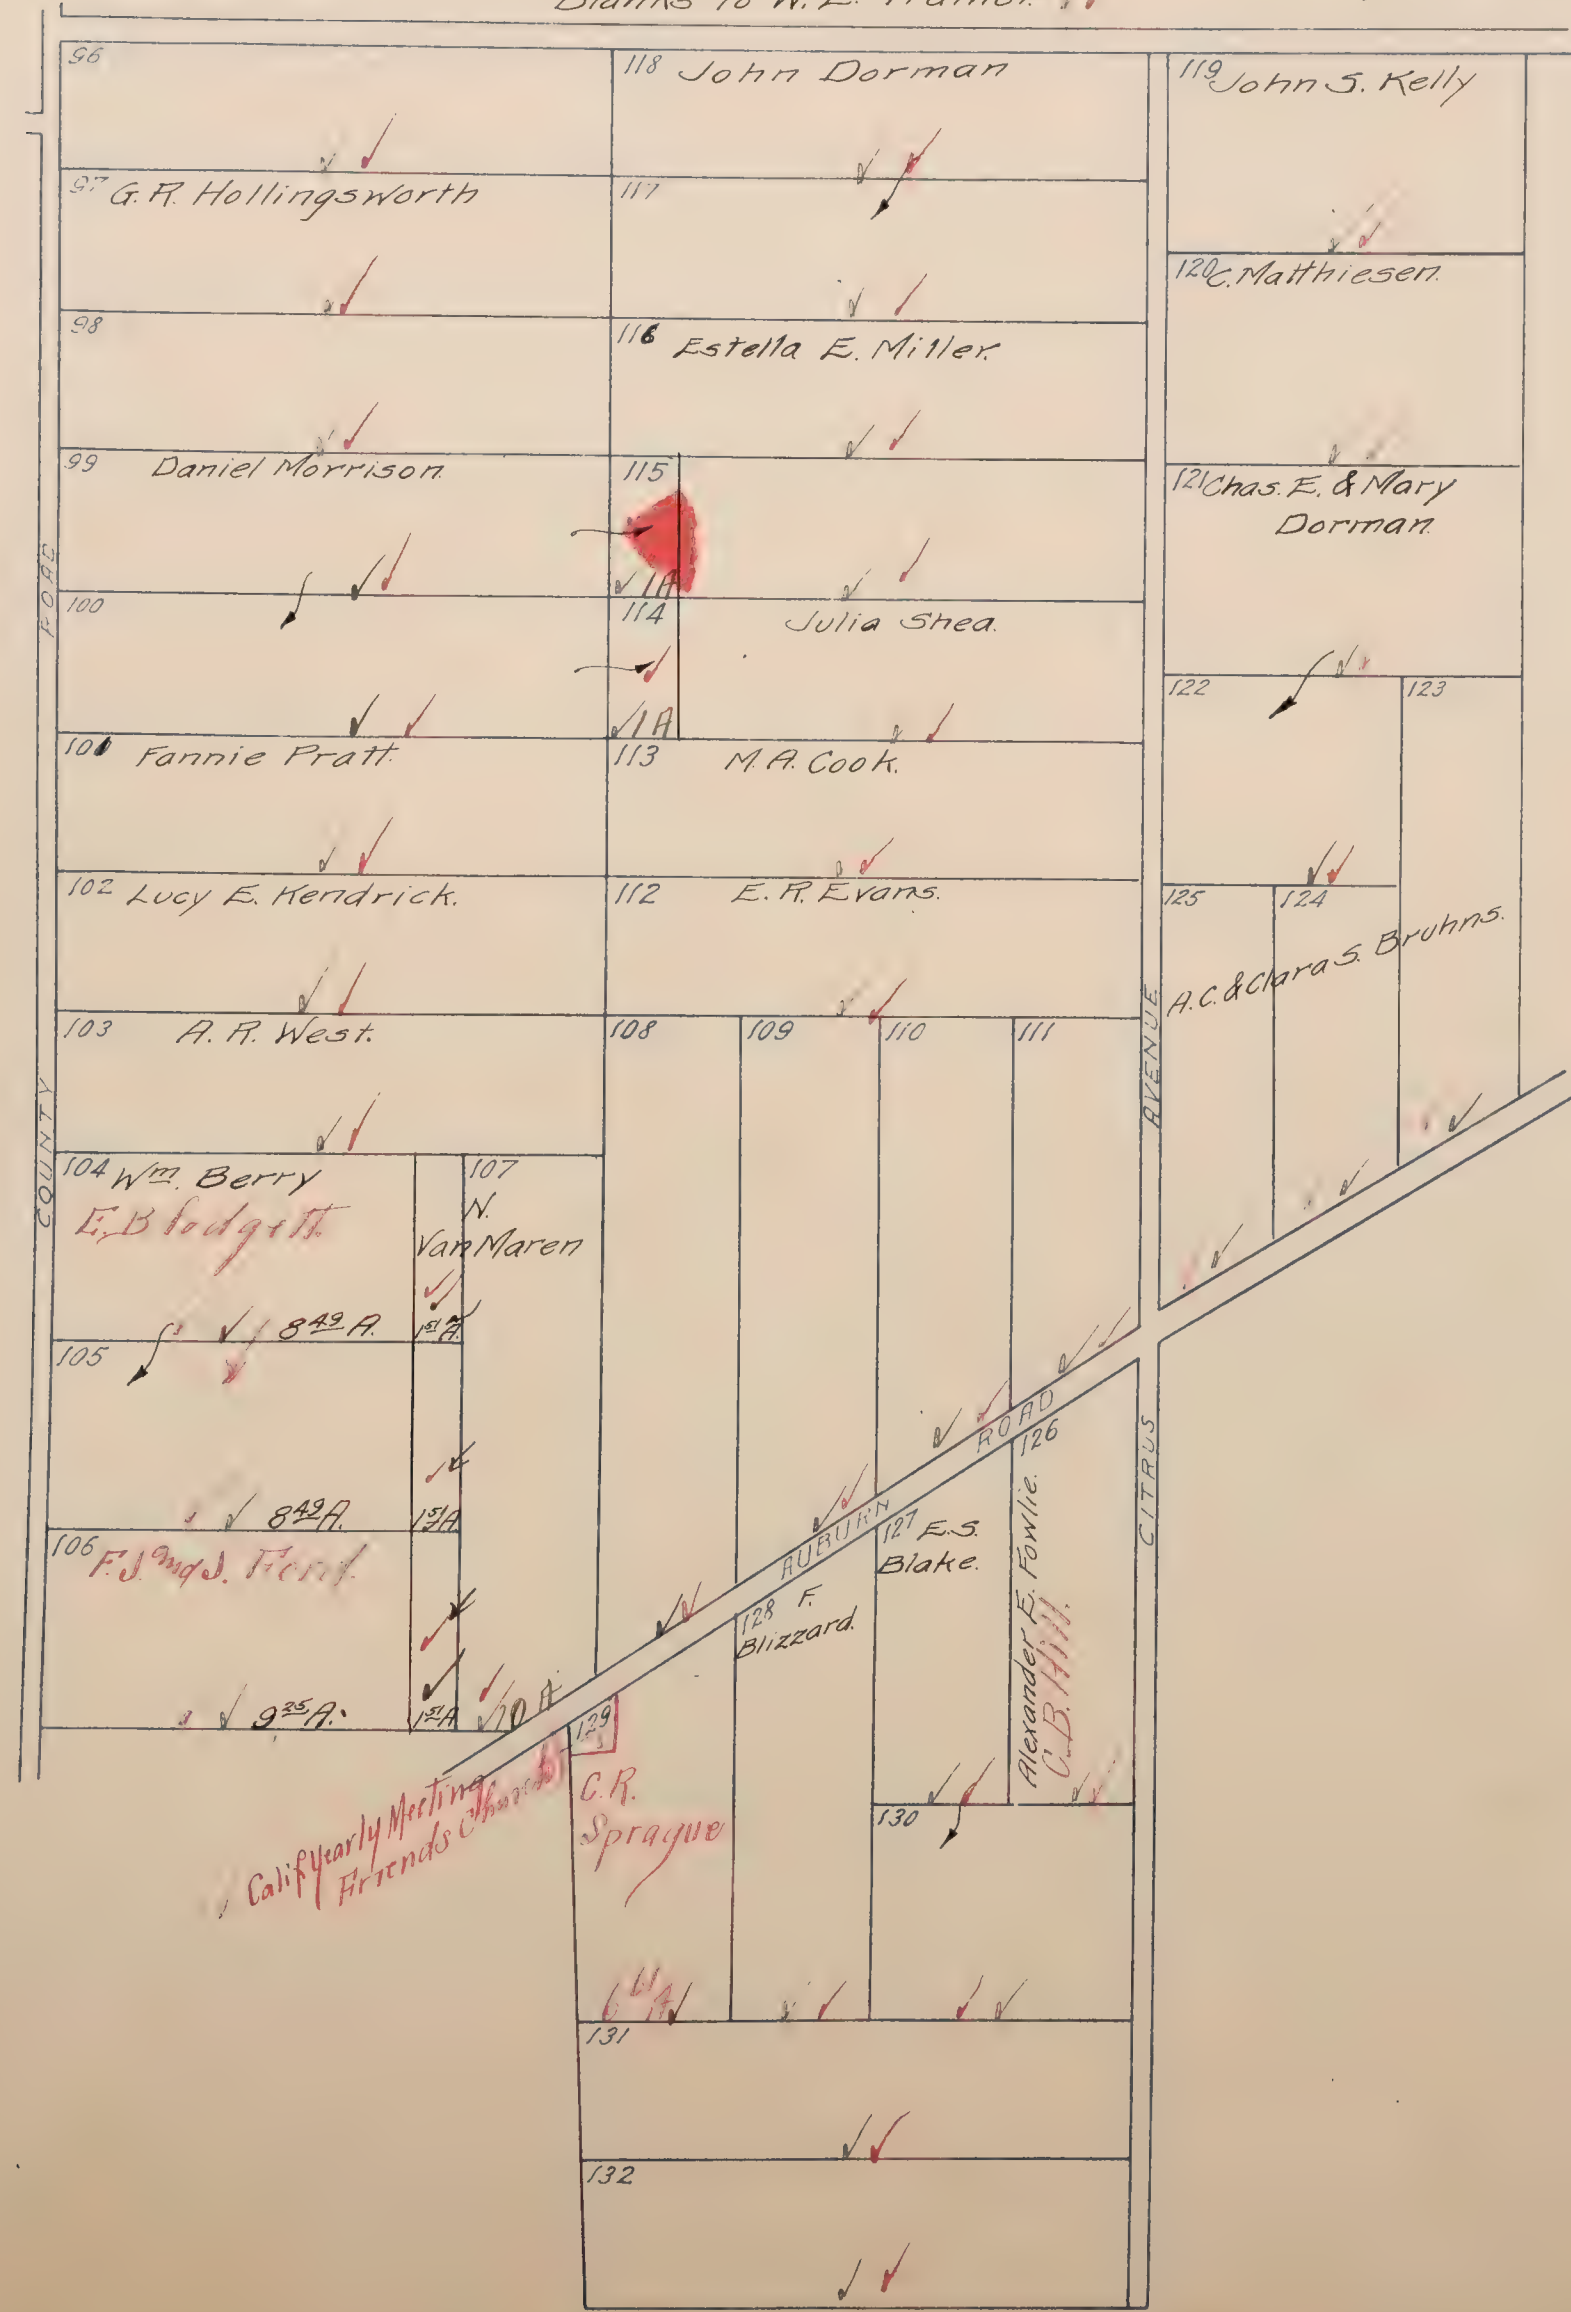

Black Ink-1919 Ownership
Red Ink-1920 Ownership

CITRUS HEIGHTS ADDITION NO. 6

BEING THE
N.E. 1/4 Section 23 T.10N.R.6E.
Scale 1 inch=200 feet.

Sylvan S.D.

Blanks to H. A. Lewis ✓
All Lots 10 Acres unless otherwise noted.

133 R. Lauppe	145 B. D. Fertig
134 H. C. Lauppe	147 W. E. Trainor. 9 ²³ A
135	146 9 ²⁰ A
136 W. E. Trainor. U. M. Taft	145 9 ²⁴ A
137	144 A. L. Lusk 9 ¹² A
138 W. E. Trainor. Everett P. Smith	143 9 ²³ A
139	142 John and Susie Lamb 9 ¹³ A
140	141 John and Maud Tarro 9 ²⁵ A
	9 ²⁵ A

CITRUS HEIGHTS ADDITION NO.7


LOCATED IN
S.W. 1/4 Section 24 T.10N.R.6E.

Scale: 1 inch = 200 feet.

Black Ink-1919 Ownership

Red Ink-1970 Ownership

Blanks to C. H. Dunn. ✓✓

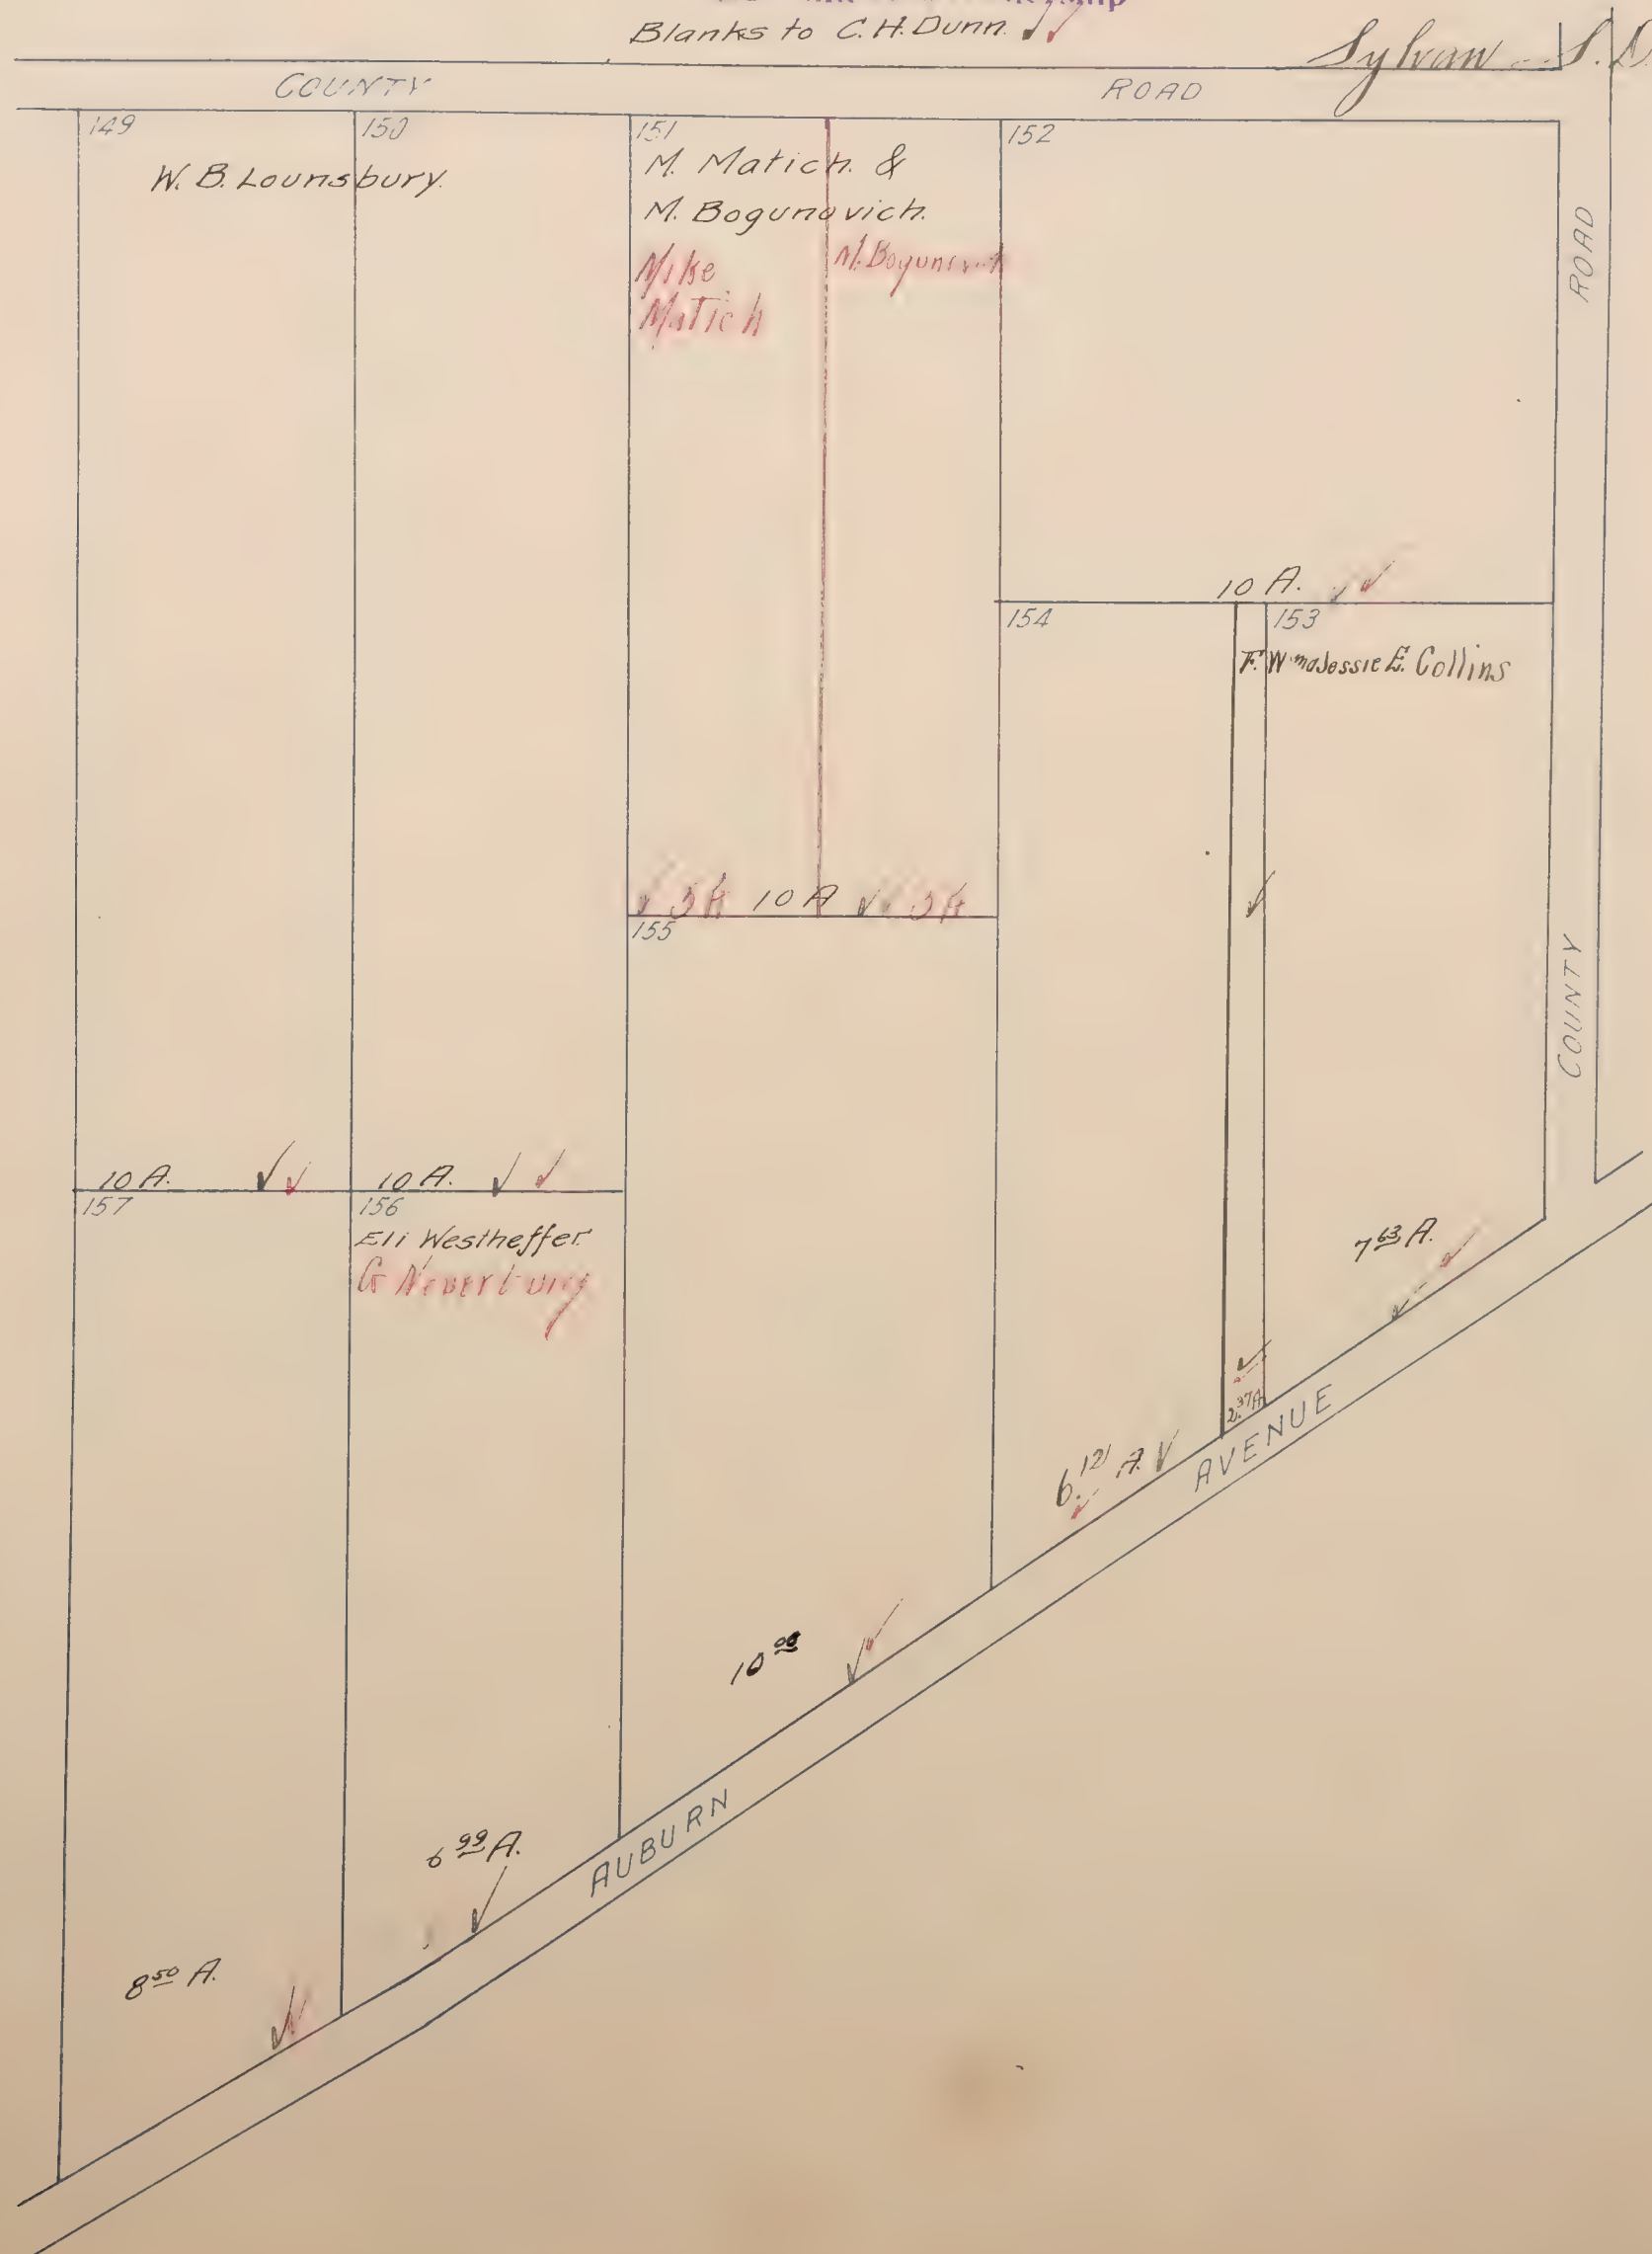


Black Ink-1919 Ownership
Red Ink-1920 Ownership

CITRUS HEIGHTS ADDITION NO. 8

LOCATED IN
S 1/2 Section 13 T.10N.R.6E.
Scale 1 inch=400 feet

Blanks to C.H. Dunn. ✓

Sylvan S.D.

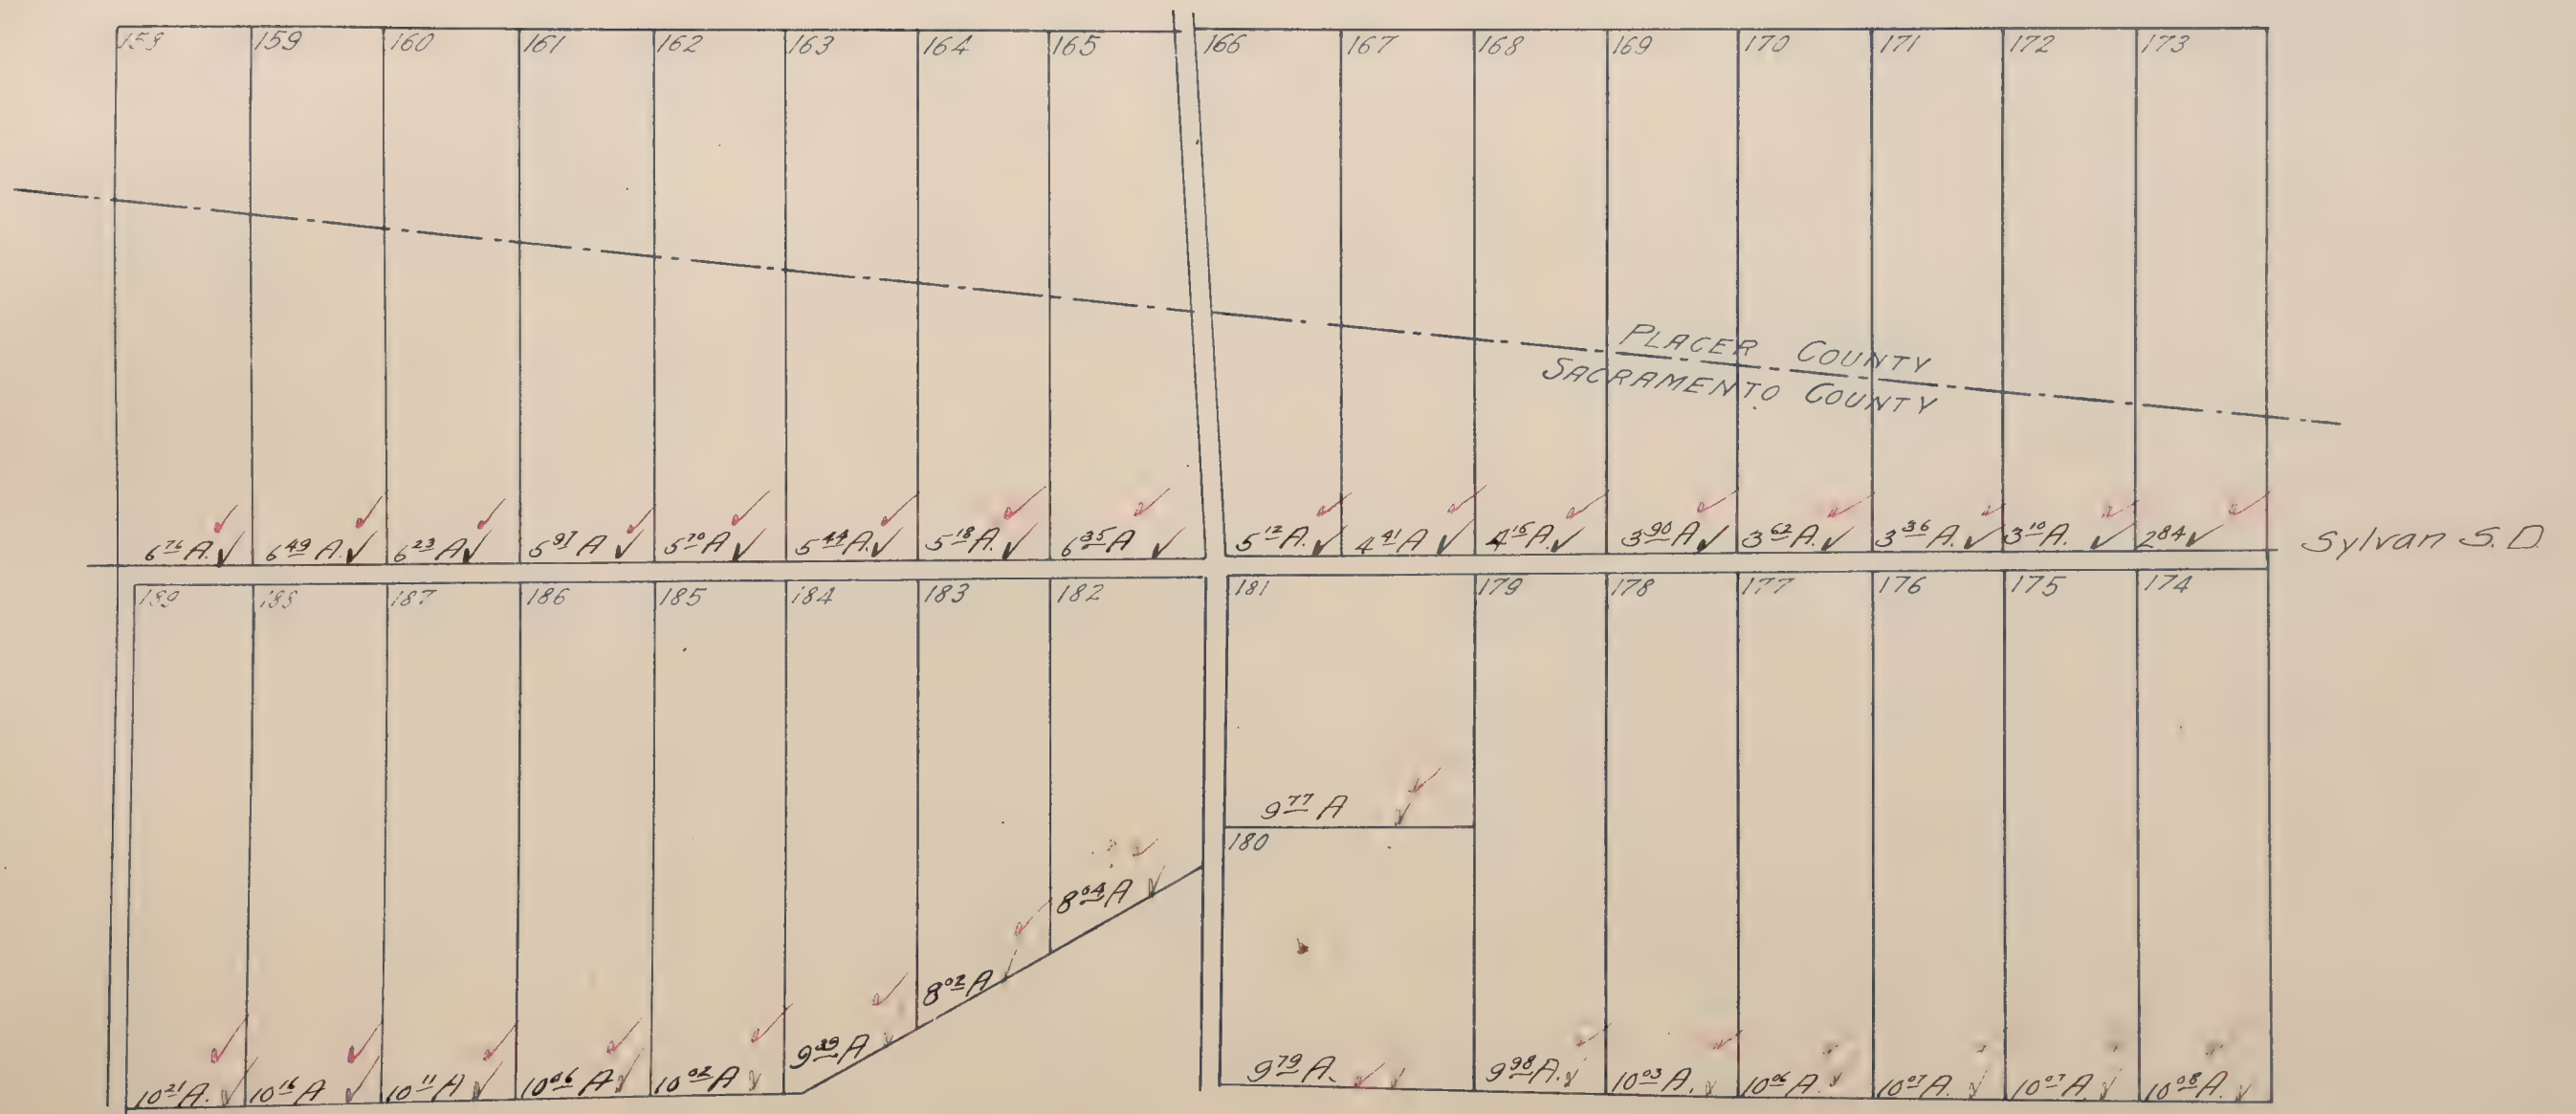


Mapped.


CITRUS HEIGHTS ADDITION NO. 9

LOCATED IN
W 1/2 Sections 24, & 25, T.10N. R.6E.
Scale: 1 inch = 300 feet.

Sylvan S.D.

Black Ink - 1919 Ownership
Red Ink - 1920 Ownership

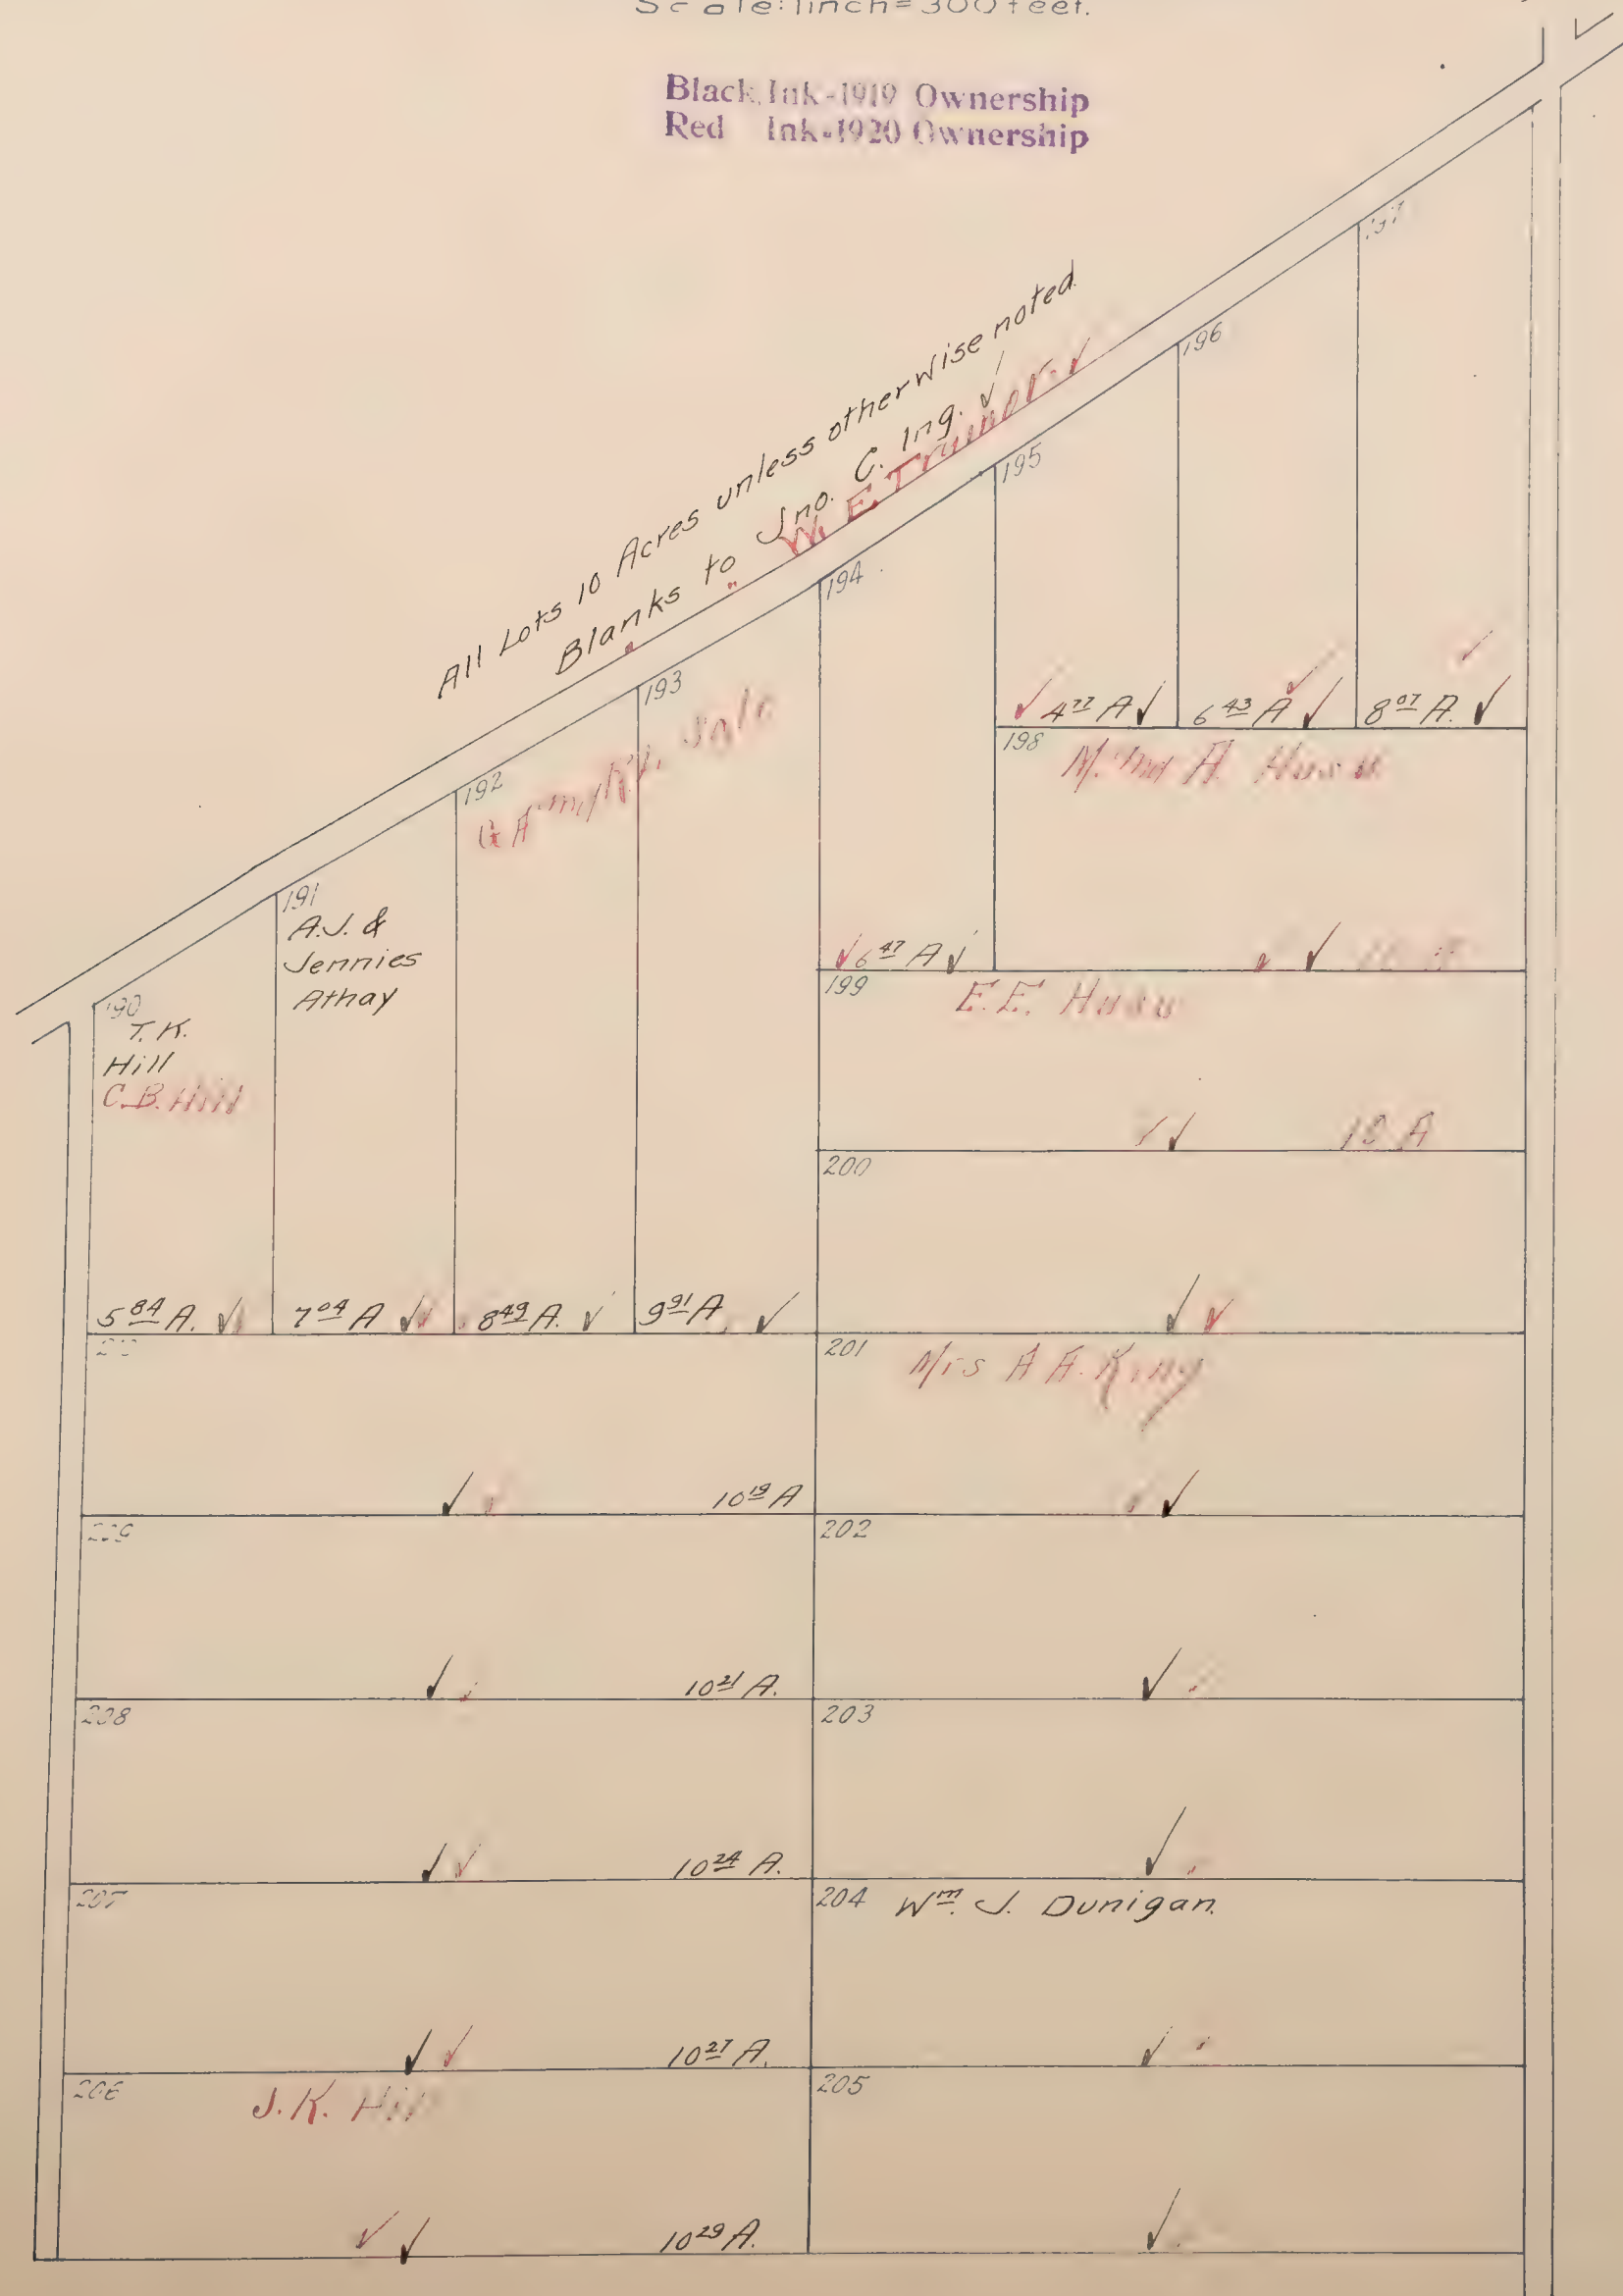


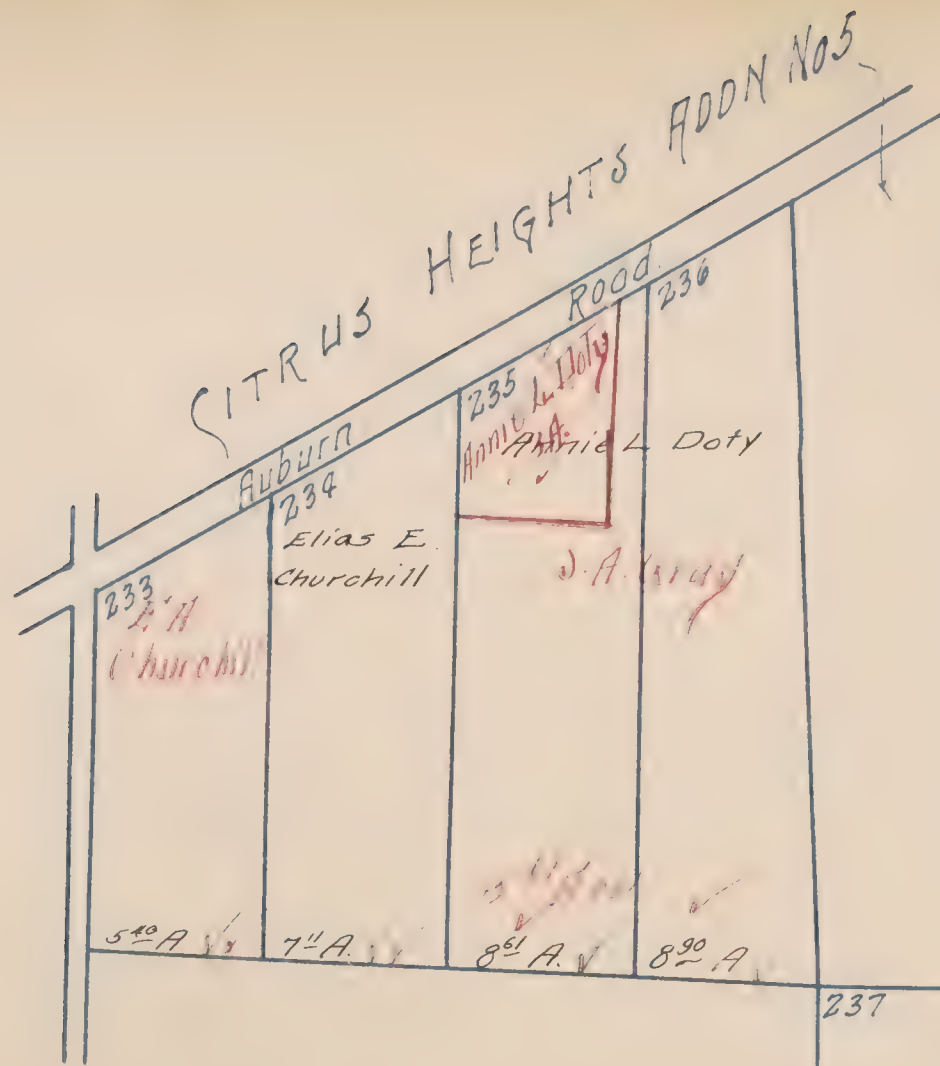

Amended
Plat
CITRUS HEIGHTS ADDN NO. 10
located in
E 1/2 of Sec 26 T. 10 N. R. 6 E.
Scale: 1" = 300'

Blanks to C. H. Dunn ✓ Sylvan S. D.

Black Ink = 1919 Ownership
Red Ink = 1920 Ownership

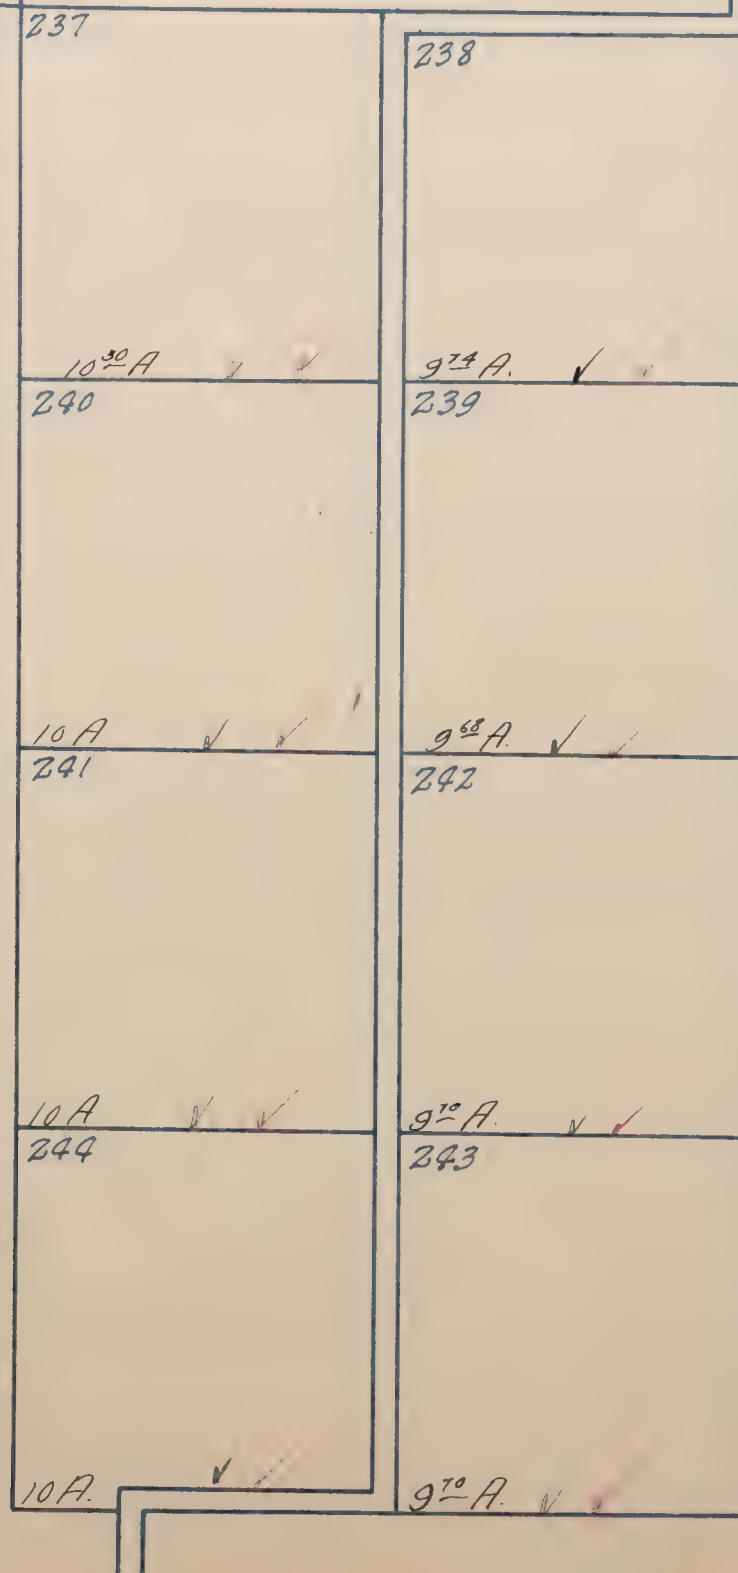

Mapped.


Black Ink-1919 Ownership
Red Ink-1920 Ownership

CITRUS HEIGHTS ADD'N No. 14

being the
N. 1/2 of N.W. 1/4 of Sec 5 T.9 N. R.7 E.
Scale: 1"=200'

Roberts S.D.

ORANGEVALE SOLONY

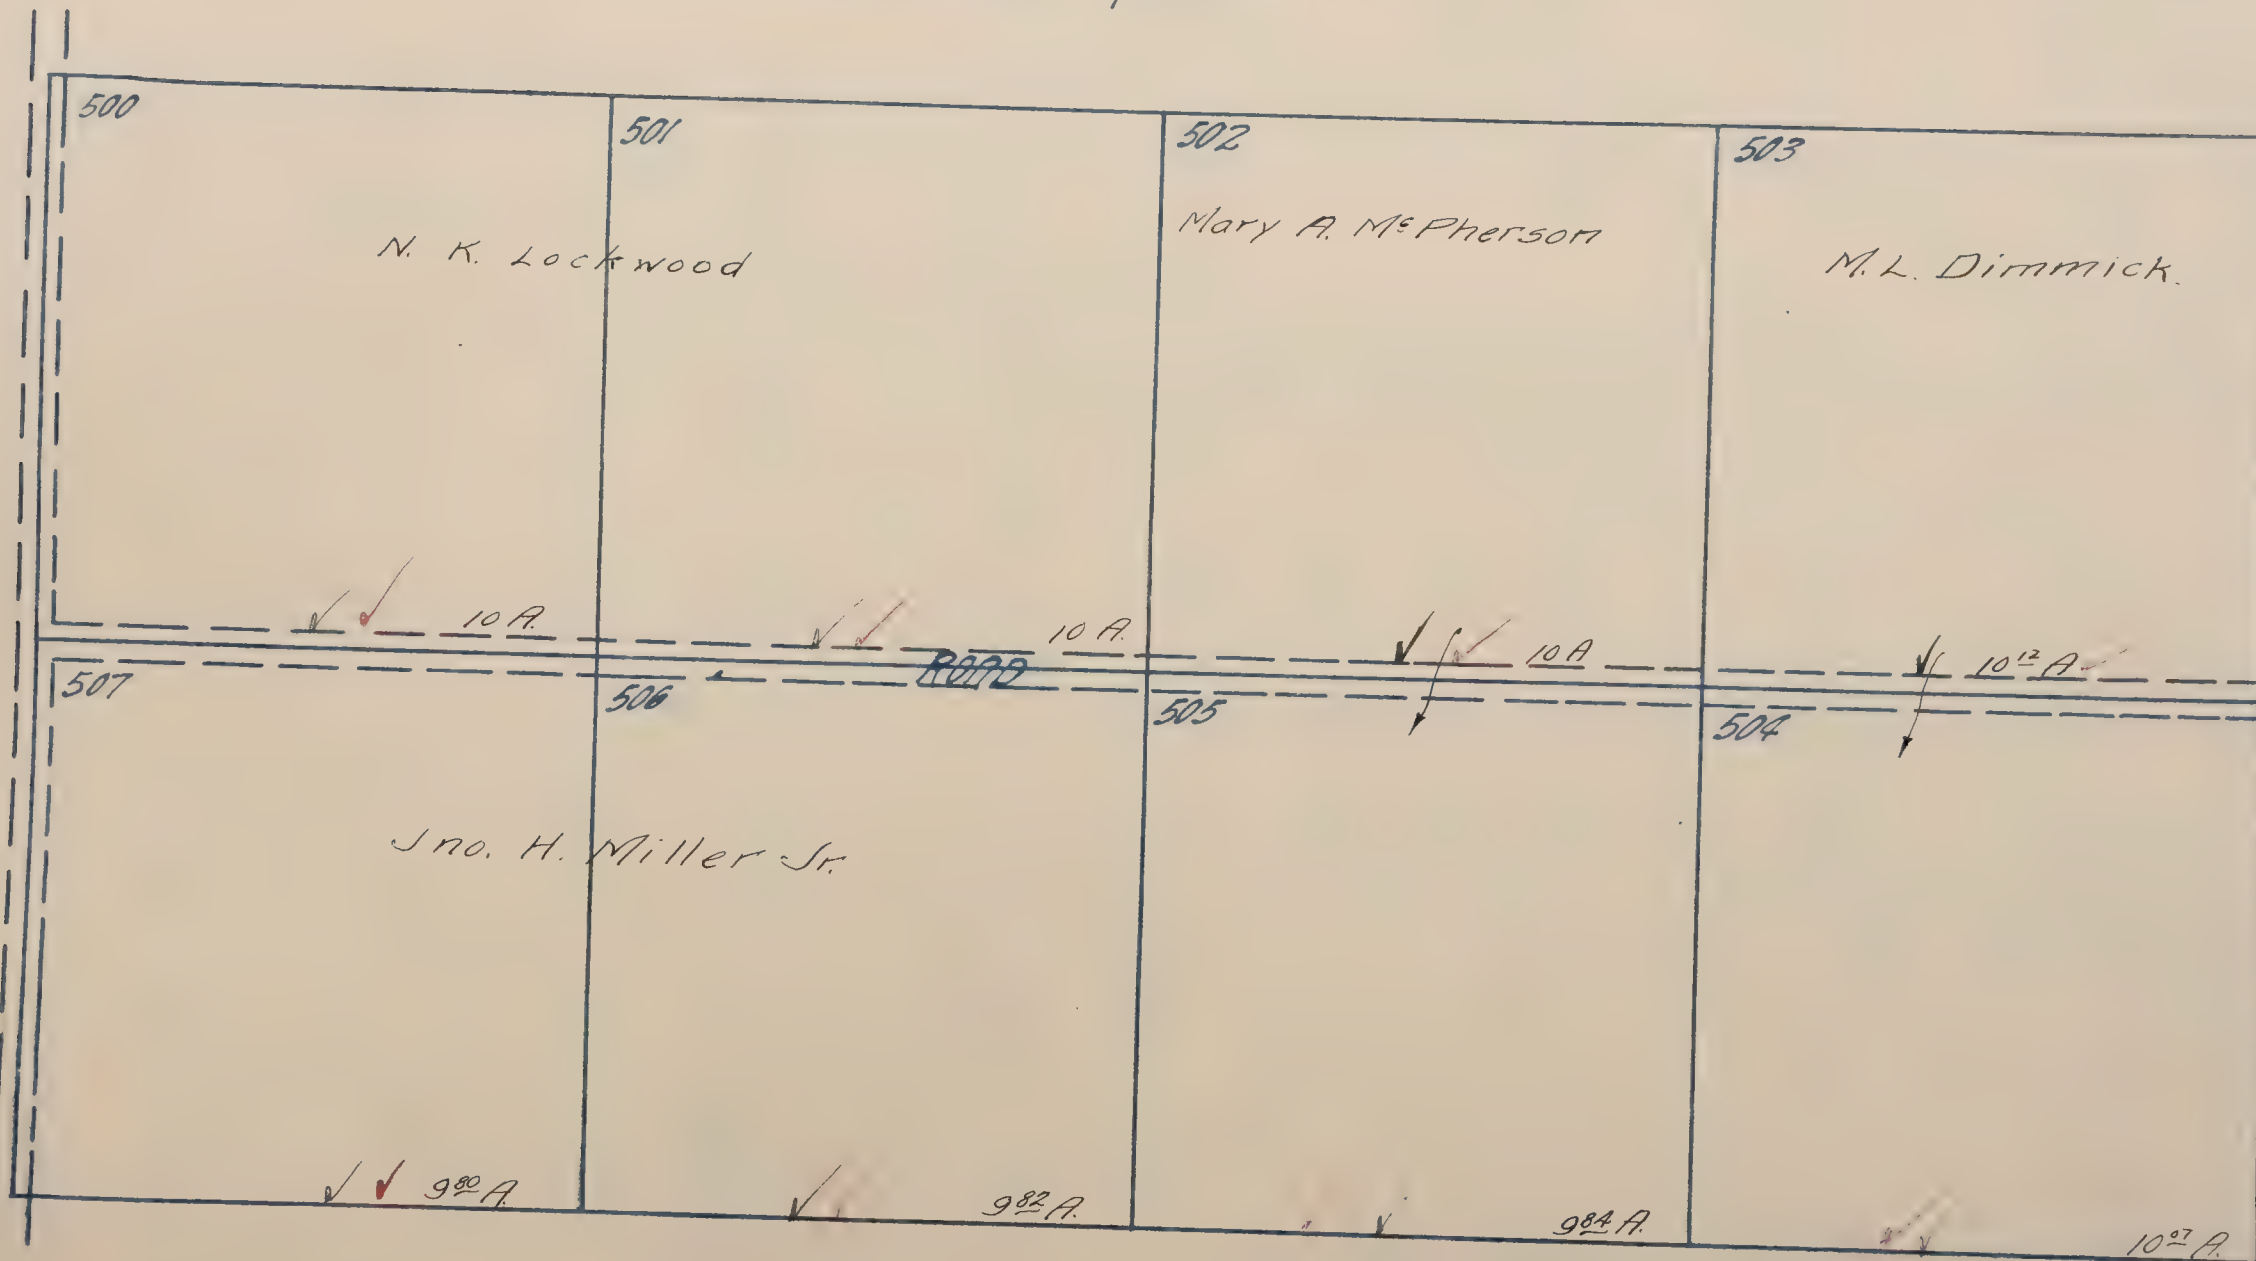

Mapped.

V/ SARMI SHAEL COLONY NO. 2







Black Ink=1919 Ownership
Red Ink=1920 Ownership

CLAY

SEC 36 T. 6. N. R. 7 E.

Scale 200 feet=lin

Laguna S.D.

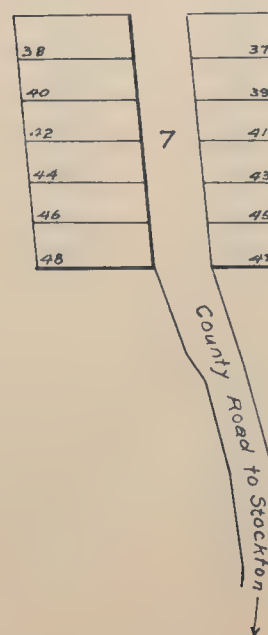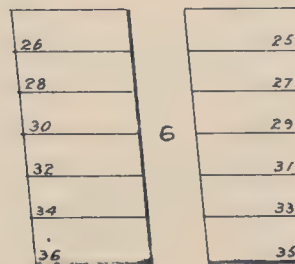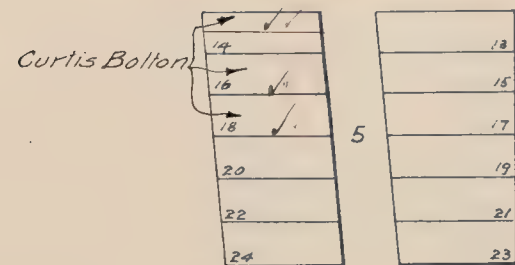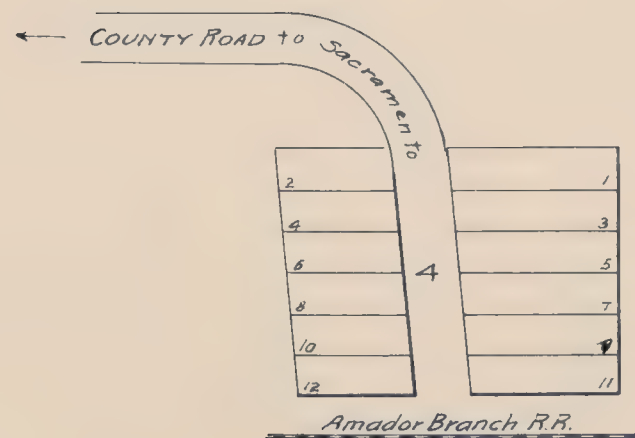

Mapped.

Black Ink-1919 Ownership
Red Ink-1920 Ownership

TOWNSITE OF CLAY

LOCATED IN
SEC. 35 & 36 T. 6. N. R. 7. E.

Blanks to Sacto. Valley Timber & Land Co. ✓
W.A.D. [unclear]

Logans - 12



Mapped.

Black Ink-1919 Ownership
Red Ink-1920 Ownership

TOWNSITE OF CLAY


LOCATED IN

SEC. 35 & 36 T.6.N.R.7E

Blanks to Sacto. Valley Timber & Land Co

W.A. Brandenburg

Lugene P.H.

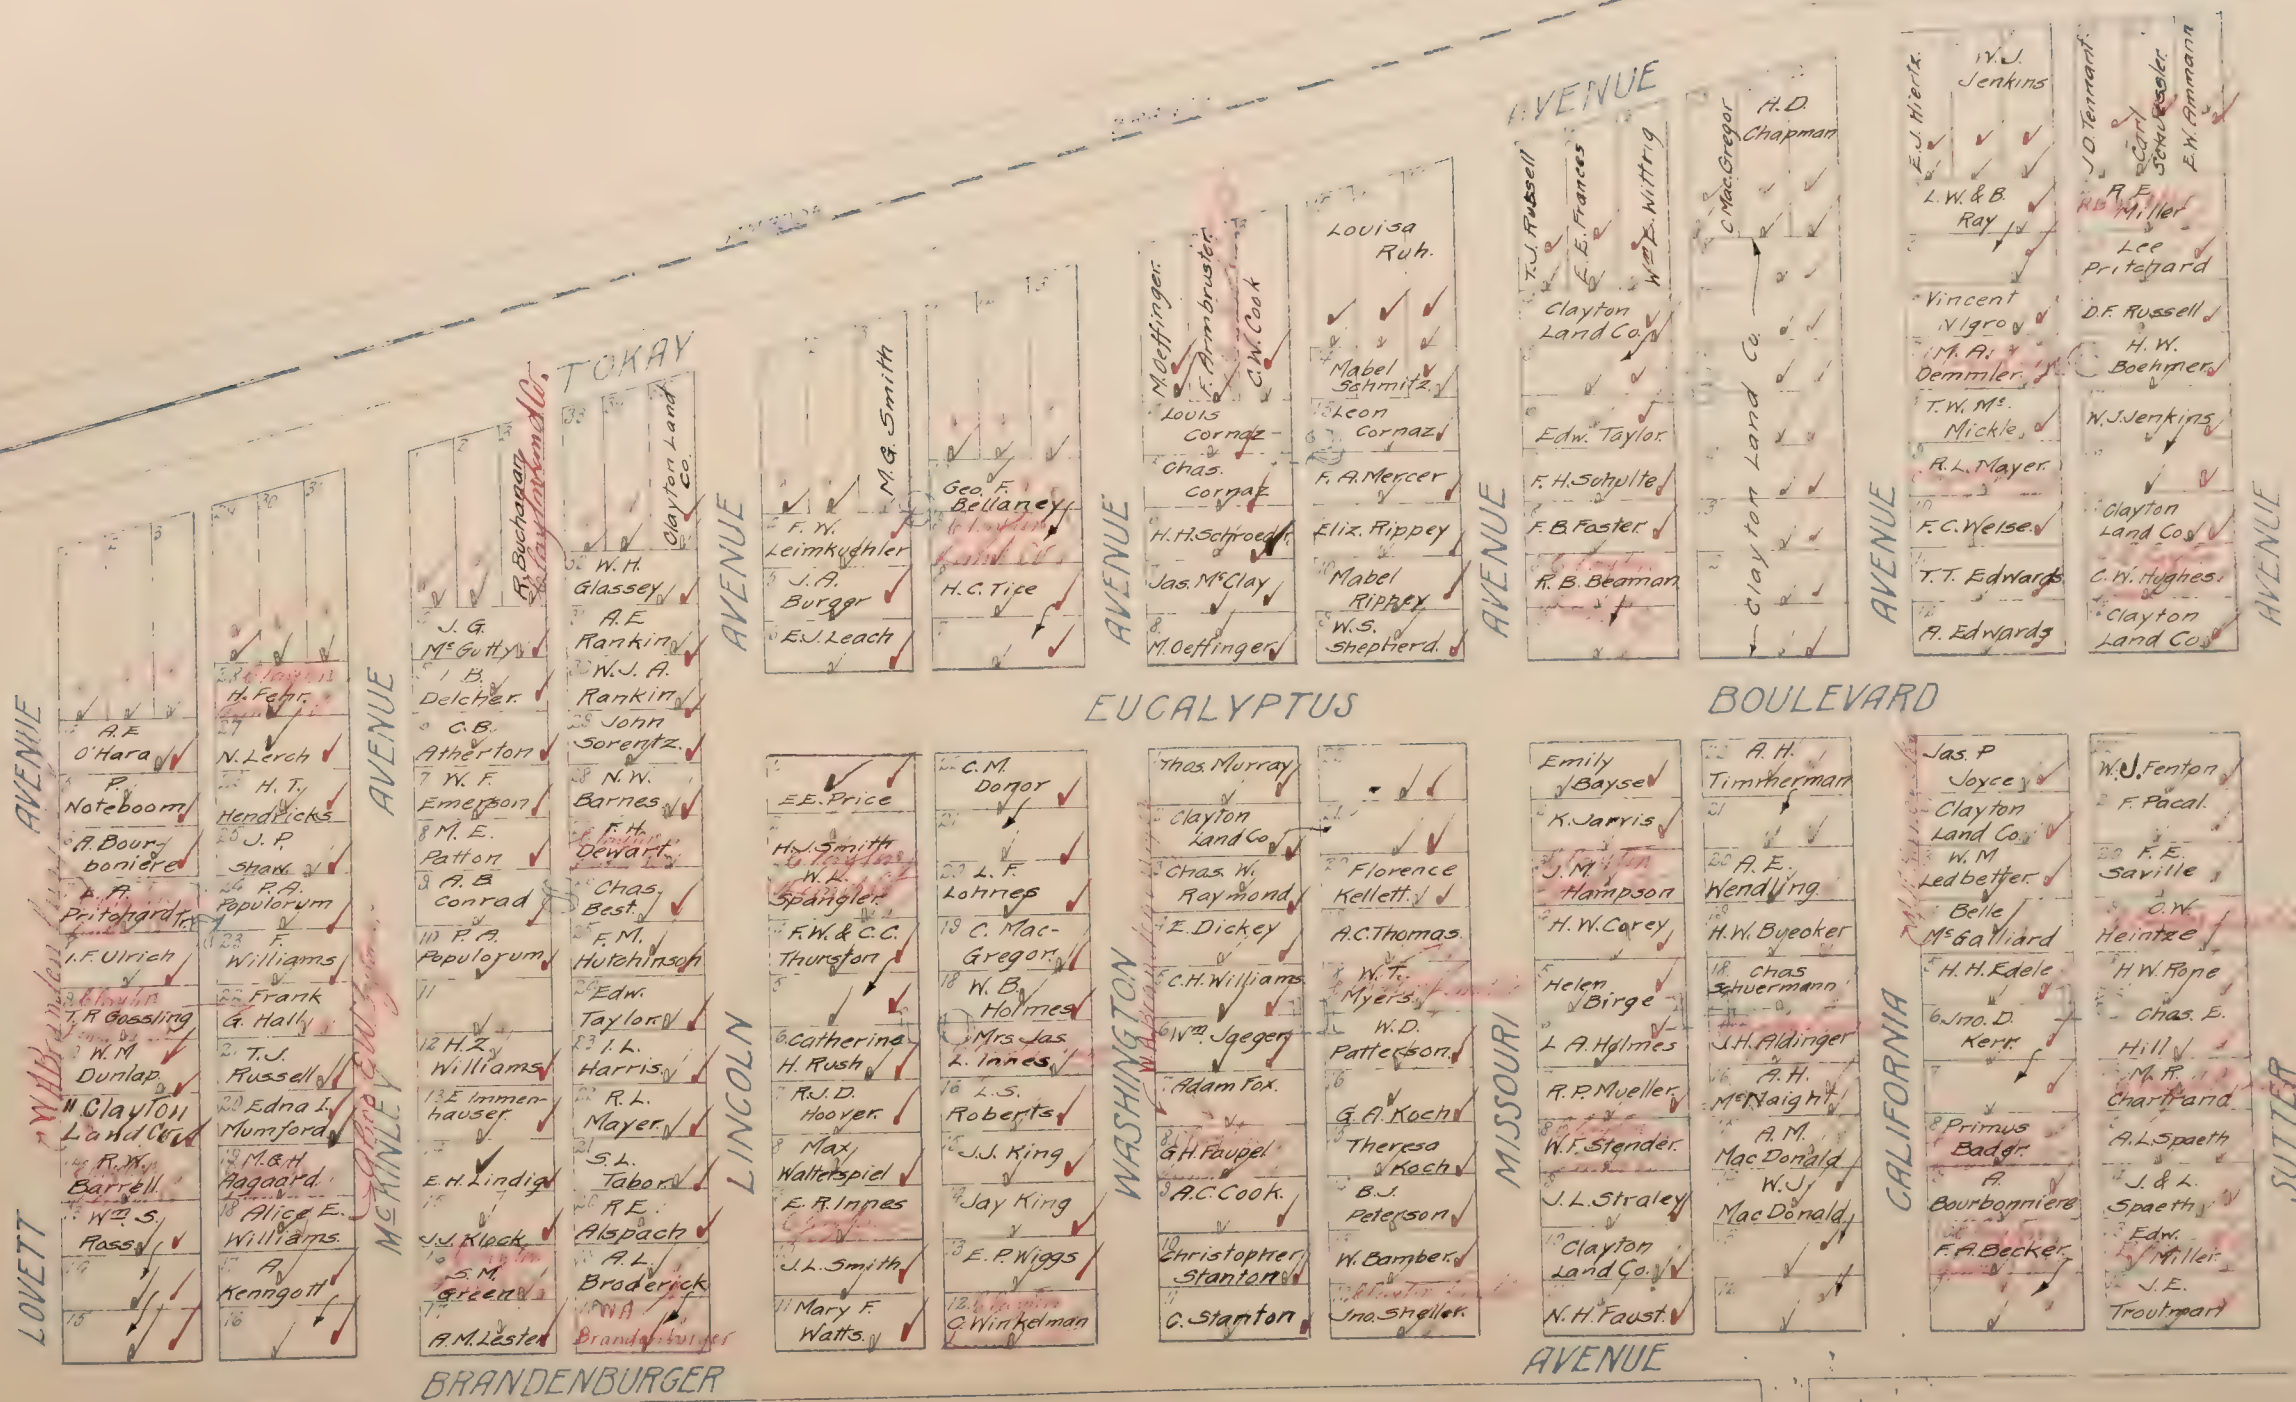

SACTO VALLEY IMPROVMENT

SUB. NO 9

TOWNSITE OF CLAY

LOCATED IN
SEC. 35 & 36 T.6.N.R.7E.

Scale: 1"=160'

Black Ink-1919 Ownership
Red Ink-1920 Ownership

Blanks to *W.H. Brandenburger*
Sacto. Valley Timber & Land Co.

Laguna

TOKAY

1 A.H. Timmerman	2	3	4 Clayton Land Co.	5 E.H. Beckwith	6 W. Holz	7 Jos. Sadwick	8 A.S. Bull	9 W. Wallace	10 H. Williams	11 Alice E. Williams	12 Julia Robertson
13 W. Dargatzade	14 W. E. Reed	15 Anna M. Spring	16 B.C. Brinkman	17 W.E. Collins	18 J.A. Burger	19 R. J. Gurrine	20	21	22	23	24 C.A. Bolton
25	26	27	28	29	30	31	32	33	34	35	36

LAGUNA

1 Ruth	2	3	4	5	6	7	8	9	10	11	12	13	14	15	16	17	18	19	20	21	22	23	24	25	26	27	28	29	30	31	32	33	34	35	36
--------	---	---	---	---	---	---	---	---	----	----	----	----	----	----	----	----	----	----	----	----	----	----	----	----	----	----	----	----	----	----	----	----	----	----	----

AVENUE

1	2	3	4	5	6	7	8	9	10	11	12	13	14	15	16	17	18	19	20	21	22	23	24	25	26	27	28	29	30	31	32	33	34	35	36
---	---	---	---	---	---	---	---	---	----	----	----	----	----	----	----	----	----	----	----	----	----	----	----	----	----	----	----	----	----	----	----	----	----	----	----

AVENUE

1	2	3	4	5	6	7	8	9	10	11	12	13	14	15	16	17	18	19	20	21	22	23	24	25	26	27	28	29	30	31	32	33	34	35	36
---	---	---	---	---	---	---	---	---	----	----	----	----	----	----	----	----	----	----	----	----	----	----	----	----	----	----	----	----	----	----	----	----	----	----	----

EUCALYPTUS

1 W.H. Sheehy	2	3	4	5	6	7	8	9	10	11	12	13	14	15	16	17	18	19	20	21	22	23	24	25	26	27	28	29	30	31	32	33	34	35	36
---------------	---	---	---	---	---	---	---	---	----	----	----	----	----	----	----	----	----	----	----	----	----	----	----	----	----	----	----	----	----	----	----	----	----	----	----

BOULEVARD

1 Geo. H. H. H. H.	2	3	4	5	6	7	8	9	10	11	12	13	14	15	16	17	18	19	20	21	22	23	24	25	26	27	28	29	30	31	32	33	34	35	36
--------------------	---	---	---	---	---	---	---	---	----	----	----	----	----	----	----	----	----	----	----	----	----	----	----	----	----	----	----	----	----	----	----	----	----	----	----

BOULEVARD

1	2	3	4	5	6	7	8	9	10	11	12	13	14	15	16	17	18	19	20	21	22	23	24	25	26	27	28	29	30	31	32	33	34	35	36
---	---	---	---	---	---	---	---	---	----	----	----	----	----	----	----	----	----	----	----	----	----	----	----	----	----	----	----	----	----	----	----	----	----	----	----

AVENUE

1	2	3	4	5	6	7	8	9	10	11	12	13	14	15	16	17	18	19	20	21	22	23	24	25	26	27	28	29	30	31	32	33	34	35	36
---	---	---	---	---	---	---	---	---	----	----	----	----	----	----	----	----	----	----	----	----	----	----	----	----	----	----	----	----	----	----	----	----	----	----	----

BRANDENBURGER

1	2	3	4	5	6	7	8	9	10	11	12	13	14	15	16	17	18	19	20	21	22	23	24	25	26	27	28	29	30	31	32	33	34	35	36
---	---	---	---	---	---	---	---	---	----	----	----	----	----	----	----	----	----	----	----	----	----	----	----	----	----	----	----	----	----	----	----	----	----	----	----

ST LOUIS

1	2	3	4	5	6	7	8	9	10	11	12	13	14	15	16	17	18	19	20	21	22	23	24	25	26	27	28	29	30	31	32	33	34	35	36
---	---	---	---	---	---	---	---	---	----	----	----	----	----	----	----	----	----	----	----	----	----	----	----	----	----	----	----	----	----	----	----	----	----	----	----

DUFFY

1	2	3	4	5	6	7	8	9	10	11	12	13	14	15	16	17	18	19	20	21	22	23	24	25	26	27	28	29	30	31	32	33	34	35	36
---	---	---	---	---	---	---	---	---	----	----	----	----	----	----	----	----	----	----	----	----	----	----	----	----	----	----	----	----	----	----	----	----	----	----	----

AVENUE

1	2	3	4	5	6	7	8	9	10	11	12	13	14	15	16	17	18	19	20	21	22	23	24	25	26	27	28	29	30	31	32	33	34	35	36
---	---	---	---	---	---	---	---	---	----	----	----	----	----	----	----	----	----	----	----	----	----	----	----	----	----	----	----	----	----	----	----	----	----	----	----

VERDIER

1	2	3	4	5	6	7	8	9	10	11	12	13	14	15	16	17	18	19	20	21	22	23	24	25	26	27	28	29	30	31	32	33	34	35	36
---	---	---	---	---	---	---	---	---	----	----	----	----	----	----	----	----	----	----	----	----	----	----	----	----	----	----	----	----	----	----	----	----	----	----	----

MS KEE

1	2	3	4	5	6	7	8	9	10	11	12	13	14	15	16	17	18	19	20	21	22	23	24	25	26	27	28	29	30	31	32	33	34	35	36
---	---	---	---	---	---	---	---	---	----	----	----	----	----	----	----	----	----	----	----	----	----	----	----	----	----	----	----	----	----	----	----	----	----	----	----

AVENUE

1	2	3	4	5	6	7	8	9	10	11	12	13	14	15	16	17	18	19	20	21	22	23	24	25	26	27	28	29	30	31	32	33	34	35	36
---	---	---	---	---	---	---	---	---	----	----	----	----	----	----	----	----	----	----	----	----	----	----	----	----	----	----	----	----	----	----	----	----	----	----	----

AVENUE

1	2	3	4	5	6	7	8	9	10	11	12	13	14	15	16	17	18	19	20	21	22	23	24	25	26	27	28	29	30	31	32	33	34	35	36
---	---	---	---	---	---	---	---	---	----	----	----	----	----	----	----	----	----	----	----	----	----	----	----	----	----	----	----	----	----	----	----	----	----	----	----

SAC VALLEY IMPROVEMENT
ENTICOS SUEE. NO 9

SAC VALLEY IMPROVEMENT

ON PAGES 300

Mappea

CLOVERDALE

LOCATED IN
SECTION 29 T.8 N. R. 5 E.

Black Ink-1919 Ownership
Red Ink-1920 Ownership

Scale 200 feet = 1 inch

Wm. R. Goldberg S.D.

FRUITRIDGE ROAD											
1	2	3	4	5	6	7	8	9	10	11	12
L.R. Plate		Mary	Erwin			P.R. & J.W. Smith	Henry Hansen		Delno L. Mullin		P.R. & J.W. Smith
56							Francisco				13
1 Acre.							Rodriguez				1 Acre.
55											14
1 Acre.											1 Acre.
54											15
53							Unknown Owners.		Jas. M ^o Dougall		16
52							H.T. Hatch				17
51							Samuel J. Jacobs				18
50									H.J. Goethe		19
49											20
48											21
47											22
46											23
45											24
44											25
43											26
42											27
41											28
40											29
39											30
38											31
37											32
36							W.E. Laro				33
35											34

BOULEVARD

DEWEY

See Cloverdale Park

Black Ink-1919 Ownership
Red Ink-1920 Ownership

CLOVER DALE PARK

LOCATED IN
N.E 1/4 of Sec 29 T8N.R5E
Scale: 50' = 1"

Blanks assessed to Fleming & Walter.

Front Ridge
E. side of S.D.



Mapped.

COFFING OAKS

located in

Section 23- T.7N. R.6E.


Scale: 1"=200ft

Pleasant Grove SD.

Black Ink-1919 Ownership

Red Ink-1920 Ownership

Blank to C. C. Coffing ✓

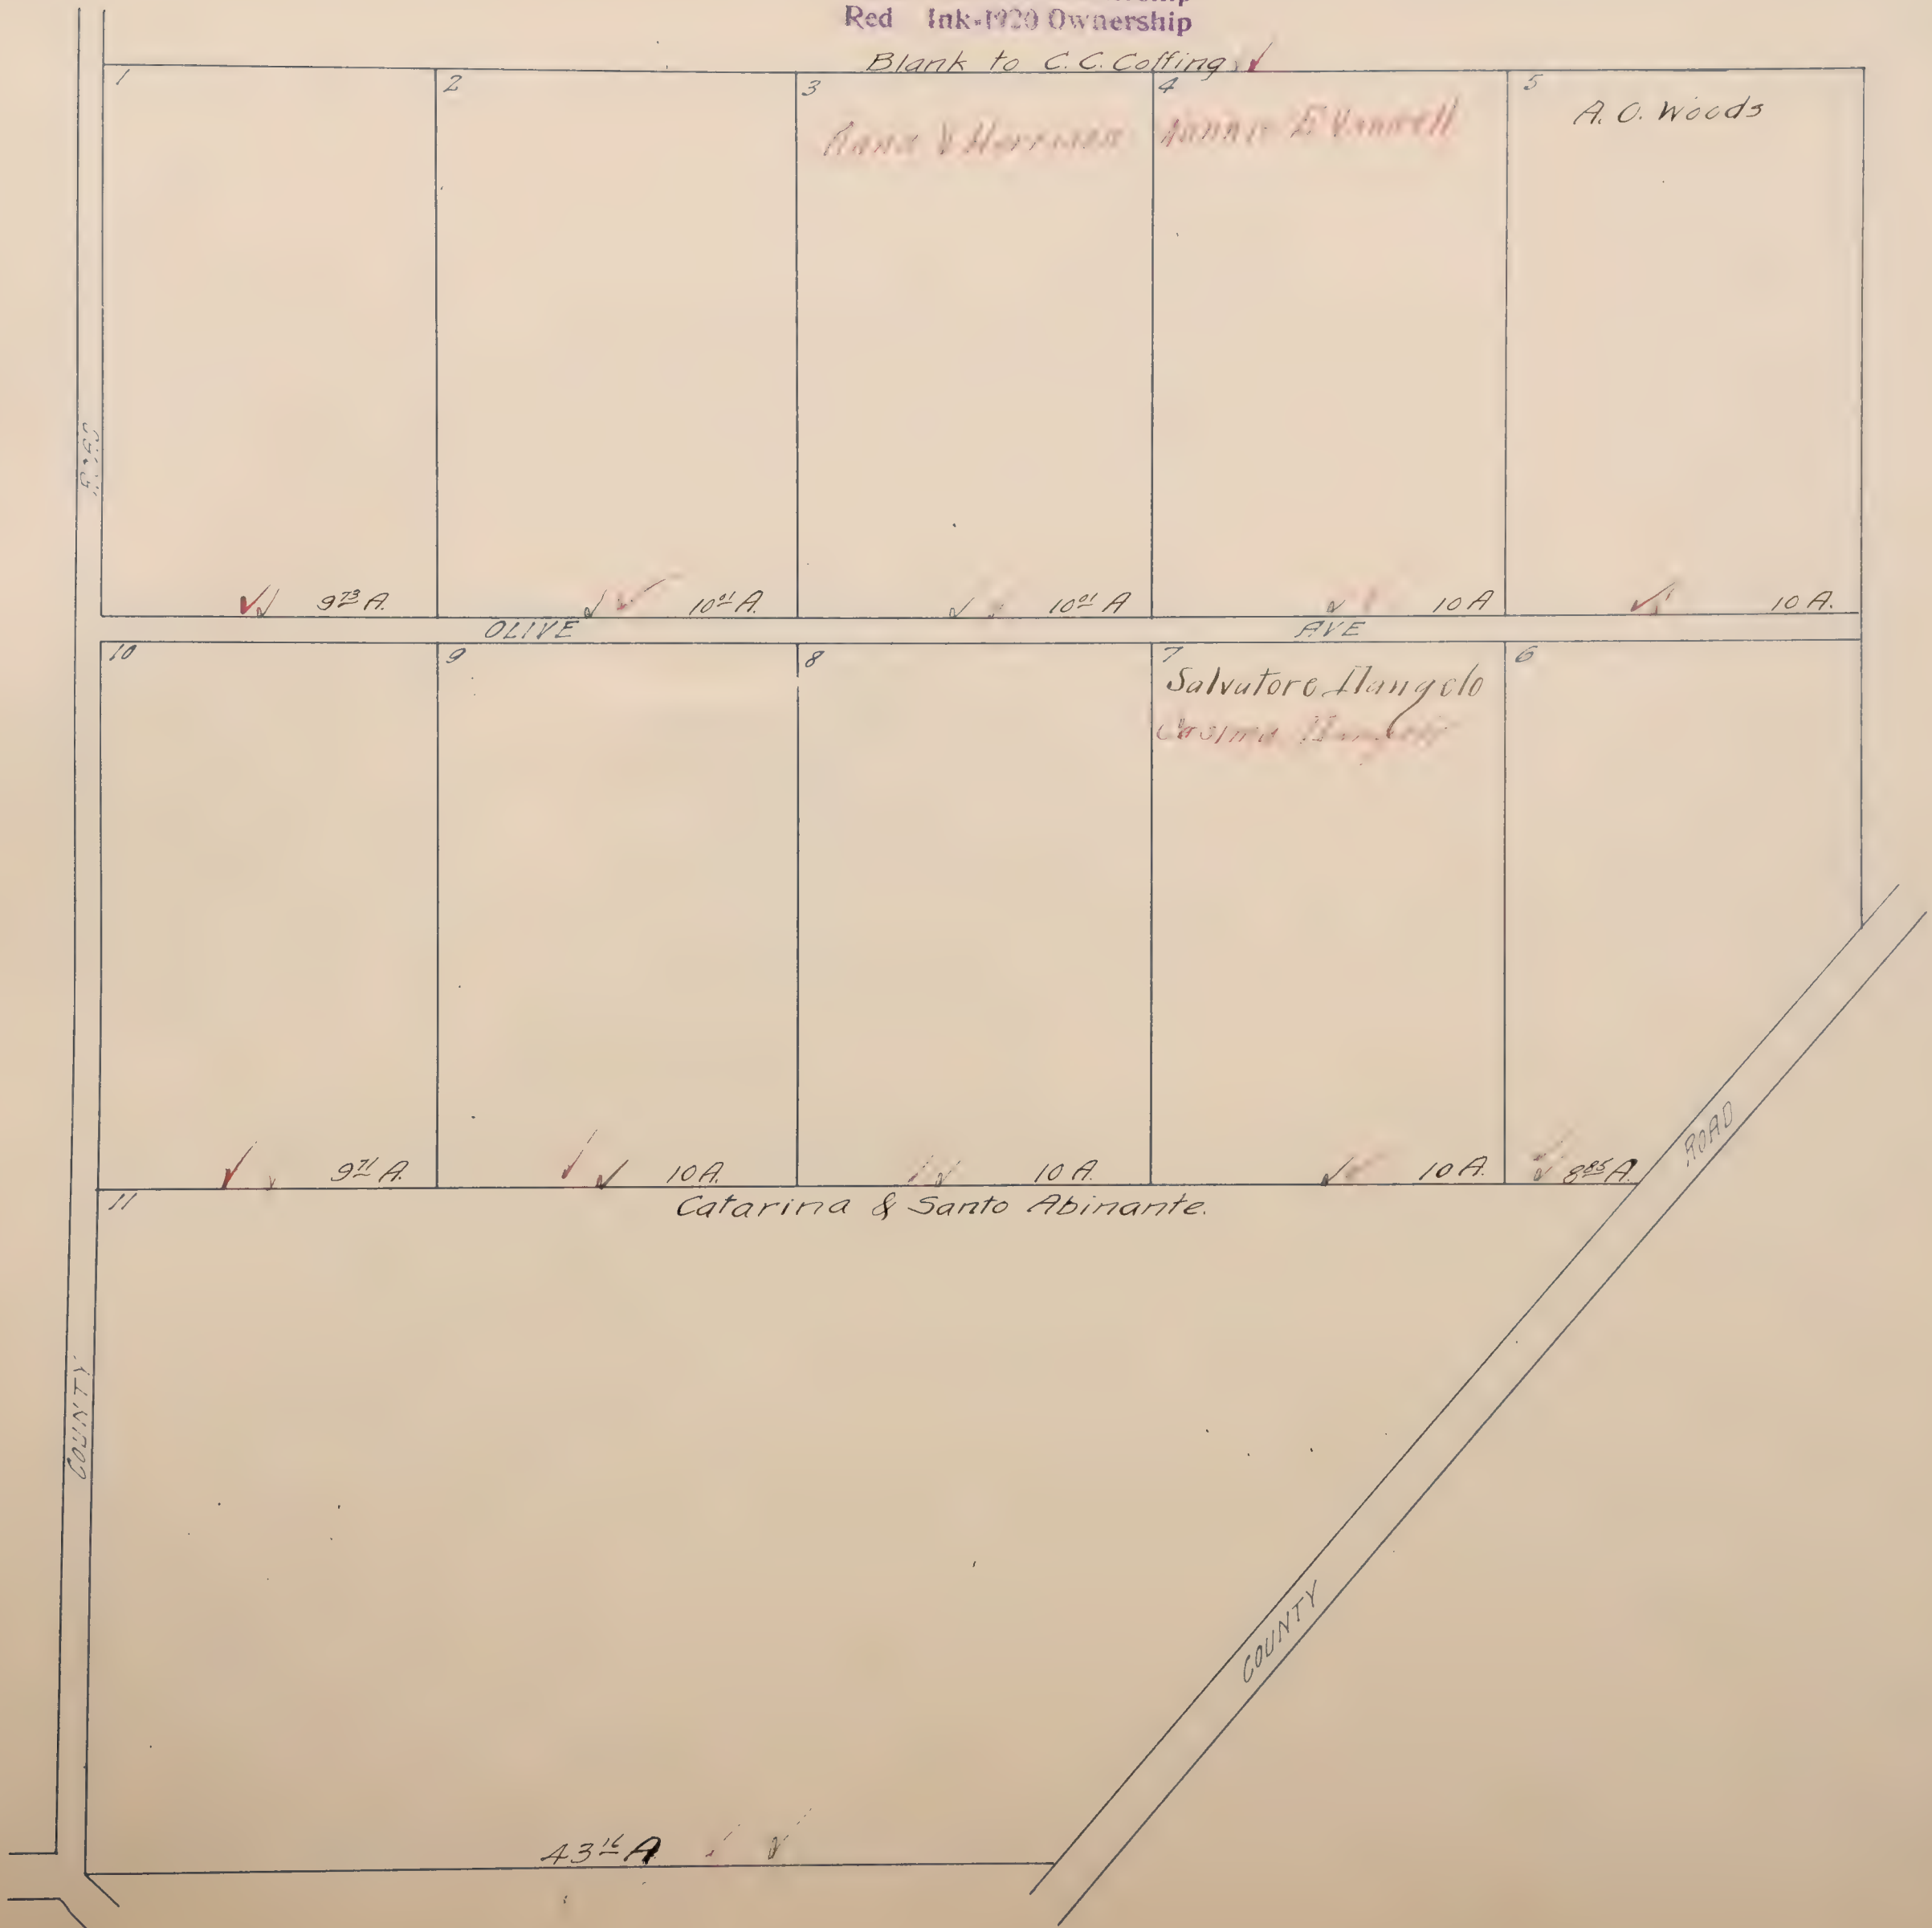

COLOMA HEIGHTS


RESUBDIVISION OF LOTS 13, 14, 18 & 19 OF LOUISIANA TRACT

Scale, 100 feet = 1 inch

Blanks to F.J. Hunger

Black Ink-1919 Ownership
Red Ink-1920 Ownership

GOLDBERG S.D.

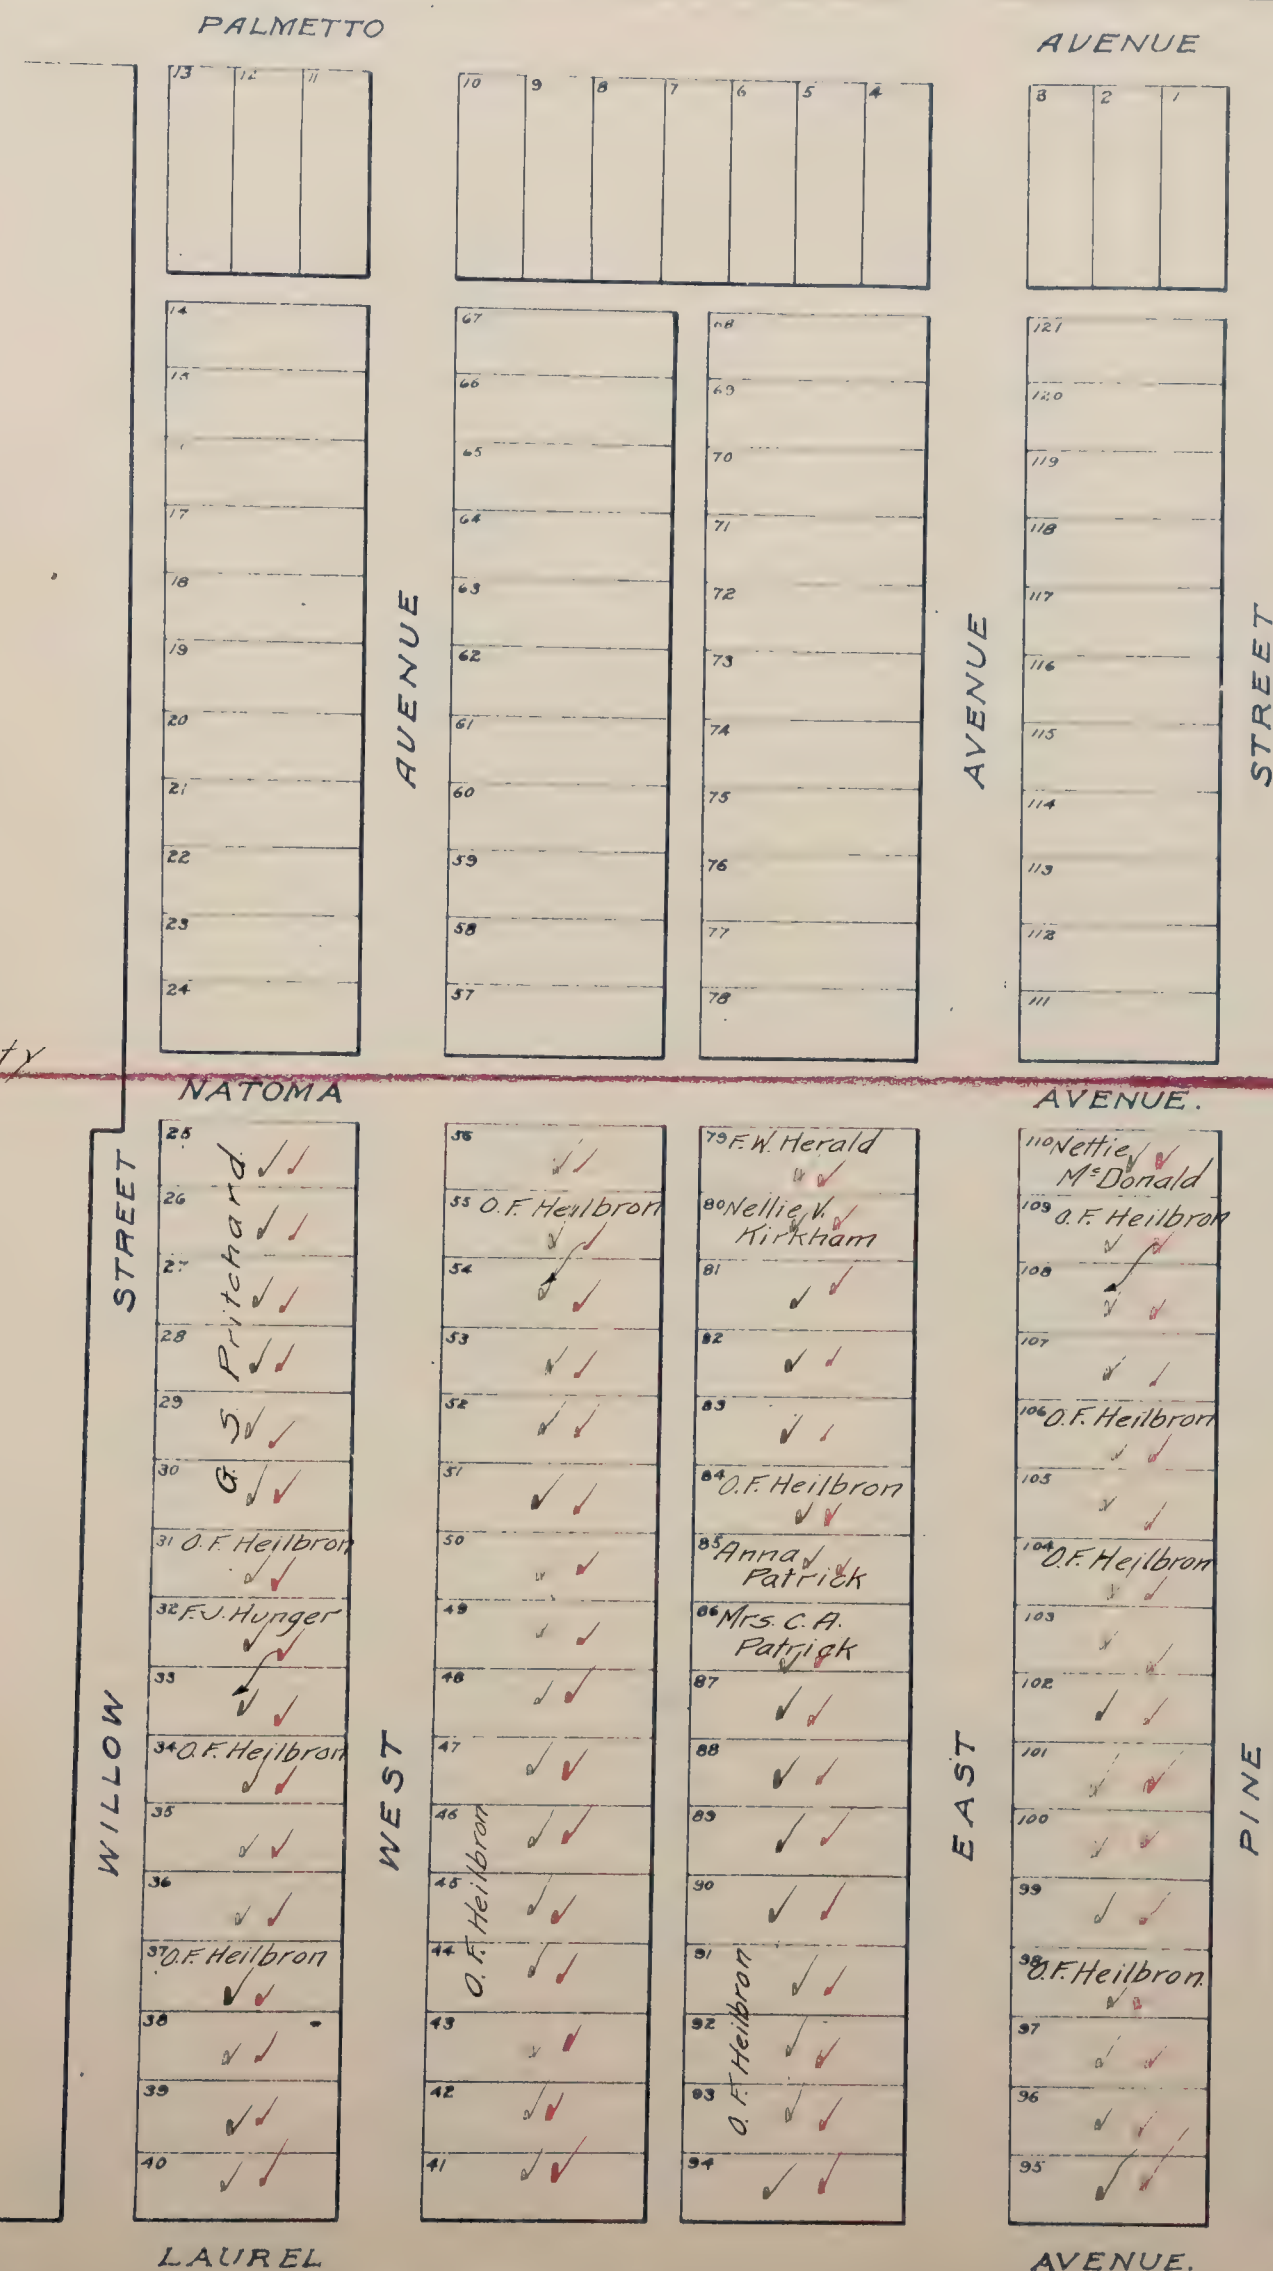

Mapped

COLONIAL ACRES

located in

NE 1/4 Sec 21 NW Sec 22 T8N R5E


Scale 1" = 200 ft

Blanks assessed to Colonial Improvement Co.
All lots 1 Acre except where otherwise noted

Black Ink - 1919 Ownership

Red Ink - 1920 Ownership

Map No. 1068

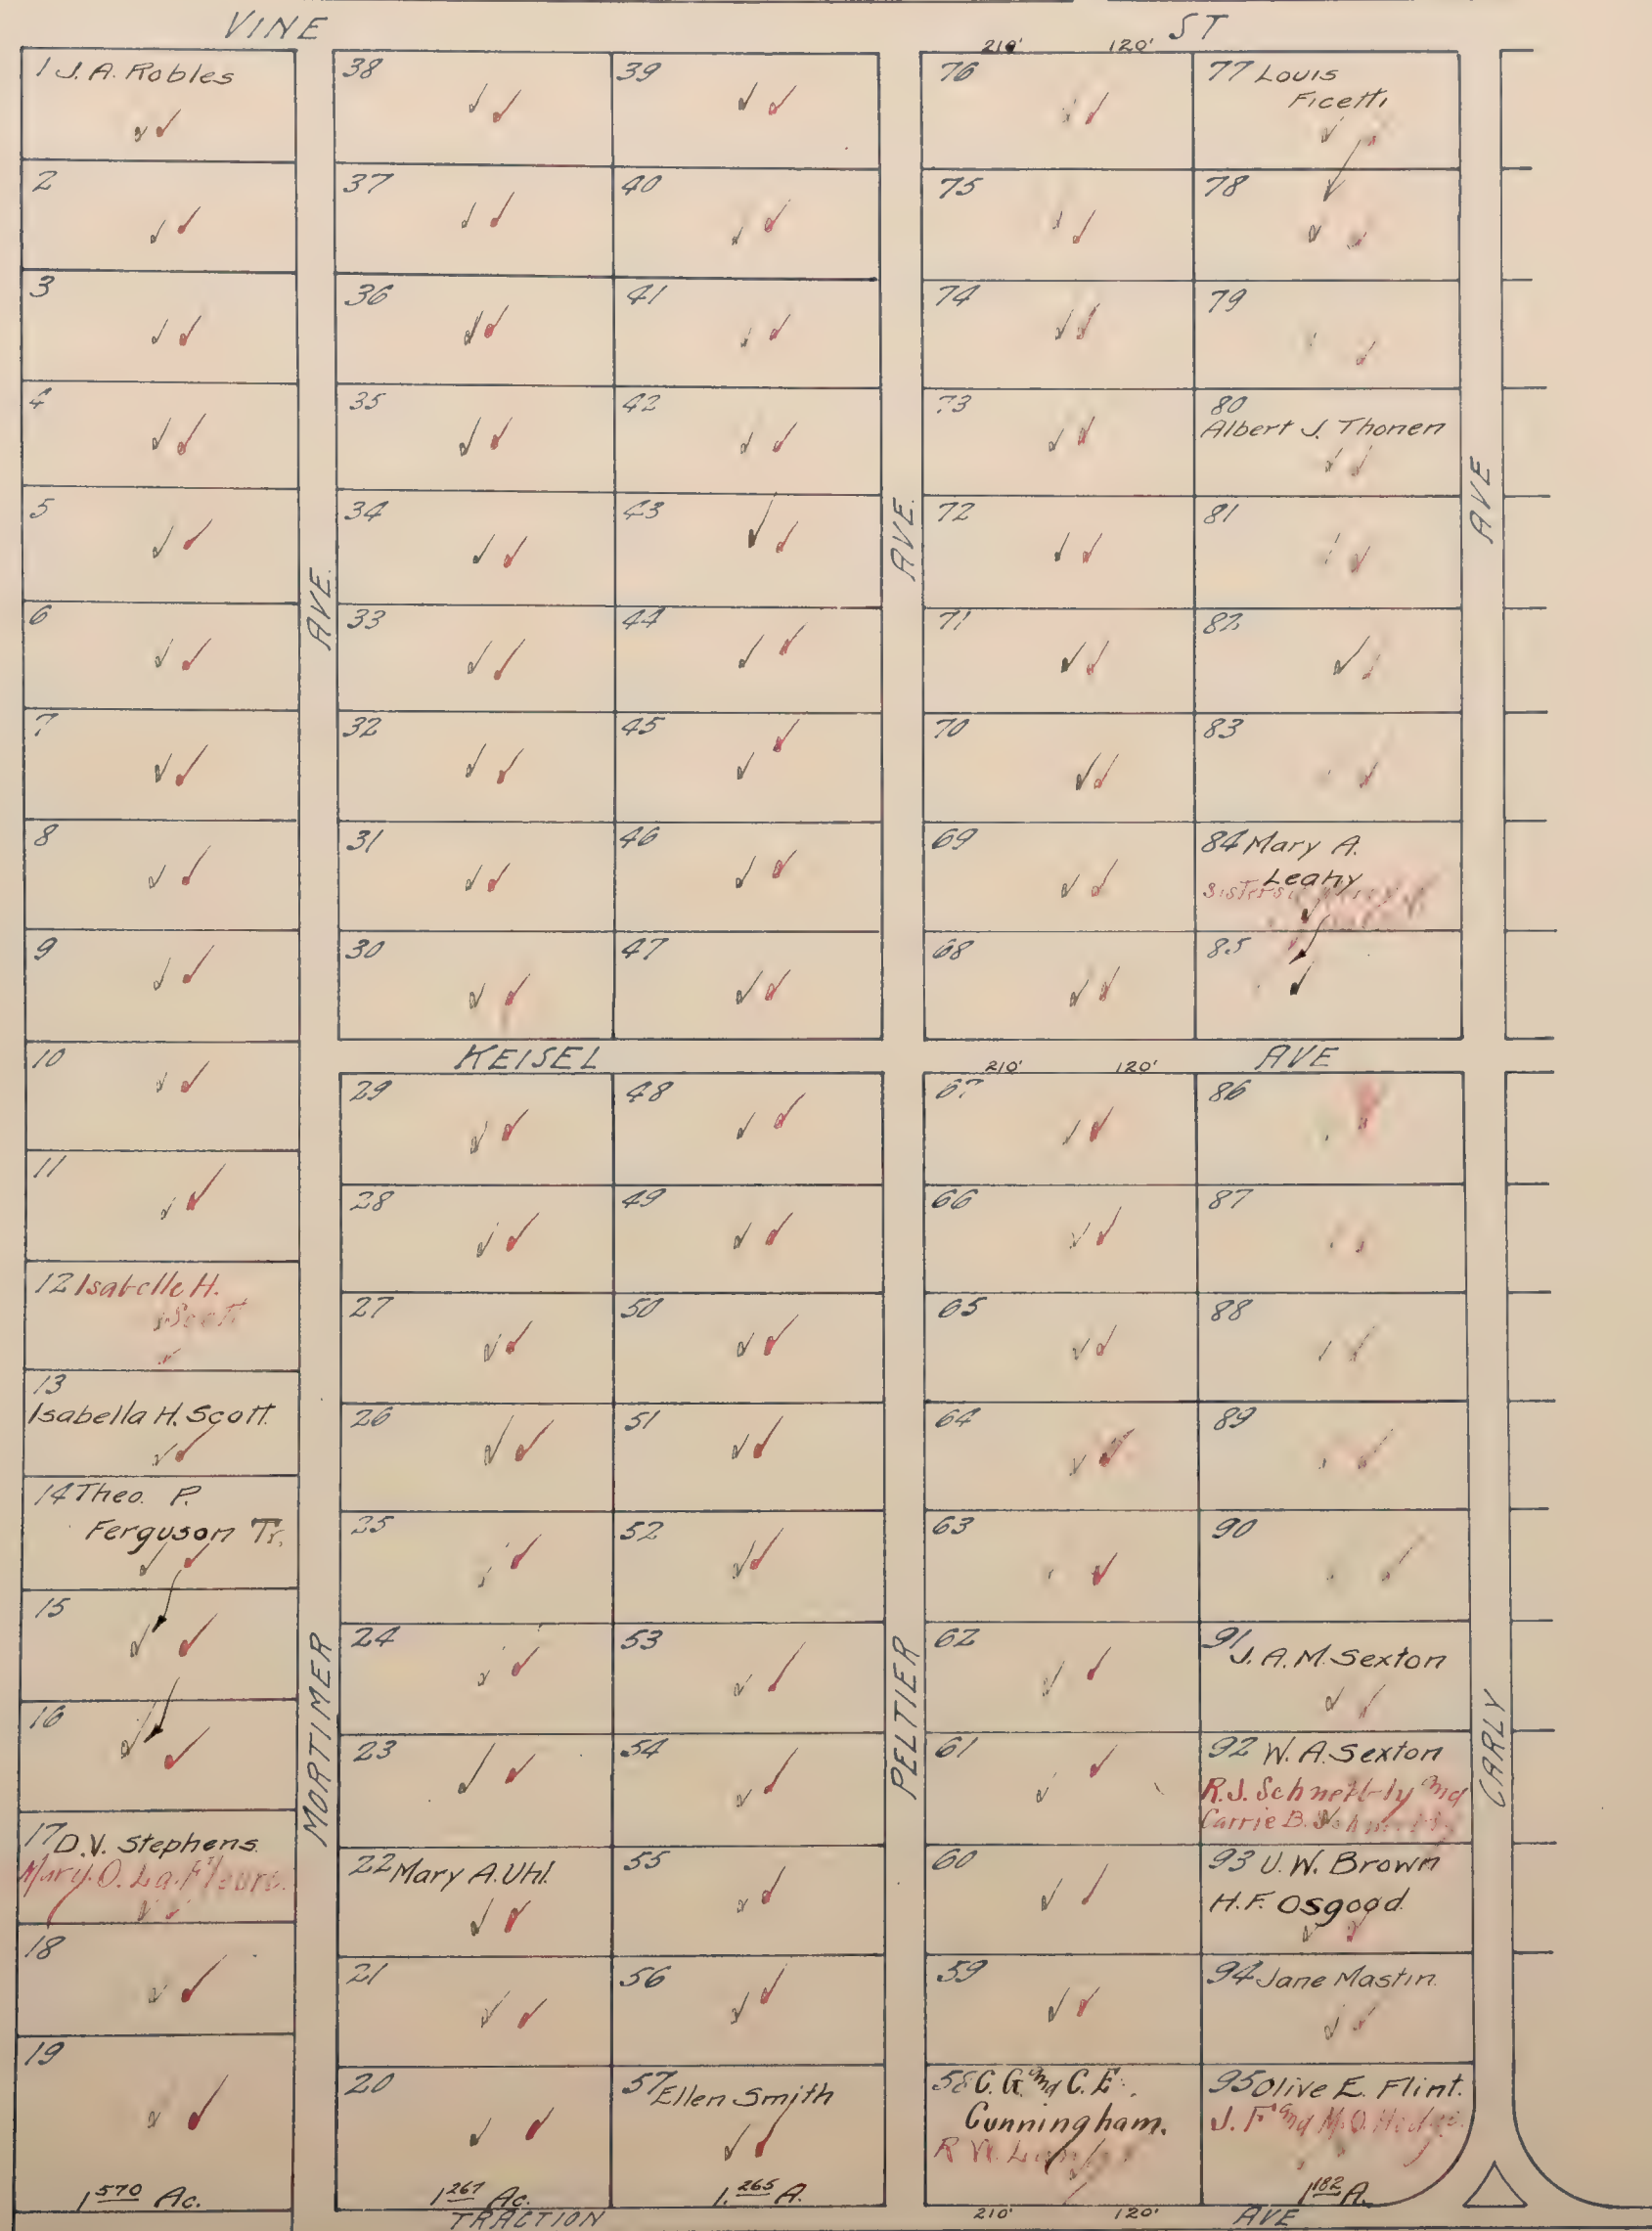

COLONIAL ACRES

located in
NE 1/4 Sec 21 NW 1/4 Sec 22 T.8. N. R.5E.

Black Ink-1919 Ownership
Red Ink-1920 Ownership

Scale: 1"=200ft

Blanks assessed to Colonial Improvement Co. Junction SD

All Lots 1 Acre except where otherwise noted

VINE		ST	
77	114 ✓	115 ✓	152 Lewis Peretti ✓
78	113 ✓	116 ✓	153 E.M. Cocker ✓ Ludwig & Polly ✓
79	112 ✓	117 ✓	151 ✓
80	111 ✓	118 ✓	154 ✓
81	110 ✓	119 ✓	150 ✓
82	109 ✓	120 ✓	155 ✓
83	108 ✓	121 ✓	149 ✓
84	107 E.A. Corum ✓	122 Nancy E. Houghton ✓	156 ✓
85	106 ✓	123 ✓	148 ✓
86	105 ✓	124 ✓	147 ✓
87	104 C. May Smittom ✓ D.A. & M. Collins ✓	125 P.A. & C.H. F.R. Richardson ✓	158 ✓
88	103 ✓	126 Phillip Chaussee ✓	146 ✓
89	102 ✓	127 Chas Fulme ✓	159 ✓
90	101 ✓	128 Shell Hawley ✓	145 ✓
91	100 C.A. Nedderson ✓	129 ✓	160 ✓
92	99 Gertrude & A.L. Gaylor ✓	130 ✓	161 ✓
93	98 August Wien ✓ Frank & Josie Matesi ✓	131 ✓	143 ✓
94	97 Bert L. Pierce ✓	132 Earl Geitner ✓	162 ✓
95	96 E.F. Geitner ✓	133 ✓	142 ✓
			141 Josephine & Eugene ✓
			140 ✓
			139 ✓
			138 Malvina Snyder ✓
			137 ✓
			136 Henry J. Schmidt ✓ W. Schmidt ✓
			135 Mamie E. Callahan ✓
			134 Lena Stegeman ✓
			163 ✓
			164 H. & M. Riechel ✓
			165 ✓
			166 Mary M. Hight ✓
			167 Std. Liquor Co. ✓
			168 Eugene, Frank & Lily Ada Panario ✓
			169 ✓
			170 Hardee Masteller ✓ F.M. & T. Thurston ✓
			171 The Art Tailoring Co. ✓
			172 ✓
			173 ✓
			174 ✓
			175 ✓
			176 ✓
			177 ✓
			178 ✓
			179 Eugene L. Pierie ✓ Agatha Schuler ✓
			180 Florence A. Smith ✓ Jos. & Emily S. Hartley ✓
			181 ✓
			182 ✓
			183 ✓
			184 ✓
			185 ✓
			186 ✓
			187 ✓
			188 Clara M. Cormick Und ² Int. ✓ Vernon " " " " ✓

TRACTION

AVE

2⁰⁰⁰ A

COLONIAL ACRES NO. 2.

LOCATED IN
S.E. 1/4 of Sec. 21. T. 8 N. R. 5 E.
Sacramento County California.
Scale 1" = 200'


Black Ink-1919 Ownership
Red Ink-1920 Ownership

All blanks assessed to Colonial Improvement Co. ✓

COLONIAL ACRES

Fruit Ridge S.D.

CENTRAL CALIFORNIA TRACTION CO.

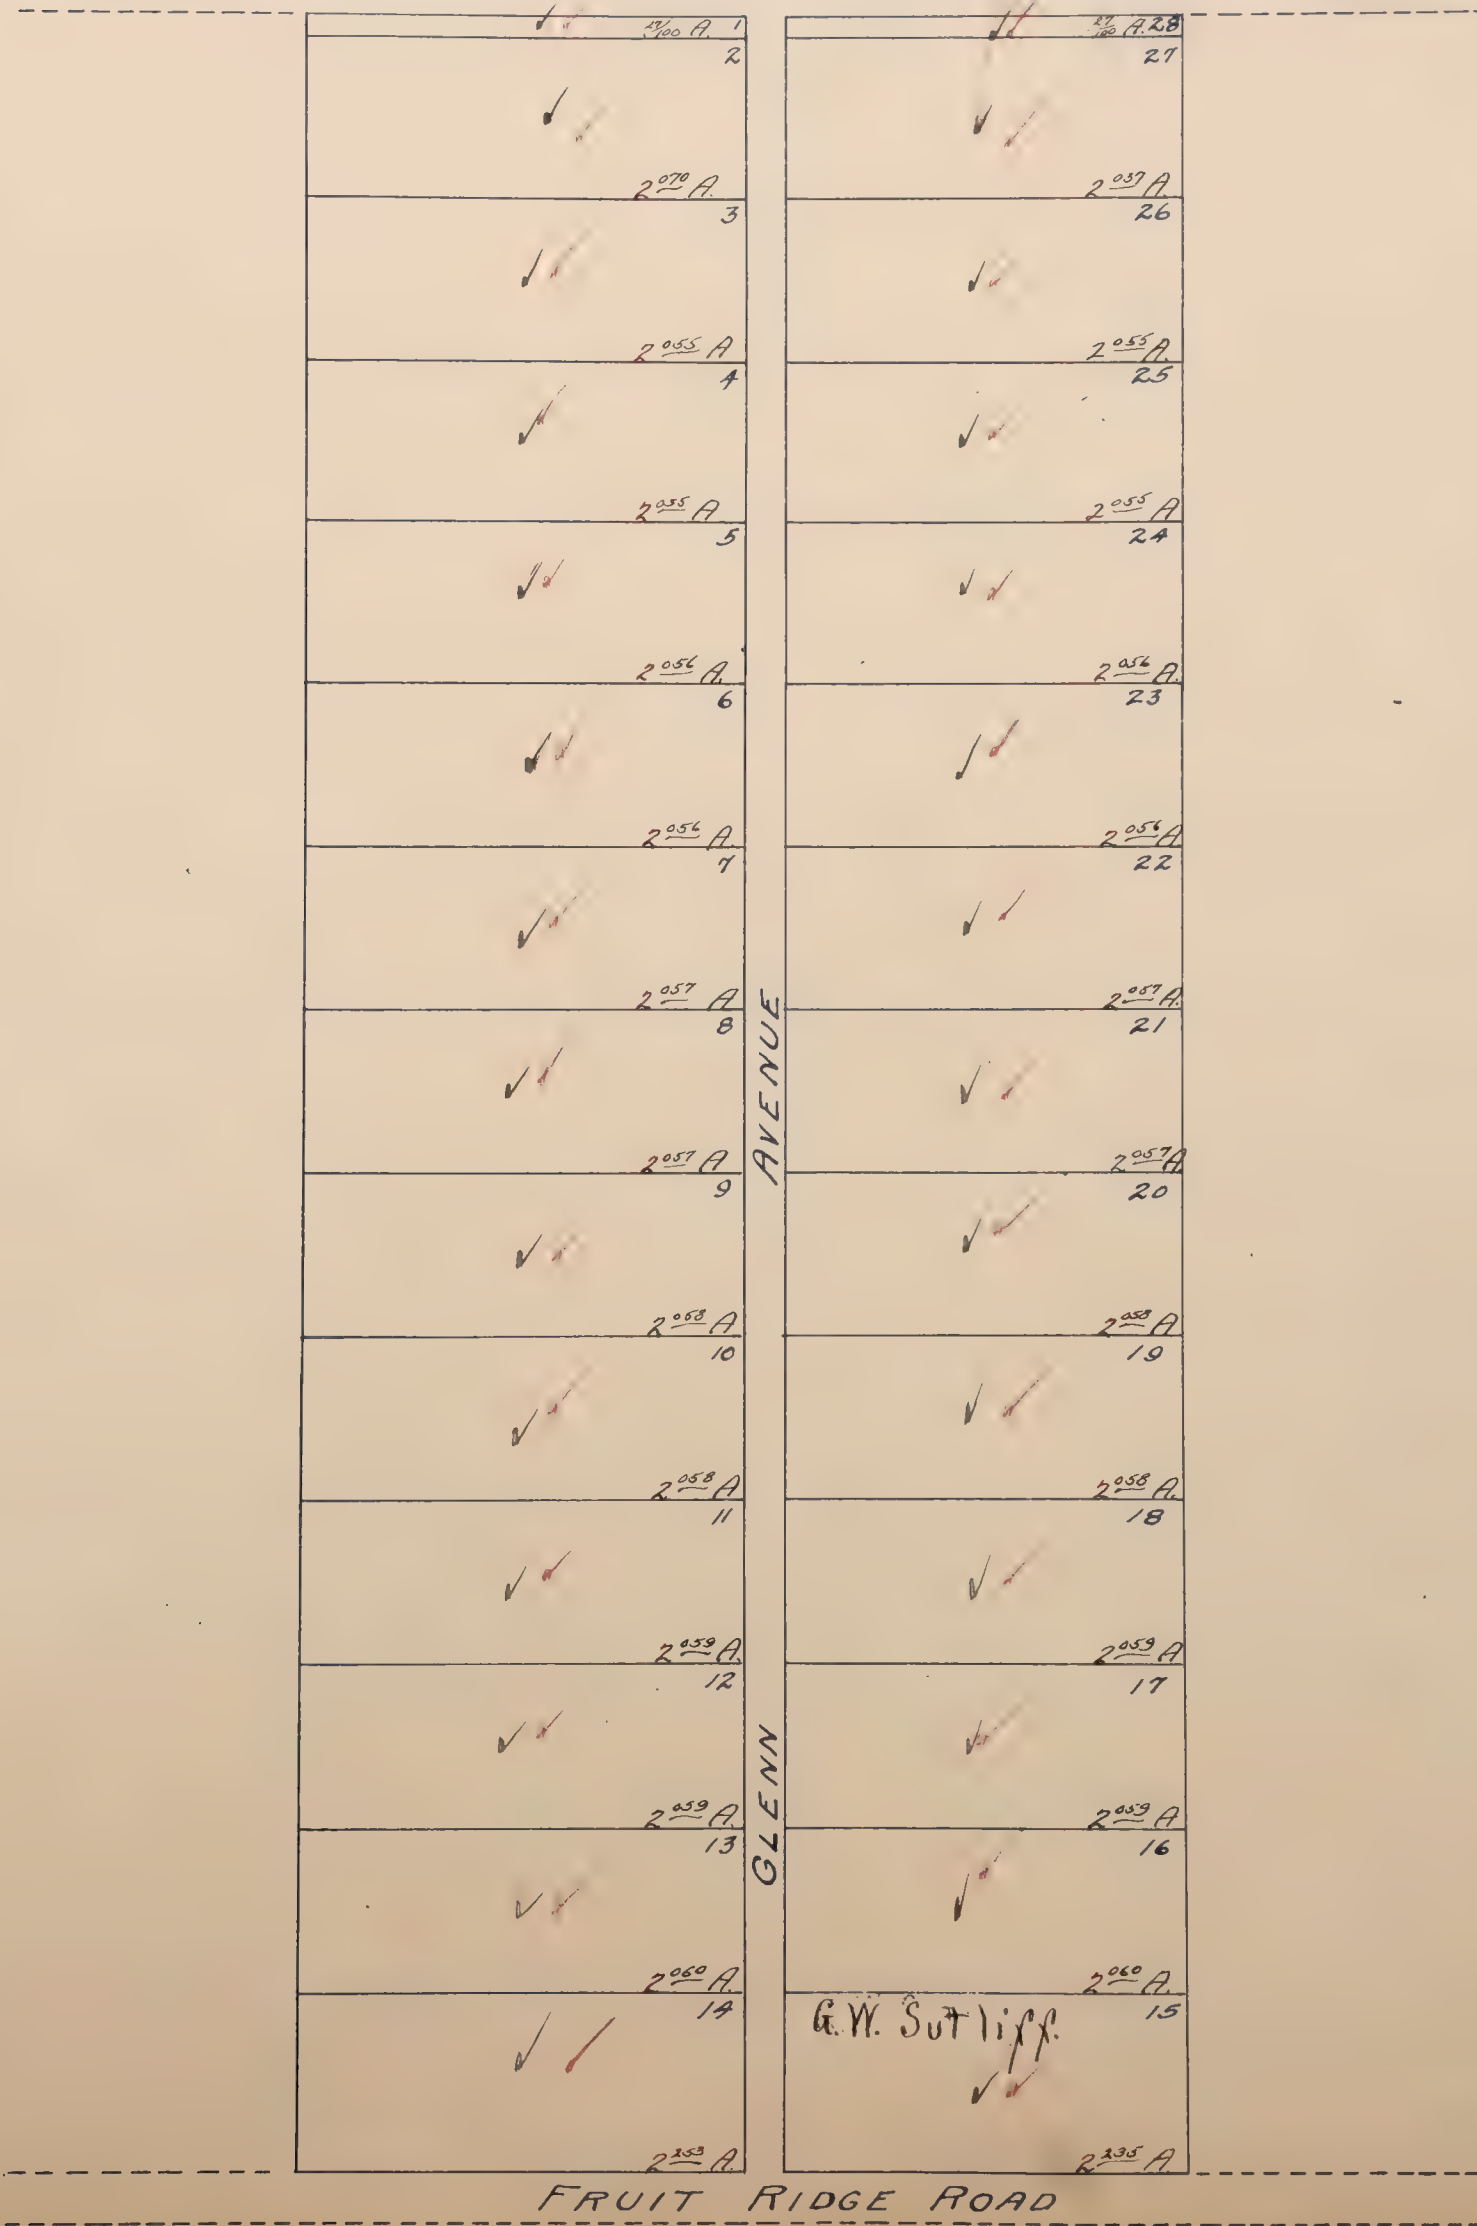

Mappea.

Black Ink-1919 Ownership
Red Ink-1920 Ownership

COLONIAL HEIGHTS

LOCATED IN
Sec's 20. & 21. ~ T8N R5E
Scale 100' = 1"

Blanks assessed to Colonial Investment Co. Fruit Ridge S.D.



COLONIAL HEIGHTS

LOCATED IN
SEC'S 20 & 21 T8 N. R 5 E
Scale 100' = 1"

Black Ink - 1919 Ownership
Red Ink - 1920 Ownership

Fruit Ridge S.D.

Blanks assessed to Colonial Inv. Co.

AVENUE	30	39	40	49	50	59	Oak Park Water Co.
	31	38	41	48	51	60	Minnie F. Deas
	32	37	42	47	52	61	Laverne Bauman
	33	36	43	46	53	62	Geo. Smethurst
AVENUE	34	35	44	45	54	63	Chas. Hadsworth
	35	34	45	44	55	64	Trainor & Desmond
	36	33	46	43	56	65	W.B. T. J. St.
	37	32	47	42	57	66	Ann Higgs
AVENUE	38	31	48	41	58	67	Carlotta B. Slusher
	39	30	49	40	59	68	FW & Delphine Snyder
	40	29	50	39	60	69	Waters & Luke
	41	28	51	38	61	70	C.R. and G.A.
AVENUE	42	27	52	37	62	71	
	43	26	53	36	63	72	
	44	25	54	35	64	73	
	45	24	55	34	65	74	
AVENUE	46	23	56	33	66	75	
	47	22	57	32	67	76	Matilda Leriche
	48	21	58	31	68	77	
	49	20	59	30	69	78	
AVENUE	50	19	60	29	70	79	
	51	18	61	28	71		
	52	17	62	27	72		
	53	16	63	26	73		
AVENUE	54	15	64	25	74		
	55	14	65	24	75		
	56	13	66	23	76		
	57	12	67	22	77		
AVENUE	58	11	68	21	78		
	59	10	69	20	79		
	60	9	70	19			
	61	8	71	18			
AVENUE	62	7	72	17			
	63	6	73	16			
	64	5	74	15			
	65	4	75	14			
AVENUE	66	3	76	13			
	67	2	77	12			
	68	1	78	11			
	69		79	10			
AVENUE	70			9			
	71			8			
	72			7			
	73			6			
AVENUE	74			5			
	75			4			
	76			3			
	77			2			
AVENUE	78			1			
	79						
	80						
	81						

Black Ink-1919 Ownership
Red Ink-1920 Ownership


COLONIAL HEIGHTS

LOCATED IN
Sec's 20 & 21 ~ T.8N.R.5E.

Scale 100' = 1"

Fruit Ridge SD.

Blanks assessed to Colonial Inv. Co. ✓✓

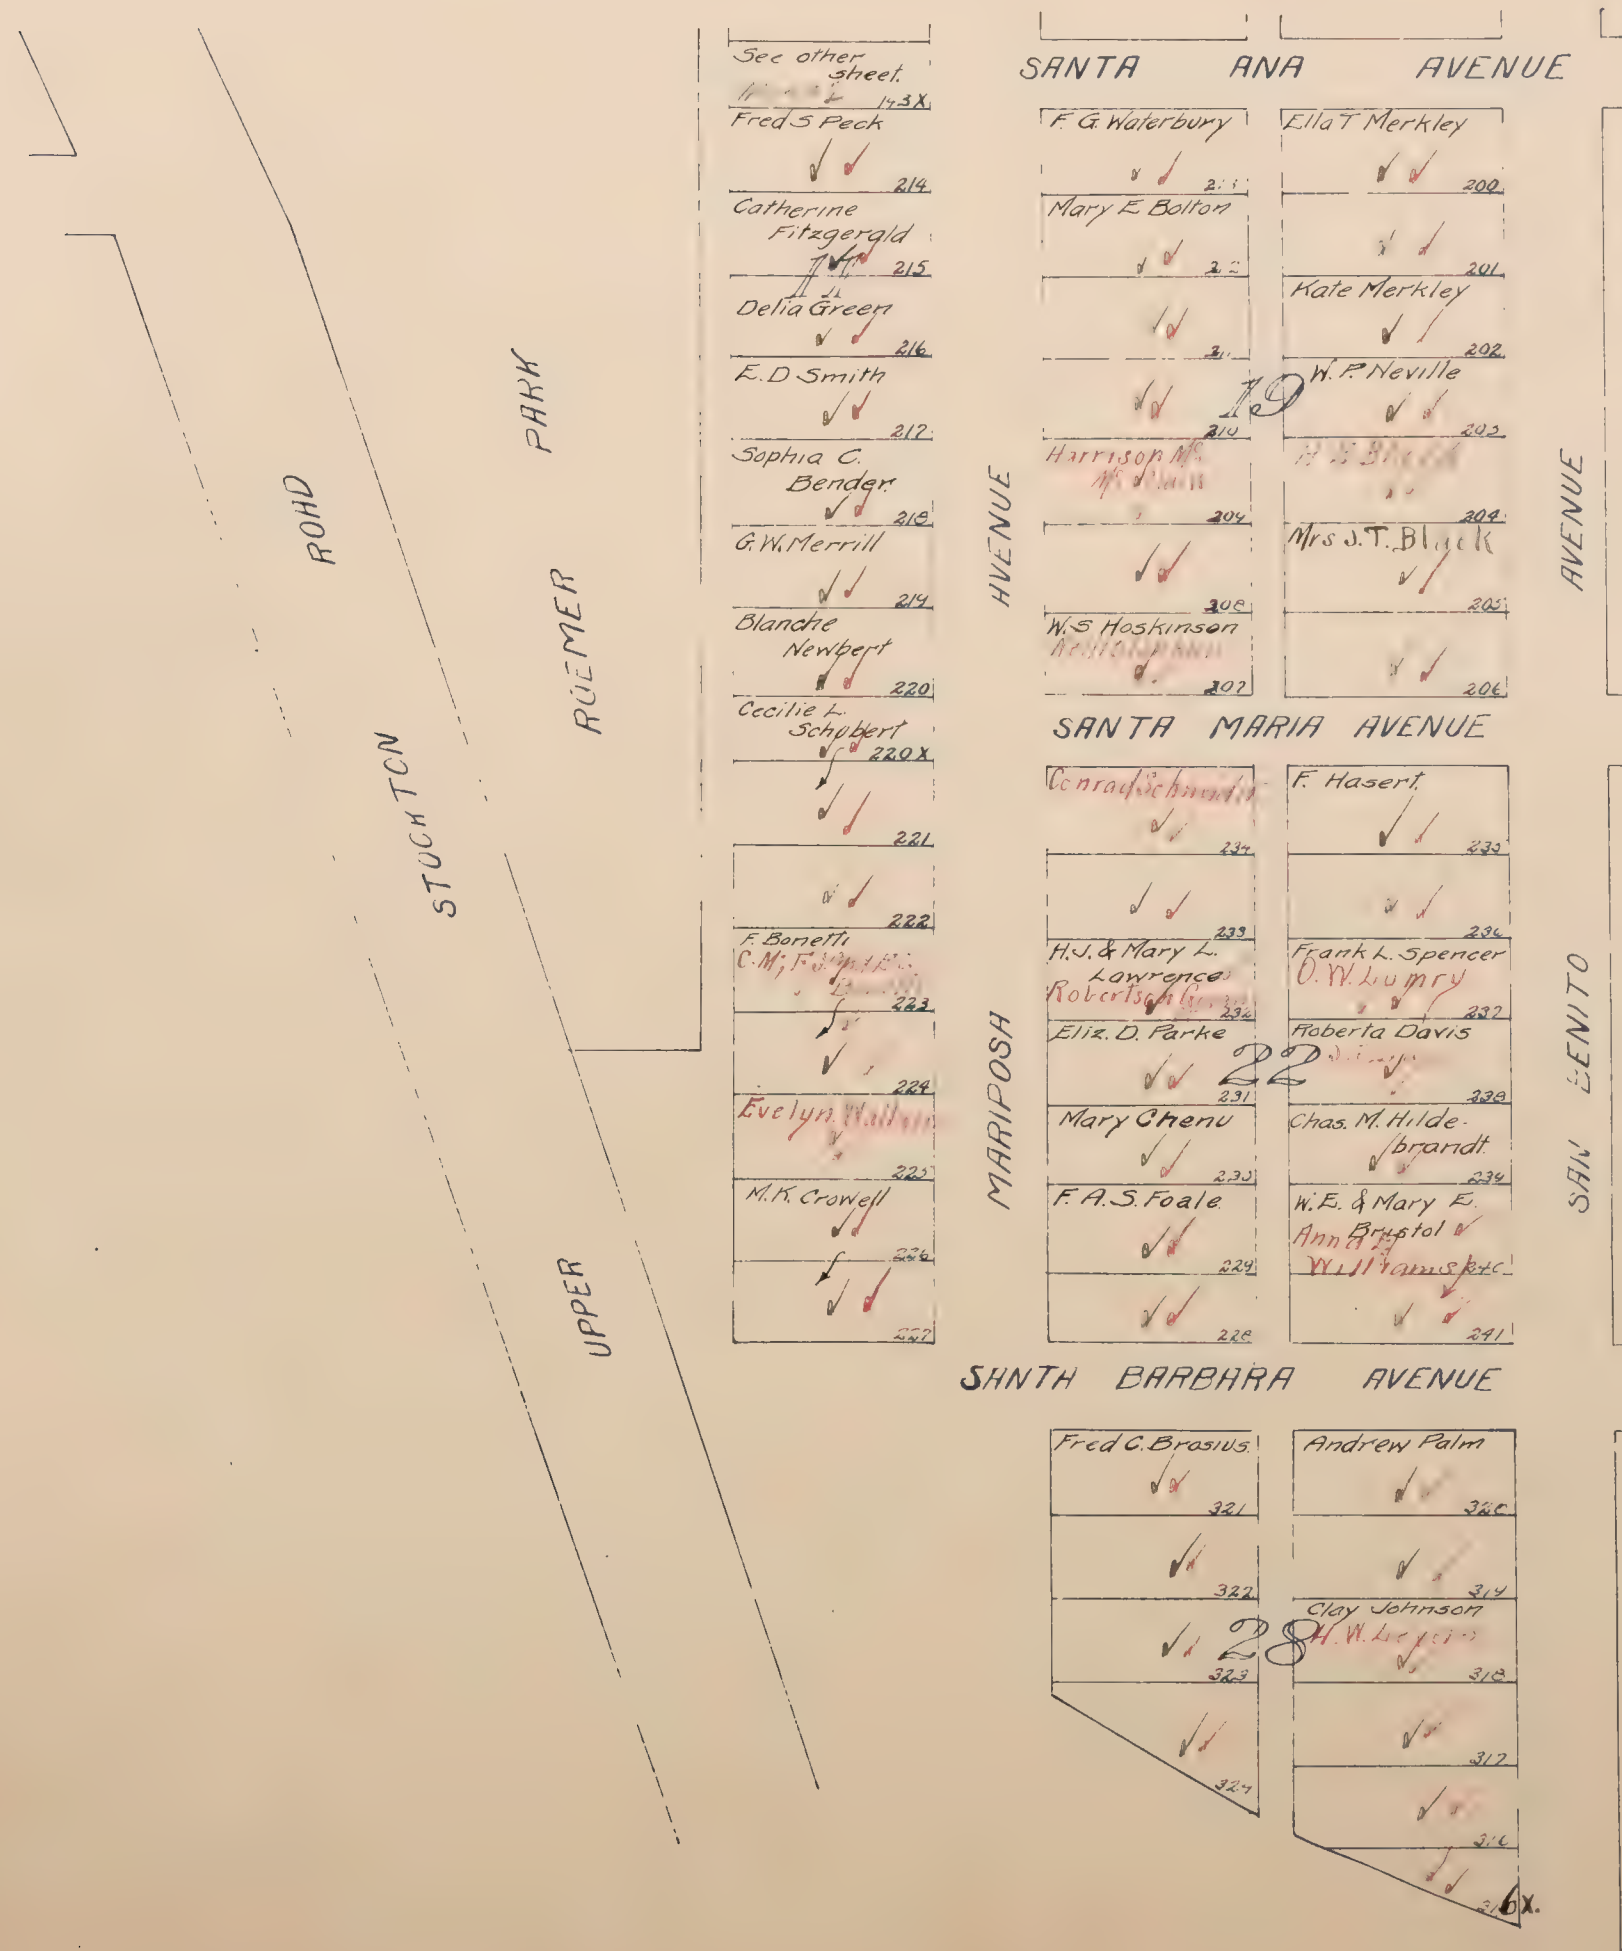

Mapped.

Black Ink-1919 Ownership
Red Ink-1920 Ownership

COLONIAL HEIGHTS

LOCATED IN
Secs 20 & 21 T8N R5E
Scale 100' = 1"

*Limit Ridge
Goldberg S.D.*



Black Ink-1919 Ownership
Red Ink-1920 Ownership


COLONIAL HEIGHTS

LOCATED IN
Secs 20 & 21 ~ T.8 N. R.5 E

Scale 1" = 100'

Fruit Ridge SD

Blanks assessed to Colonial Inv. Co.

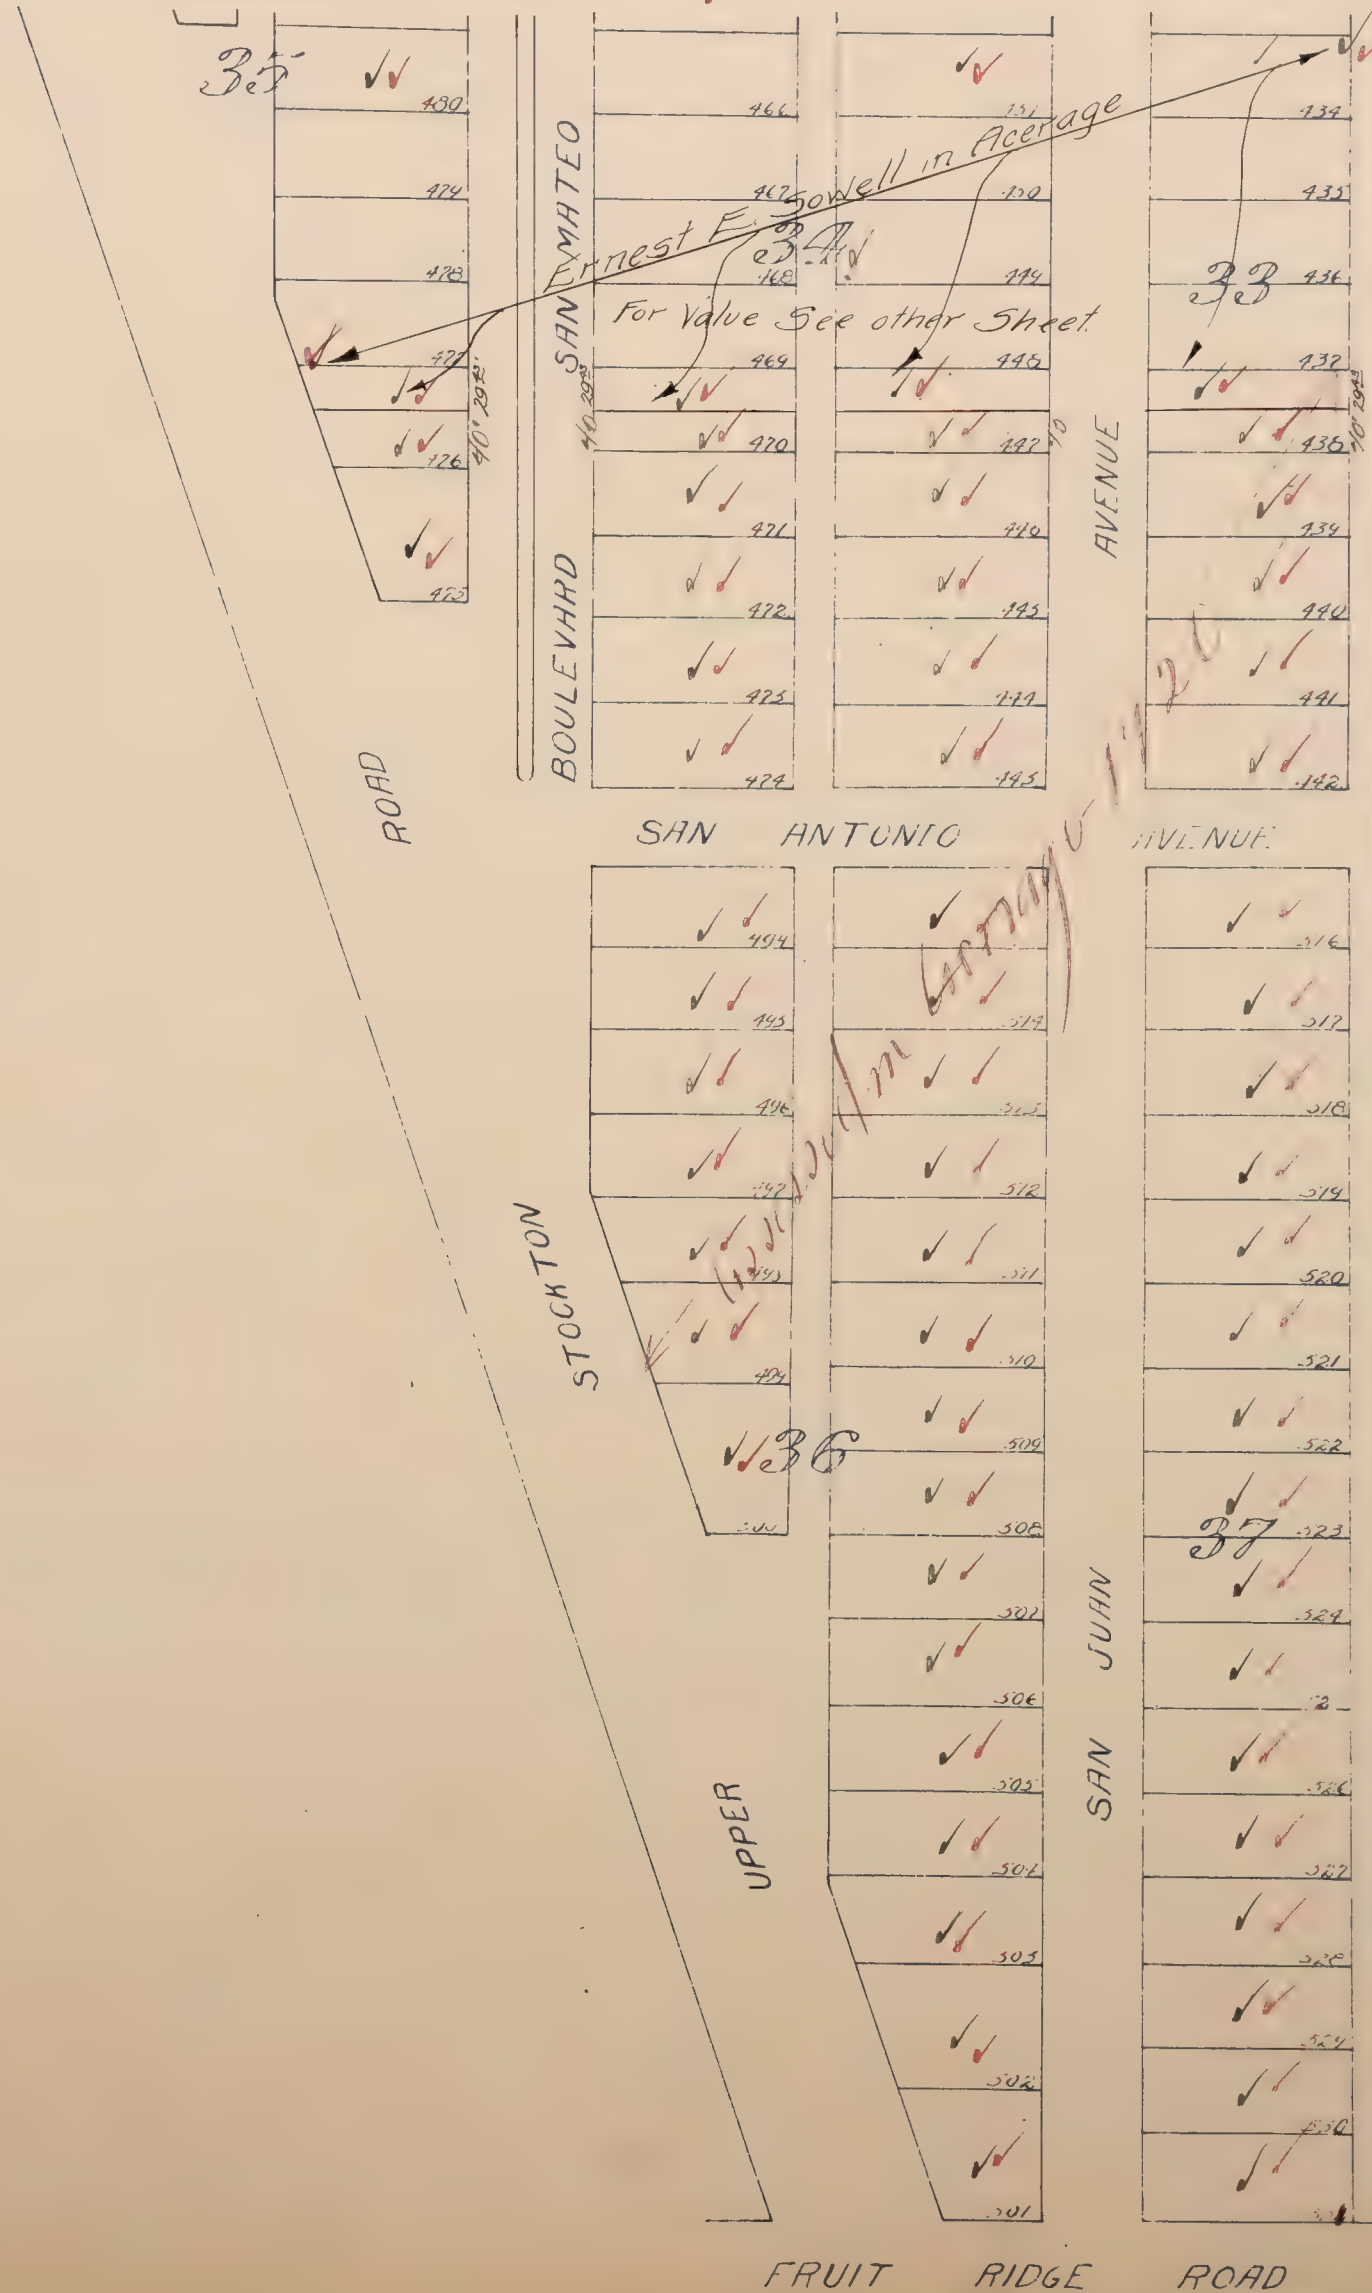

Black Ink=1919 Ownership
Red Ink=1920 Ownership

COLONIAL HEIGHTS

Blocks 30-31-32 & Parts of 29-33-34-35

of

Colonial Heights


Being a portion W $\frac{1}{2}$ Sec. 21 T.8N. R.5E.

Scale: 1"=100'

COLONIAL HEIGHTS

All Blanks assessed to Dora L. Sowell ✓

C. C. T. Co.

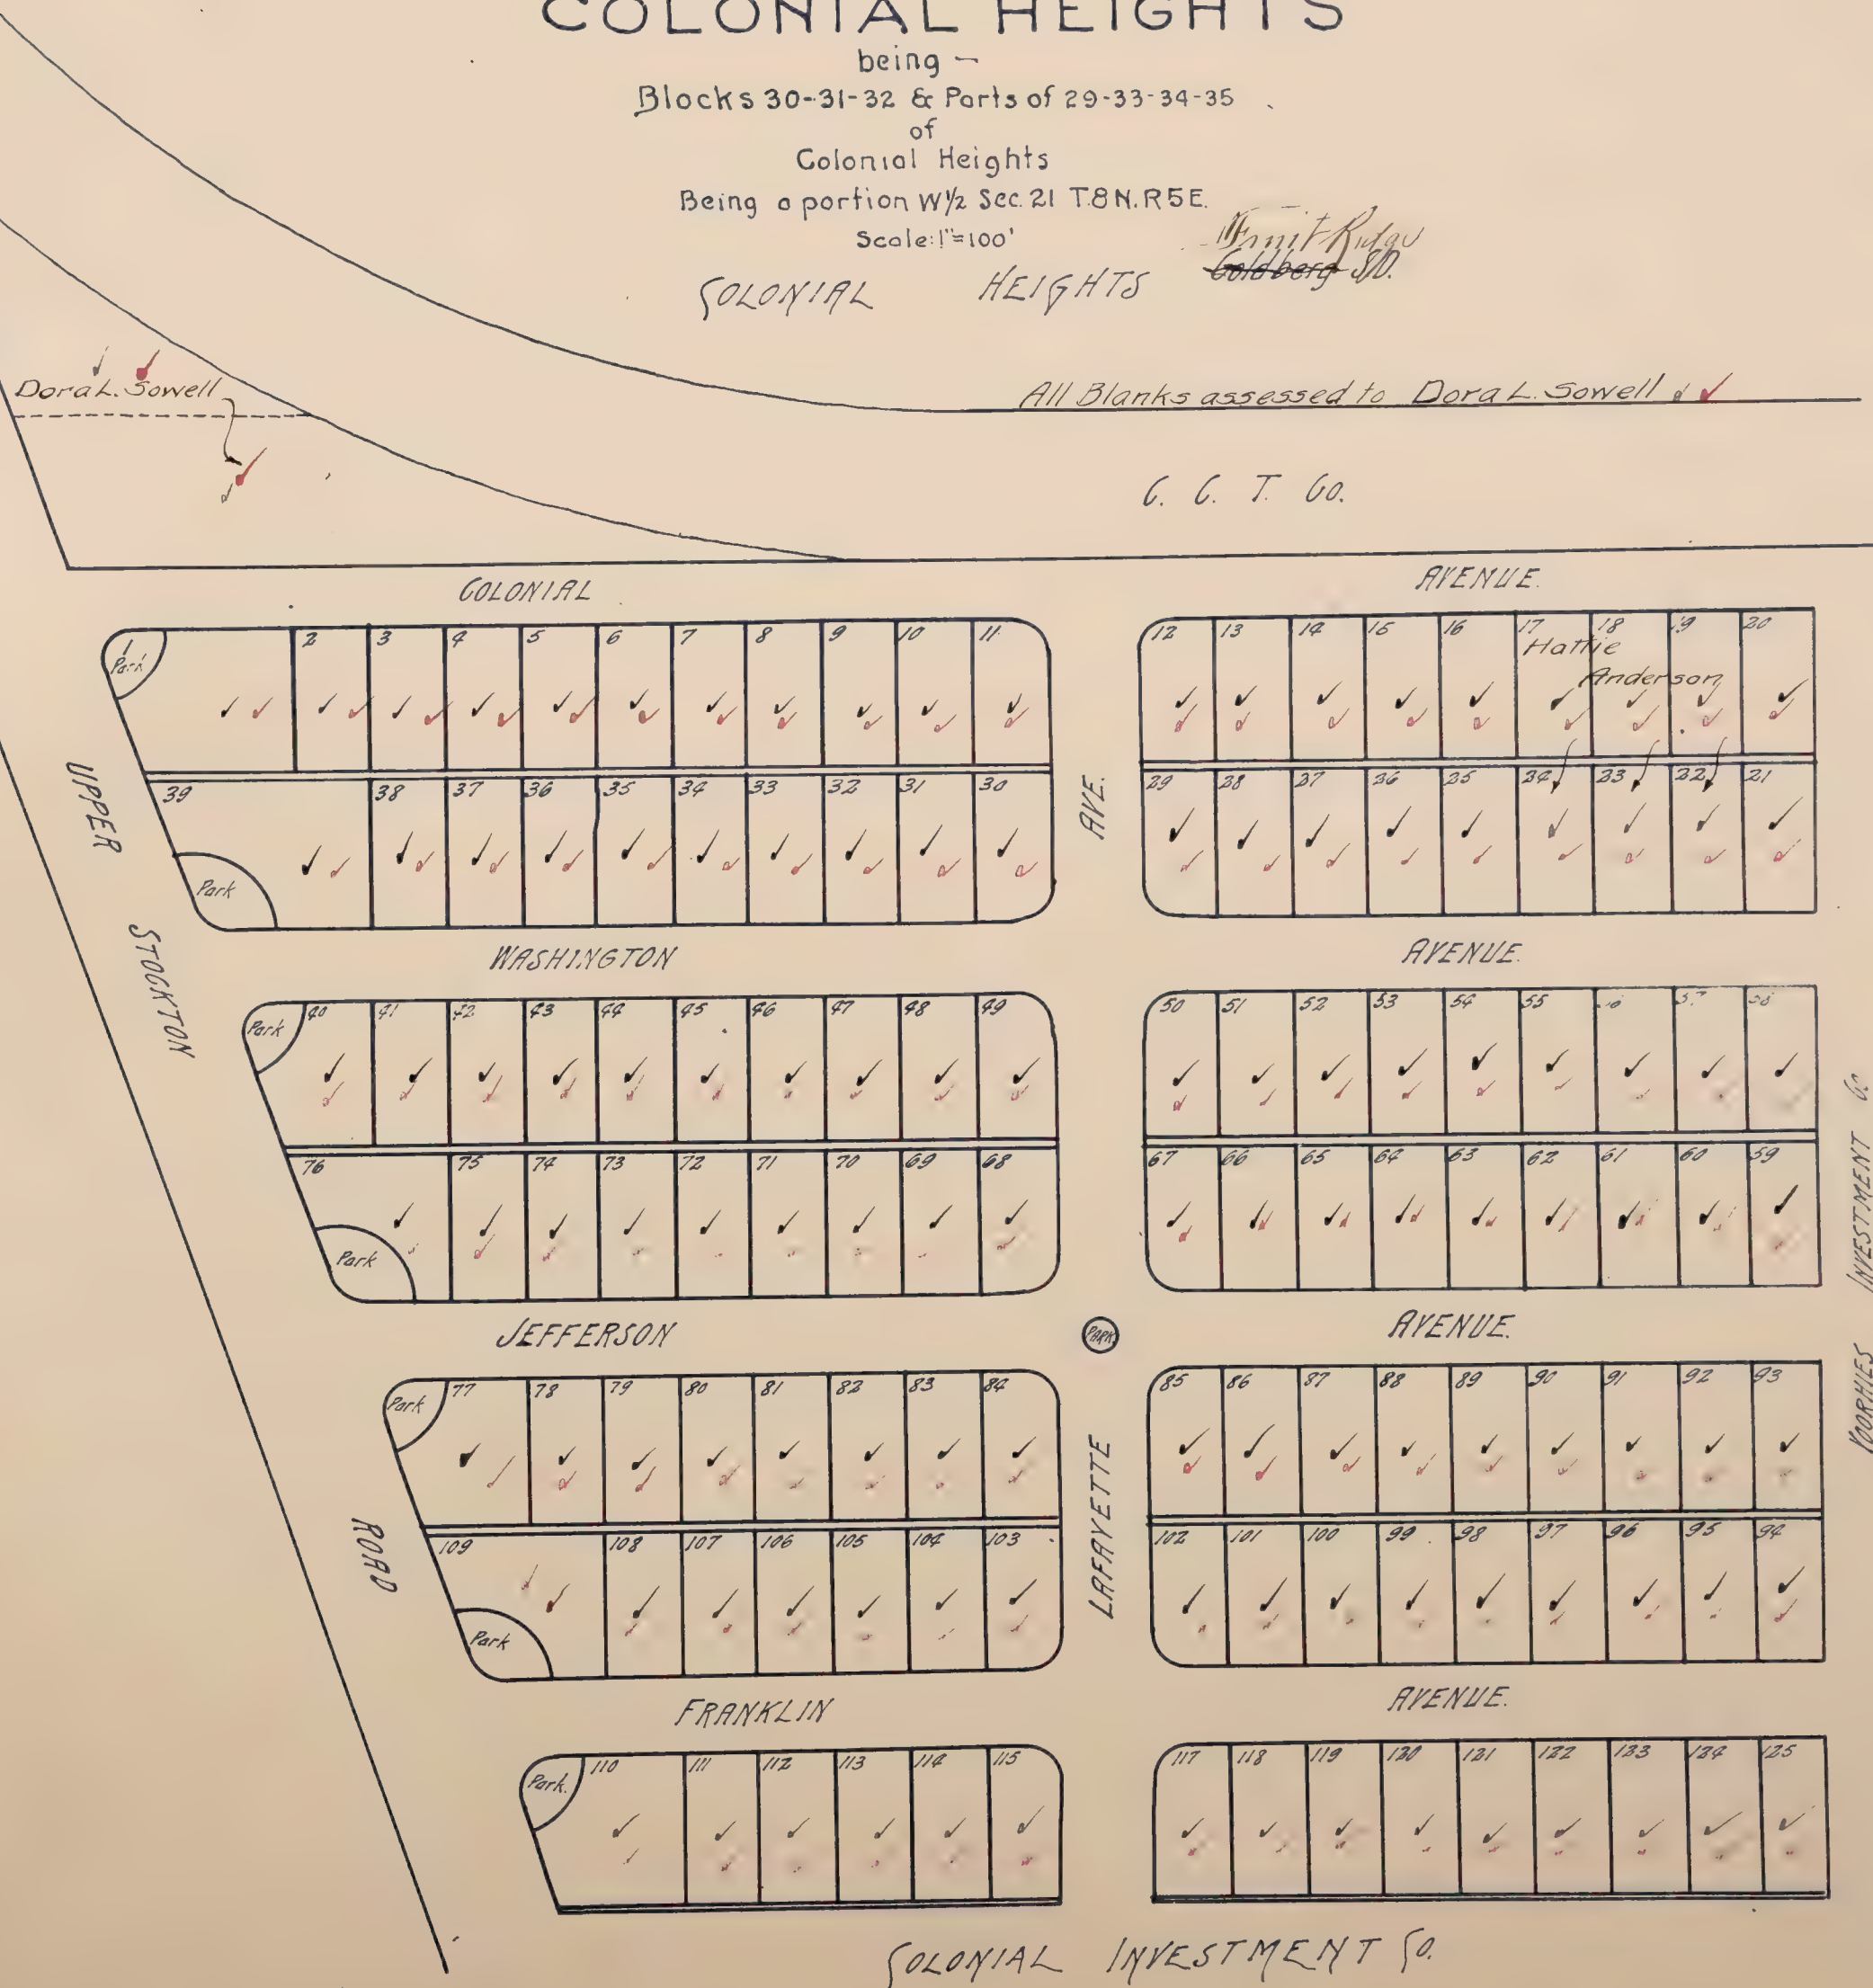

Map No. Black Ink-1919 Ownership
Red Ink-1920 Ownership

COMET SUBDIVISION

BEING

Lots 32, 33, 34 & 35 Block 26 Louisiana Tract

LOCATED IN

N.E. 1/4 of Sec. 19, T.8N.R.5E.

Scale: 1"=50'

Fruit Ridge S.D.

Blanks assessed to Mrs. M. J. Nichols

8	7	6	5	4	3	2	1
✓	✓	✓	✓	✓	✓	✓	✓
COMET AVENUE							
9	10	11	12	13	14	15	16
✓	✓	✓	✓	✓	✓	✓	✓
24	23	22	21	20	19	18	17
✓	✓	✓	✓	✓	✓	✓	✓
BERRY AVENUE							
25	26	27	28	29	30	31	32
✓	✓	✓	✓	✓	✓	✓	✓

AVENUE

CHESTNUT

GOULD

Black Ink-1919 Ownership
Red Ink-1920 Ownership

CONLEY TRACT

SUBDIVISION No. 2


located in

Section 34 T.6N. R.7E.

Scale: 1" = 4 chs.

Laguna S.D.

Blanks to James Conley &.

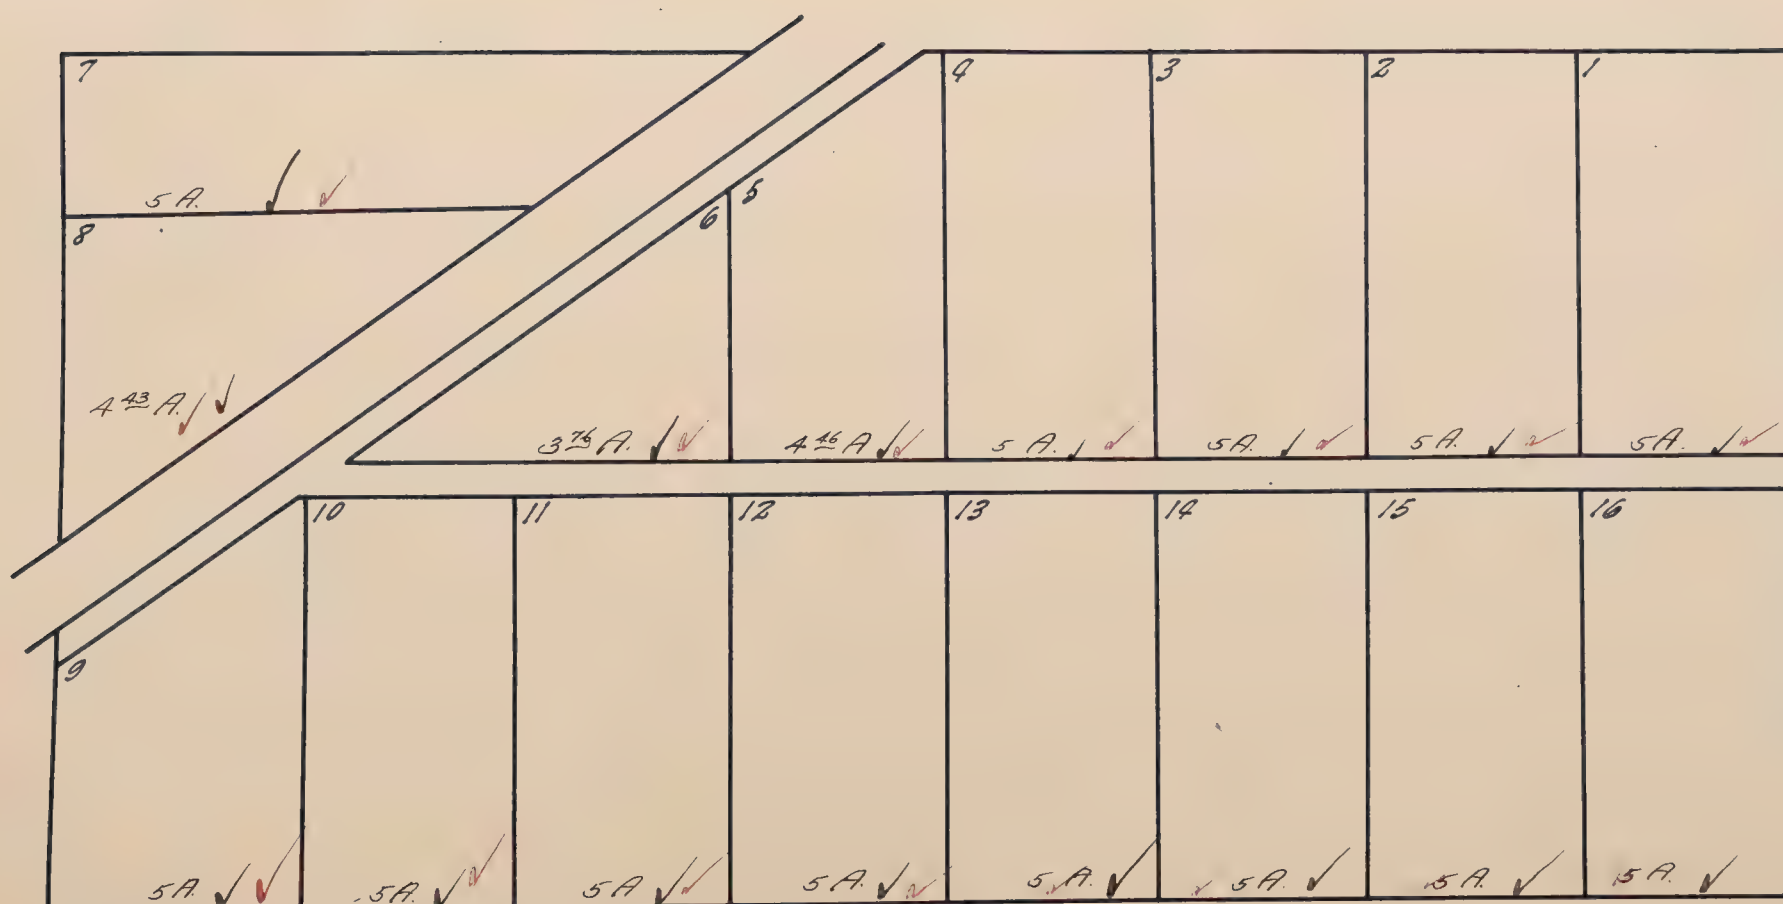

COPE SUBD. N^o 3.

LOCATED IN

N.E. 1/4 of Section 22, T.8 N.R.5E.

Scale: 1" = 40'

Black Ink-1919 Ownership
Red Ink-1920 Ownership

Blanks assessed to *State of Calif.*
T.P.M. Eldowney & Albert Patterson.

VINE STREET		Junction S.D.	
1	2	9	10
✓	✓	✓	✓
3		11	
✓		✓	
4		12	
✓		✓	
5		13	
✓		✓	
6		14	
✓		✓	
7		15	
✓		✓	
8		16	
✓		✓	

DUNCAN AVENUE

Mapped.

Black Ink-1919 Ownership
Red Ink-1929 Ownership

COPE SUBD. NO 6


LOCATED IN

NE. 1/4 of Section 22 T34N R3E

Santa Clara Co.

San Antonio S. D.


State of Calif.
Blanks assessed to *T. P. McEldowney & Albert Patterson* ✓

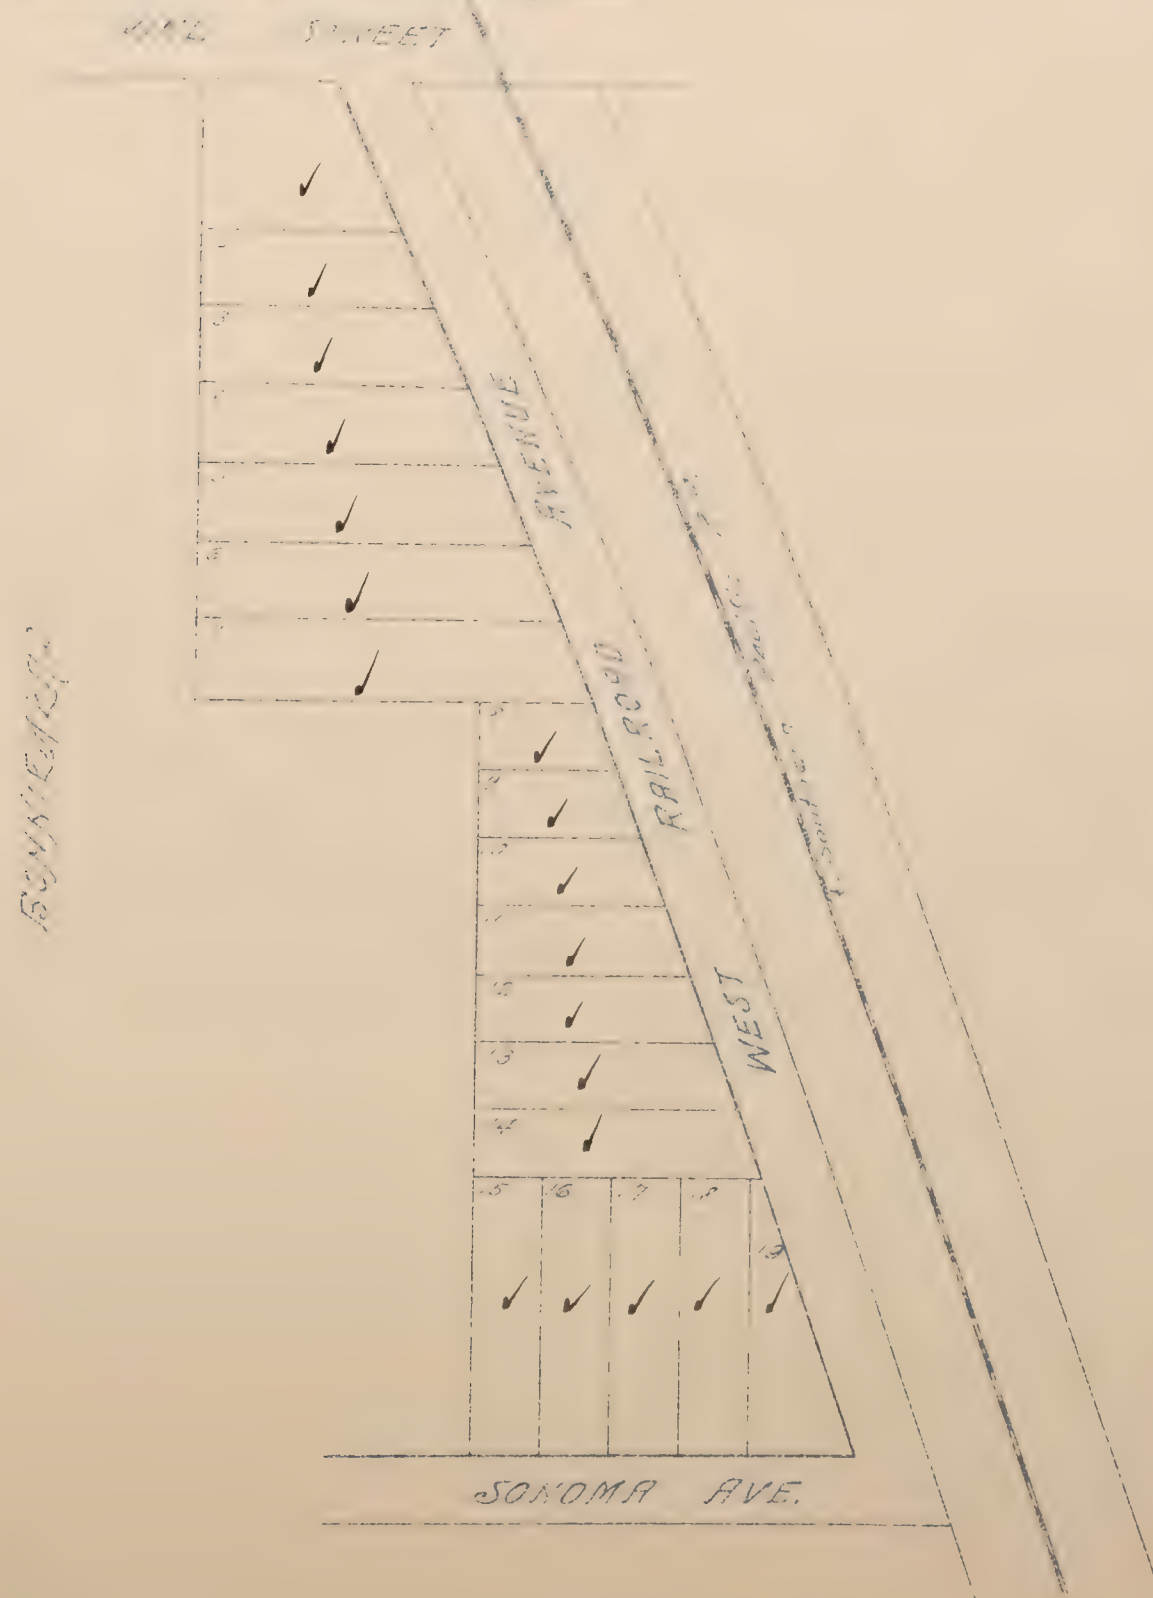

Blanks to J.O. Moore & B.W. Gay
All lots 5 Acres unless otherwise noted

SOLADO ACRES

Black Ink-1919 Ownership
Red Ink-1920 Ownership

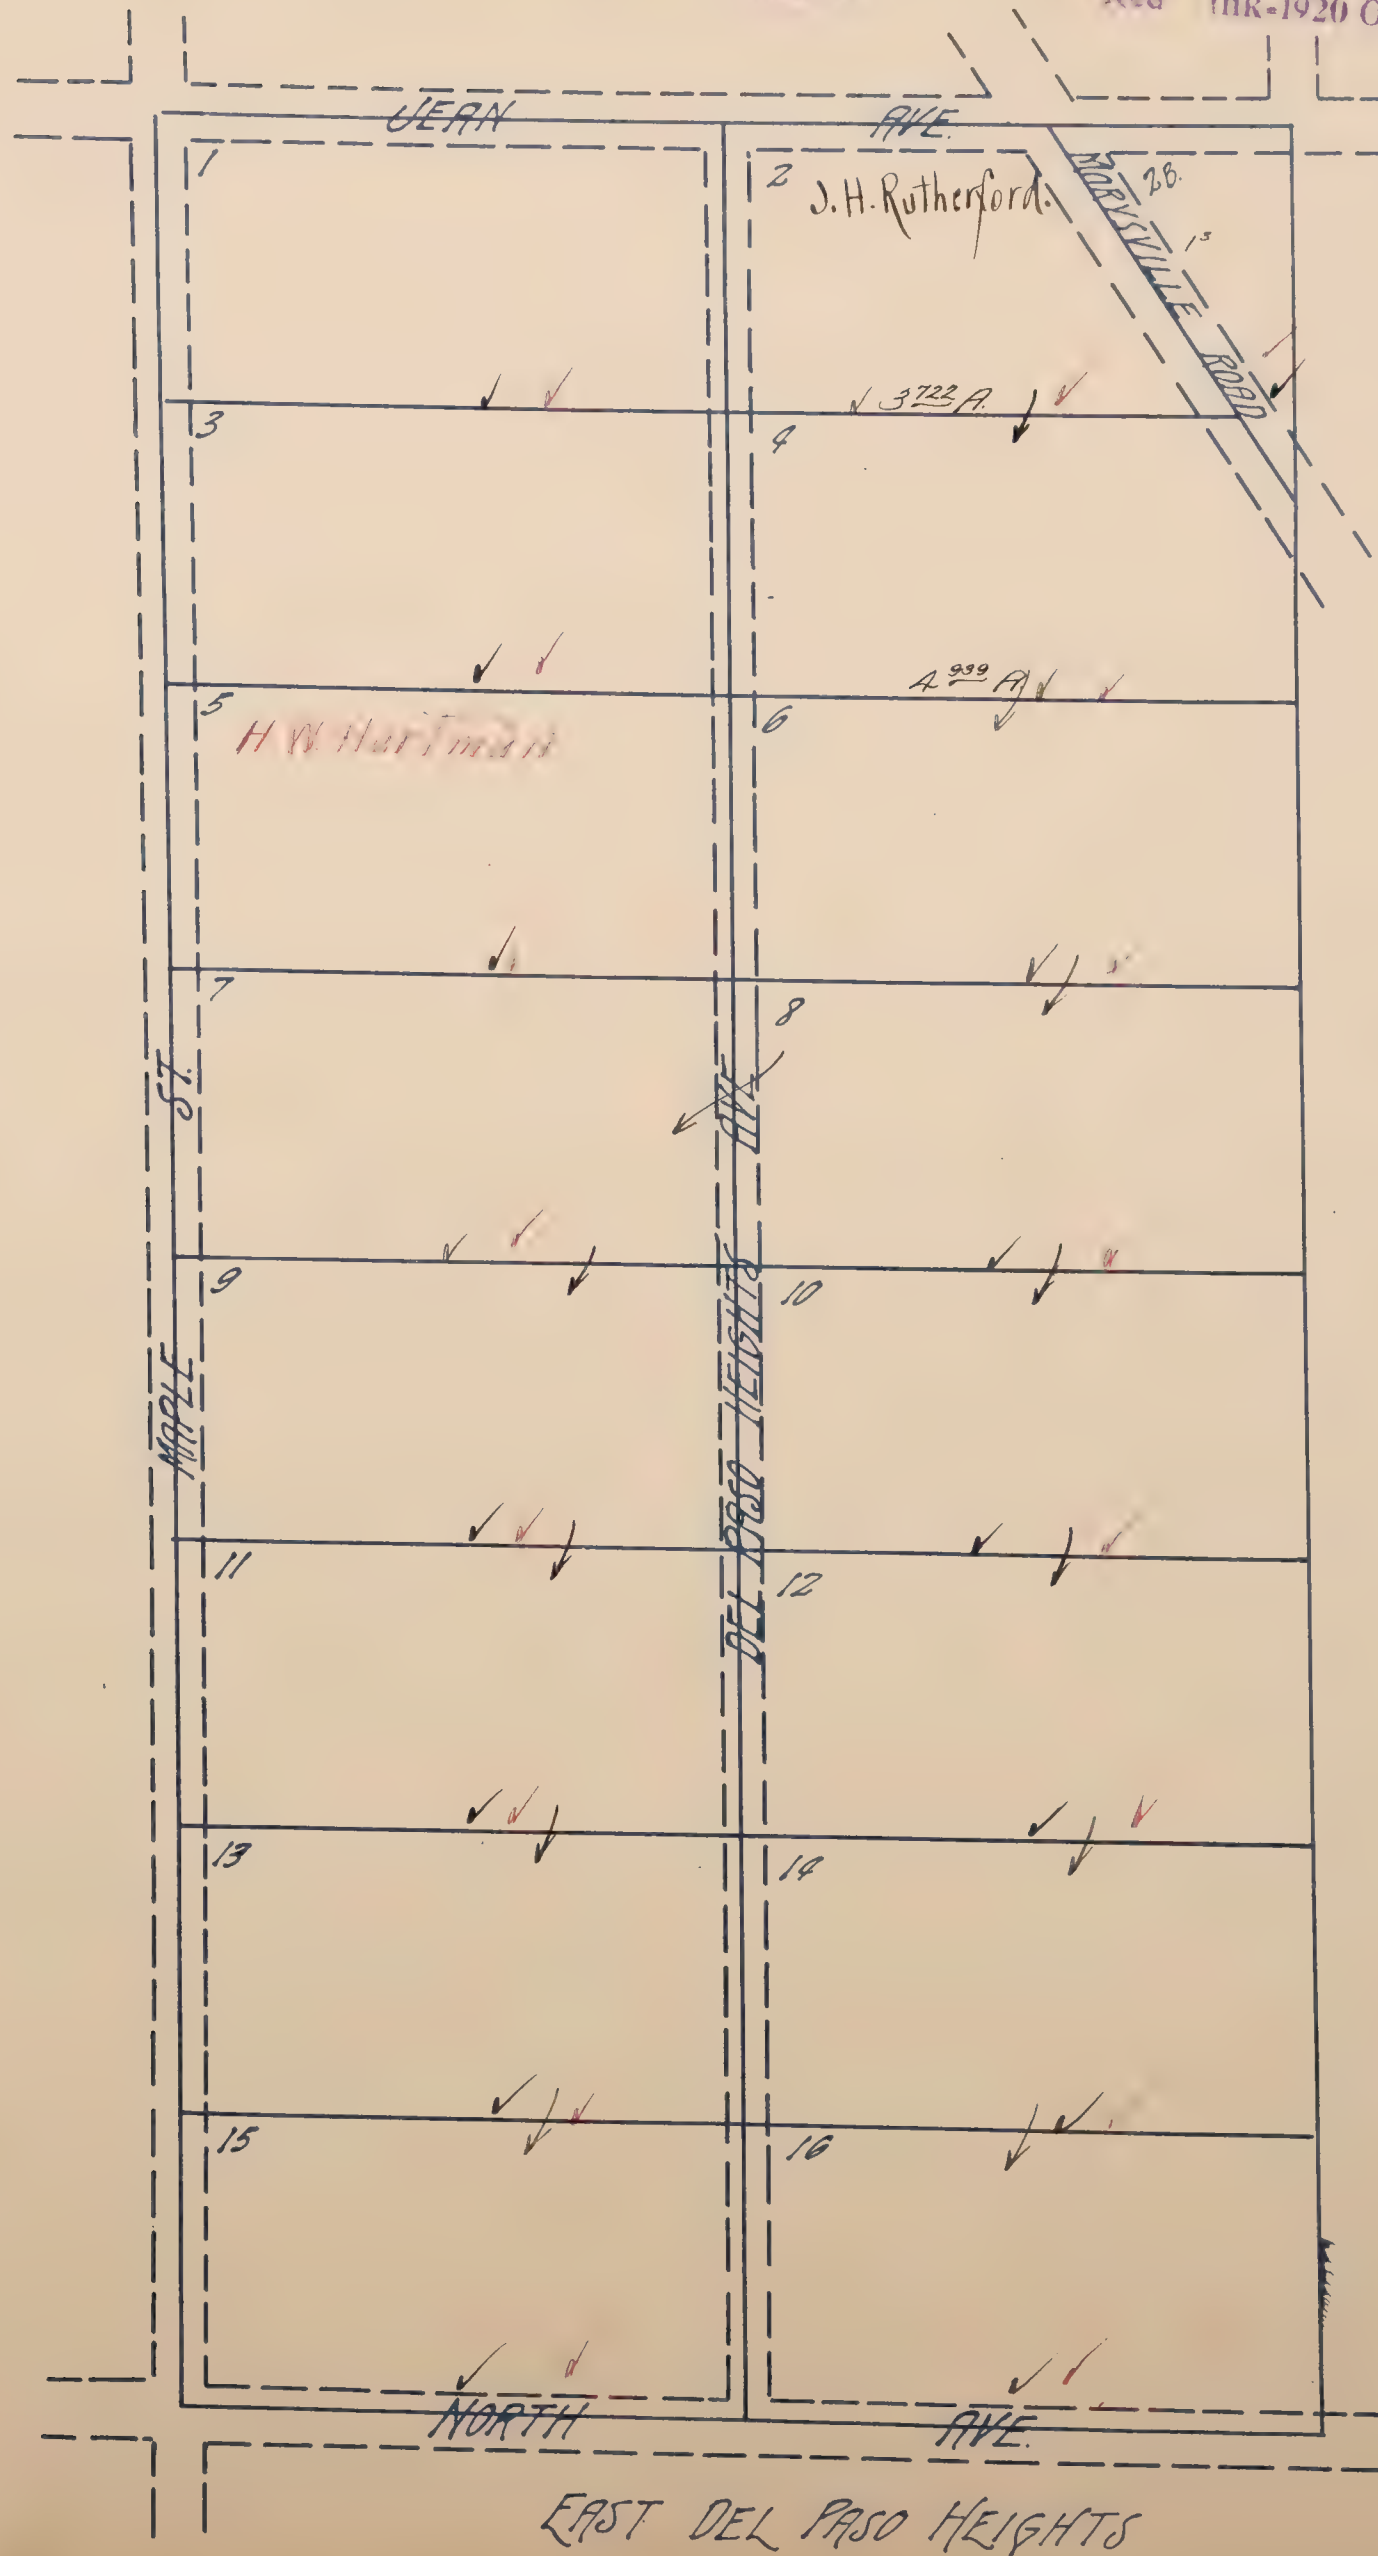

COPE SUB'D.N. NO. 11

located in
Rancho Del Paso
Scale: 1"=3chains

R. L. L.
OAK GROVE S.D.

CORDOVA

LOCATED IN
SECTION 31 T8NR5E.

CORDOVA



Black Ink-1919 Ownership
Red Ink-1920 Ownership

CORDOVA TOWNSITE.

LOCATED IN
SECTION 31 T 8 N R 5 E.

Scale 120 feet = 1 inch.

Pacific S D.

STREETS: PALM AVE., WALNUT AVE., POPLAR AVE., ELM AVE., CARNATION AVE., EL PARADERO.

LOT DATA:

Lot	Owner	Acreage	Notes
234	C.H. Neubourg & E.F. Silber	60'	
235		60'	
236		60'	
14
Mapped.
Black Ink-1919 Ownership
Red Ink-1920 Ownership


Blanks assessed to Hickman-Coleman Co. ✓

CORDOVA TOWNSITE

LOCATED IN
SECTION 31 T 8 N R 5 E

Scale 120 feet = 1 inch.

Pacific S.D.

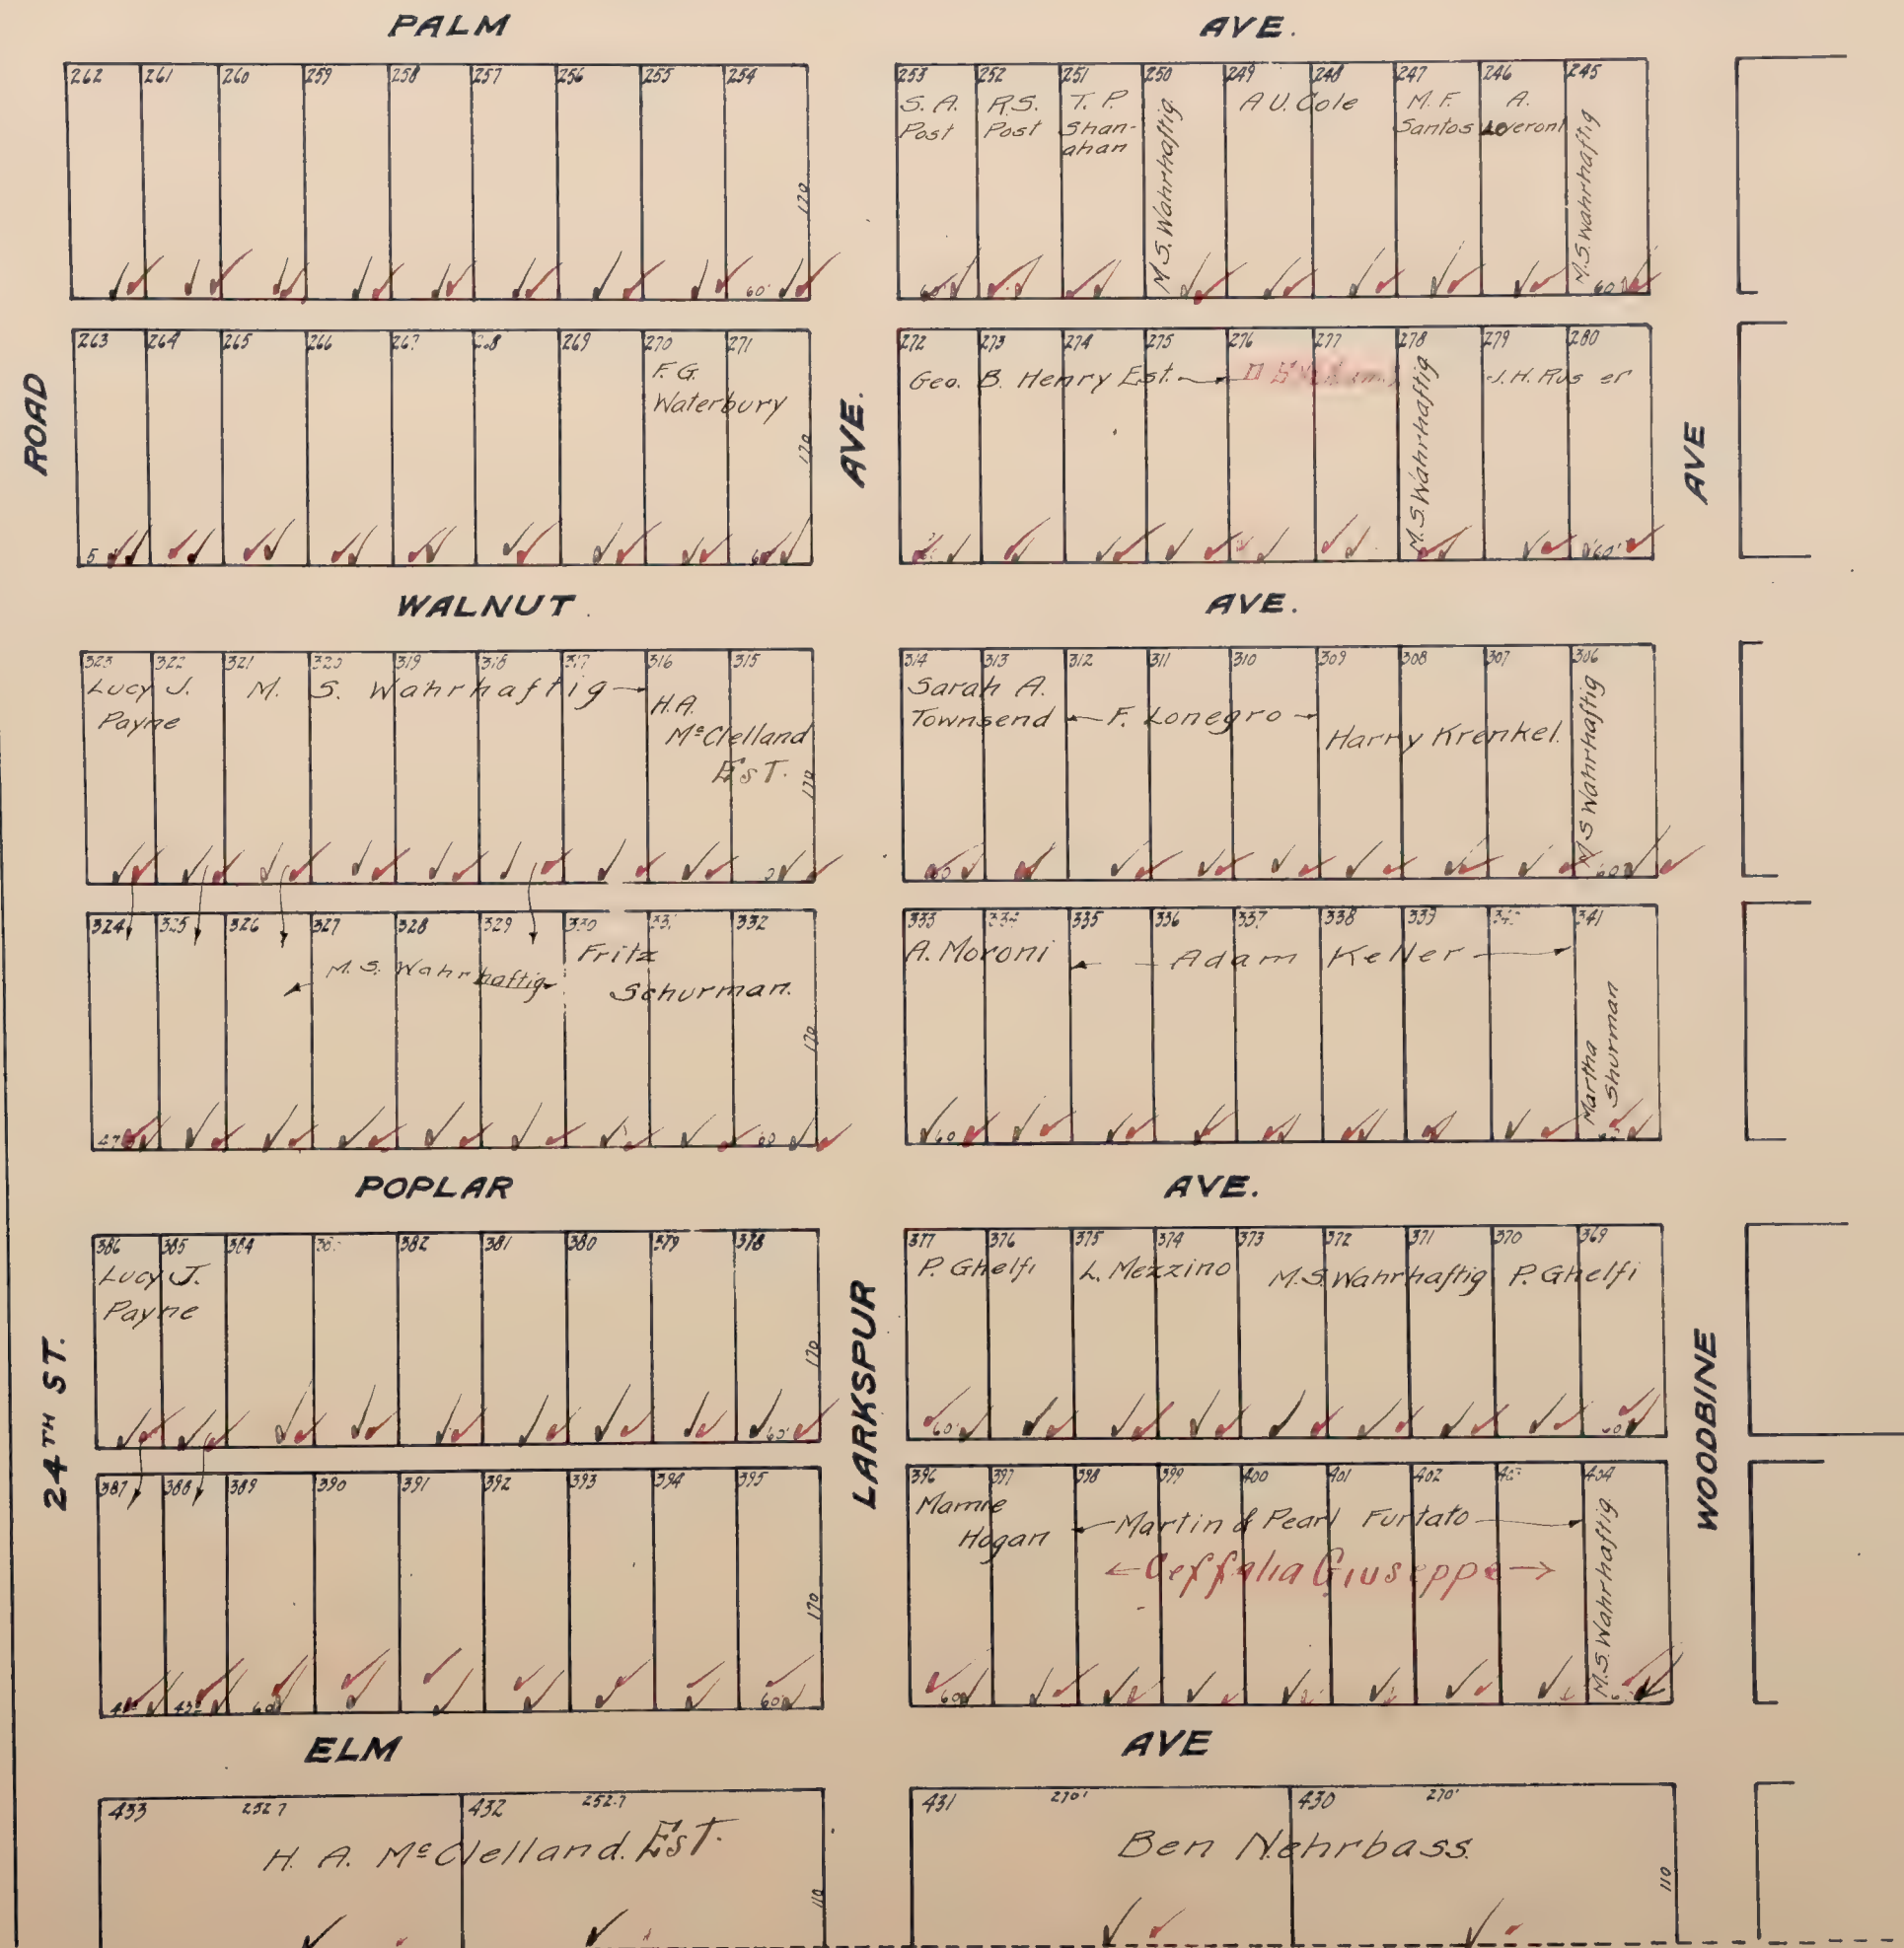

Mapped.


Black Ink-1919 Ownership
Red Ink-1920 Ownership

CORDOVA TOWNSITE.

LOCATED IN
SECTION 31 T 8 N R 5 E

Scale 120 feet = 1 inch.

Pacific S.D.

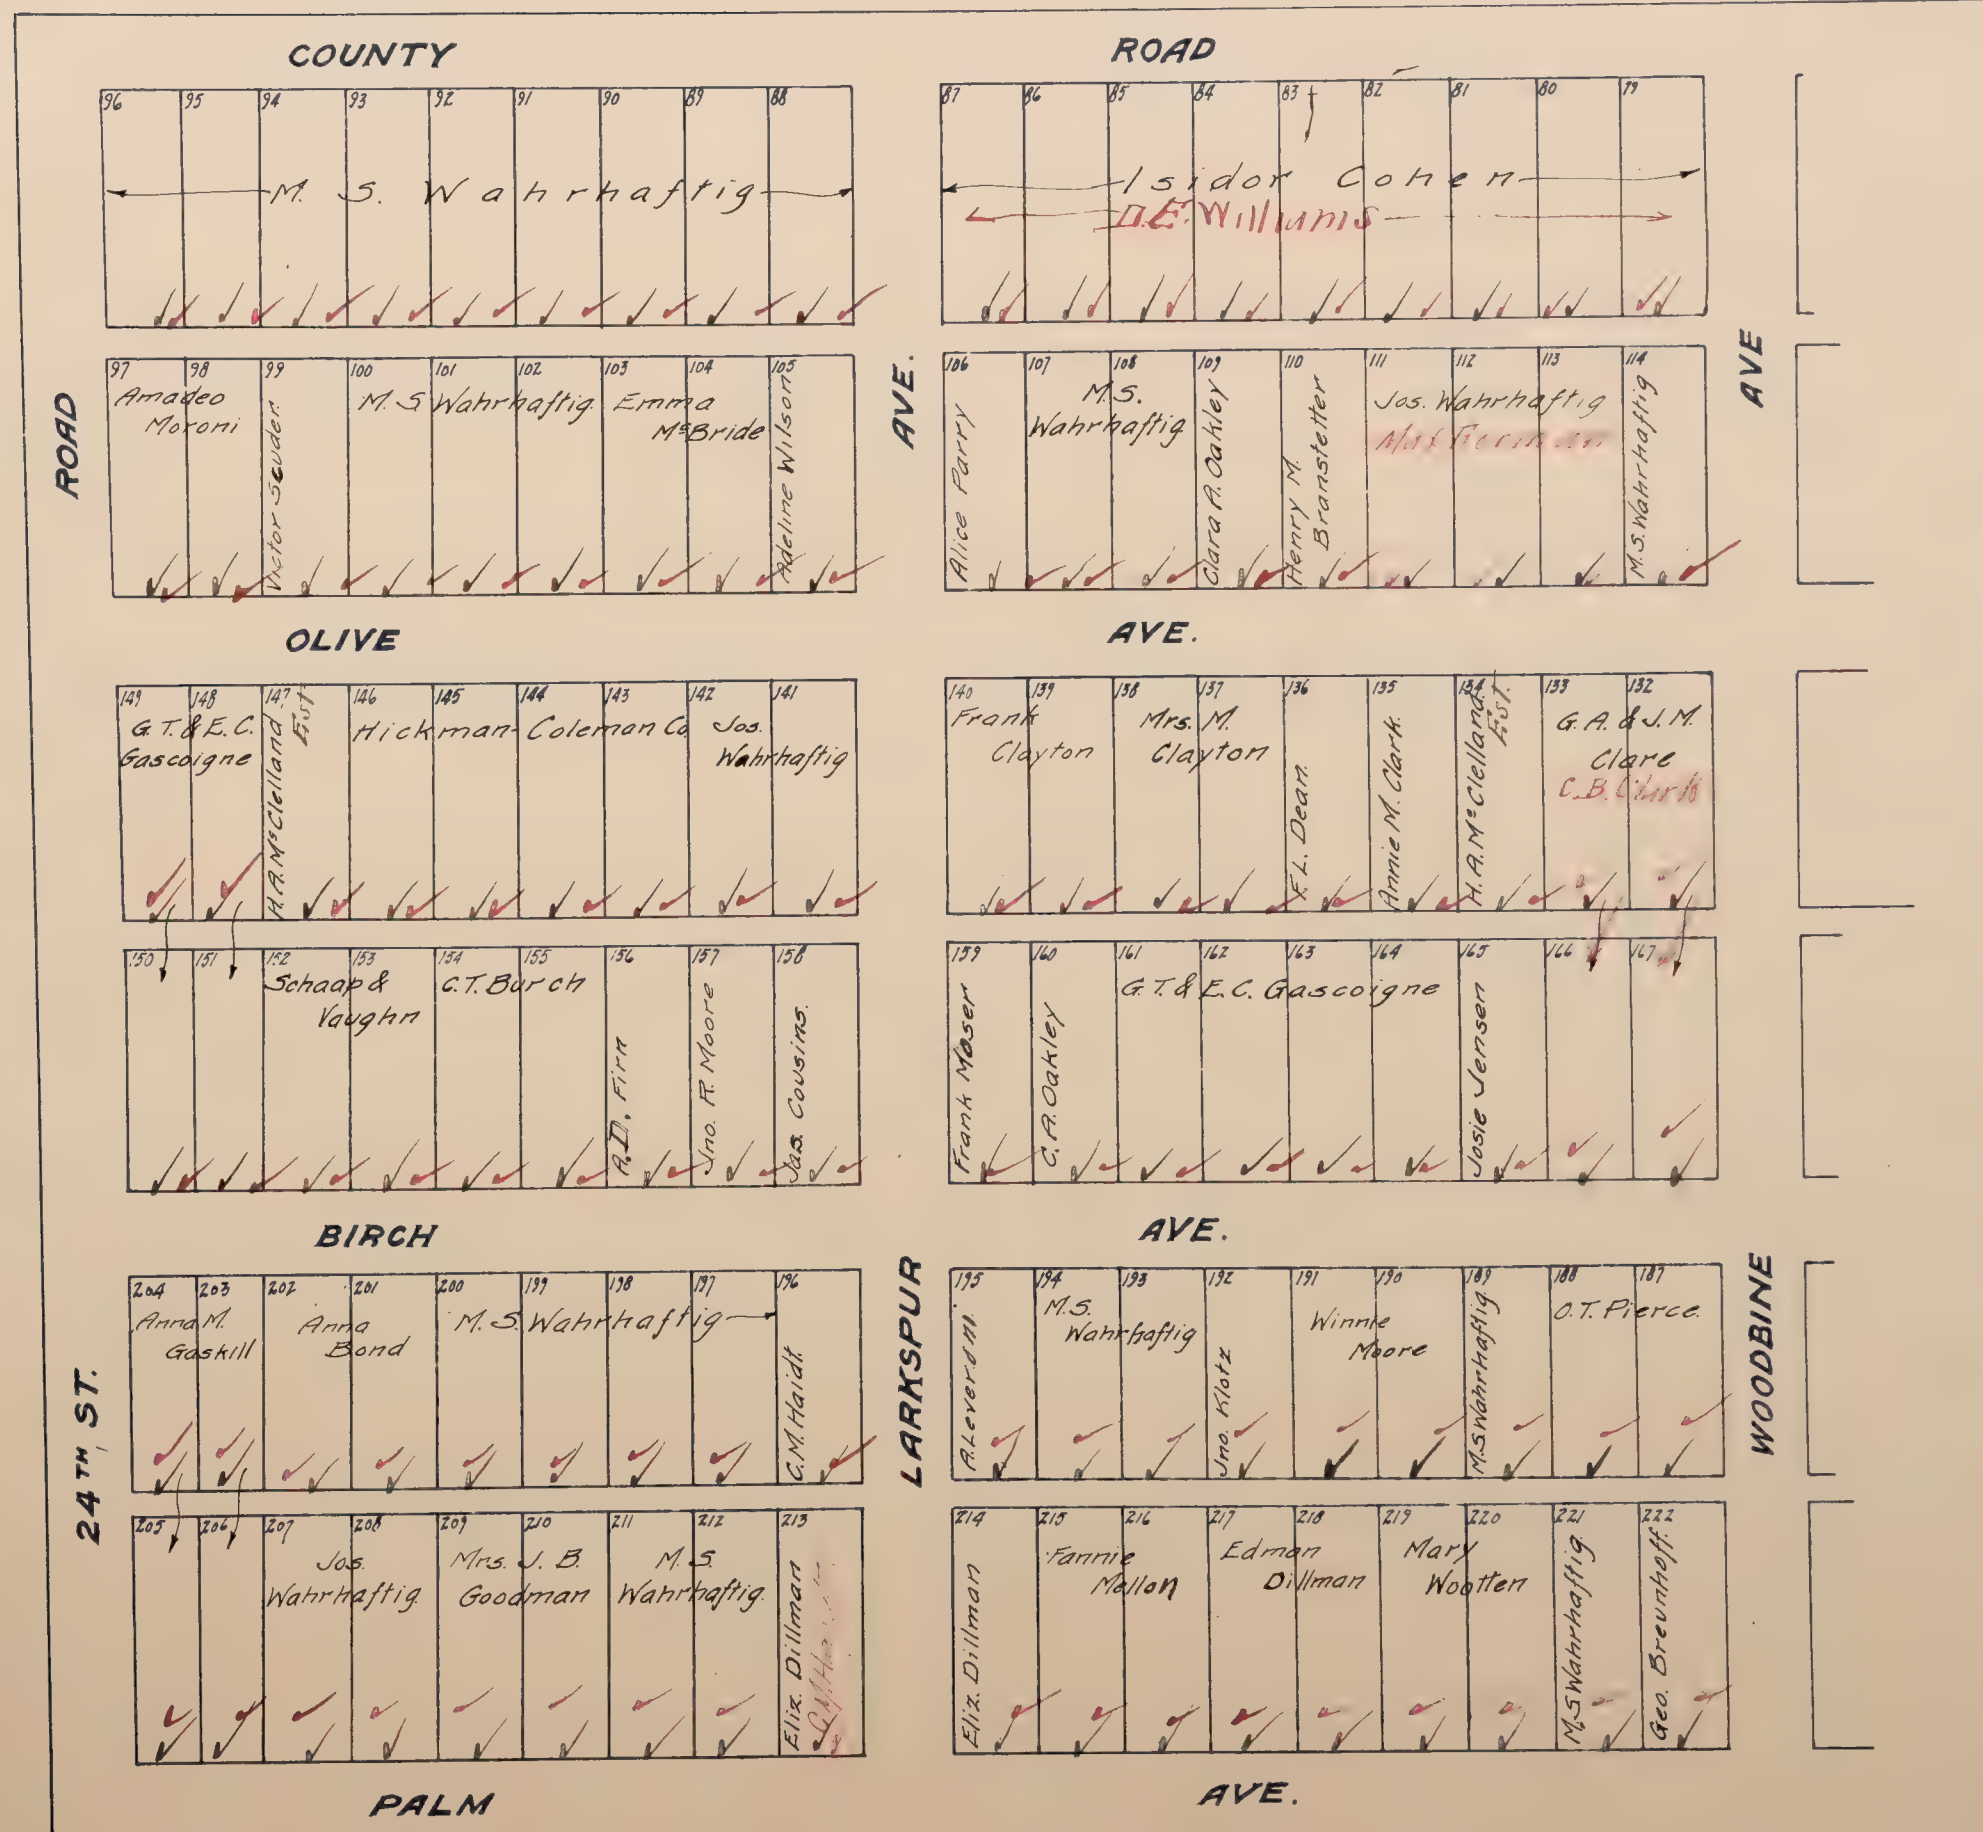


Black Ink=1919 Ownership
Red Ink=1920 Ownership

COURTLAND

Scale 100 feet = 1 inch

Onisbo S.D.

✓ Methodist Episcopal Church. Lot 60' x 110'

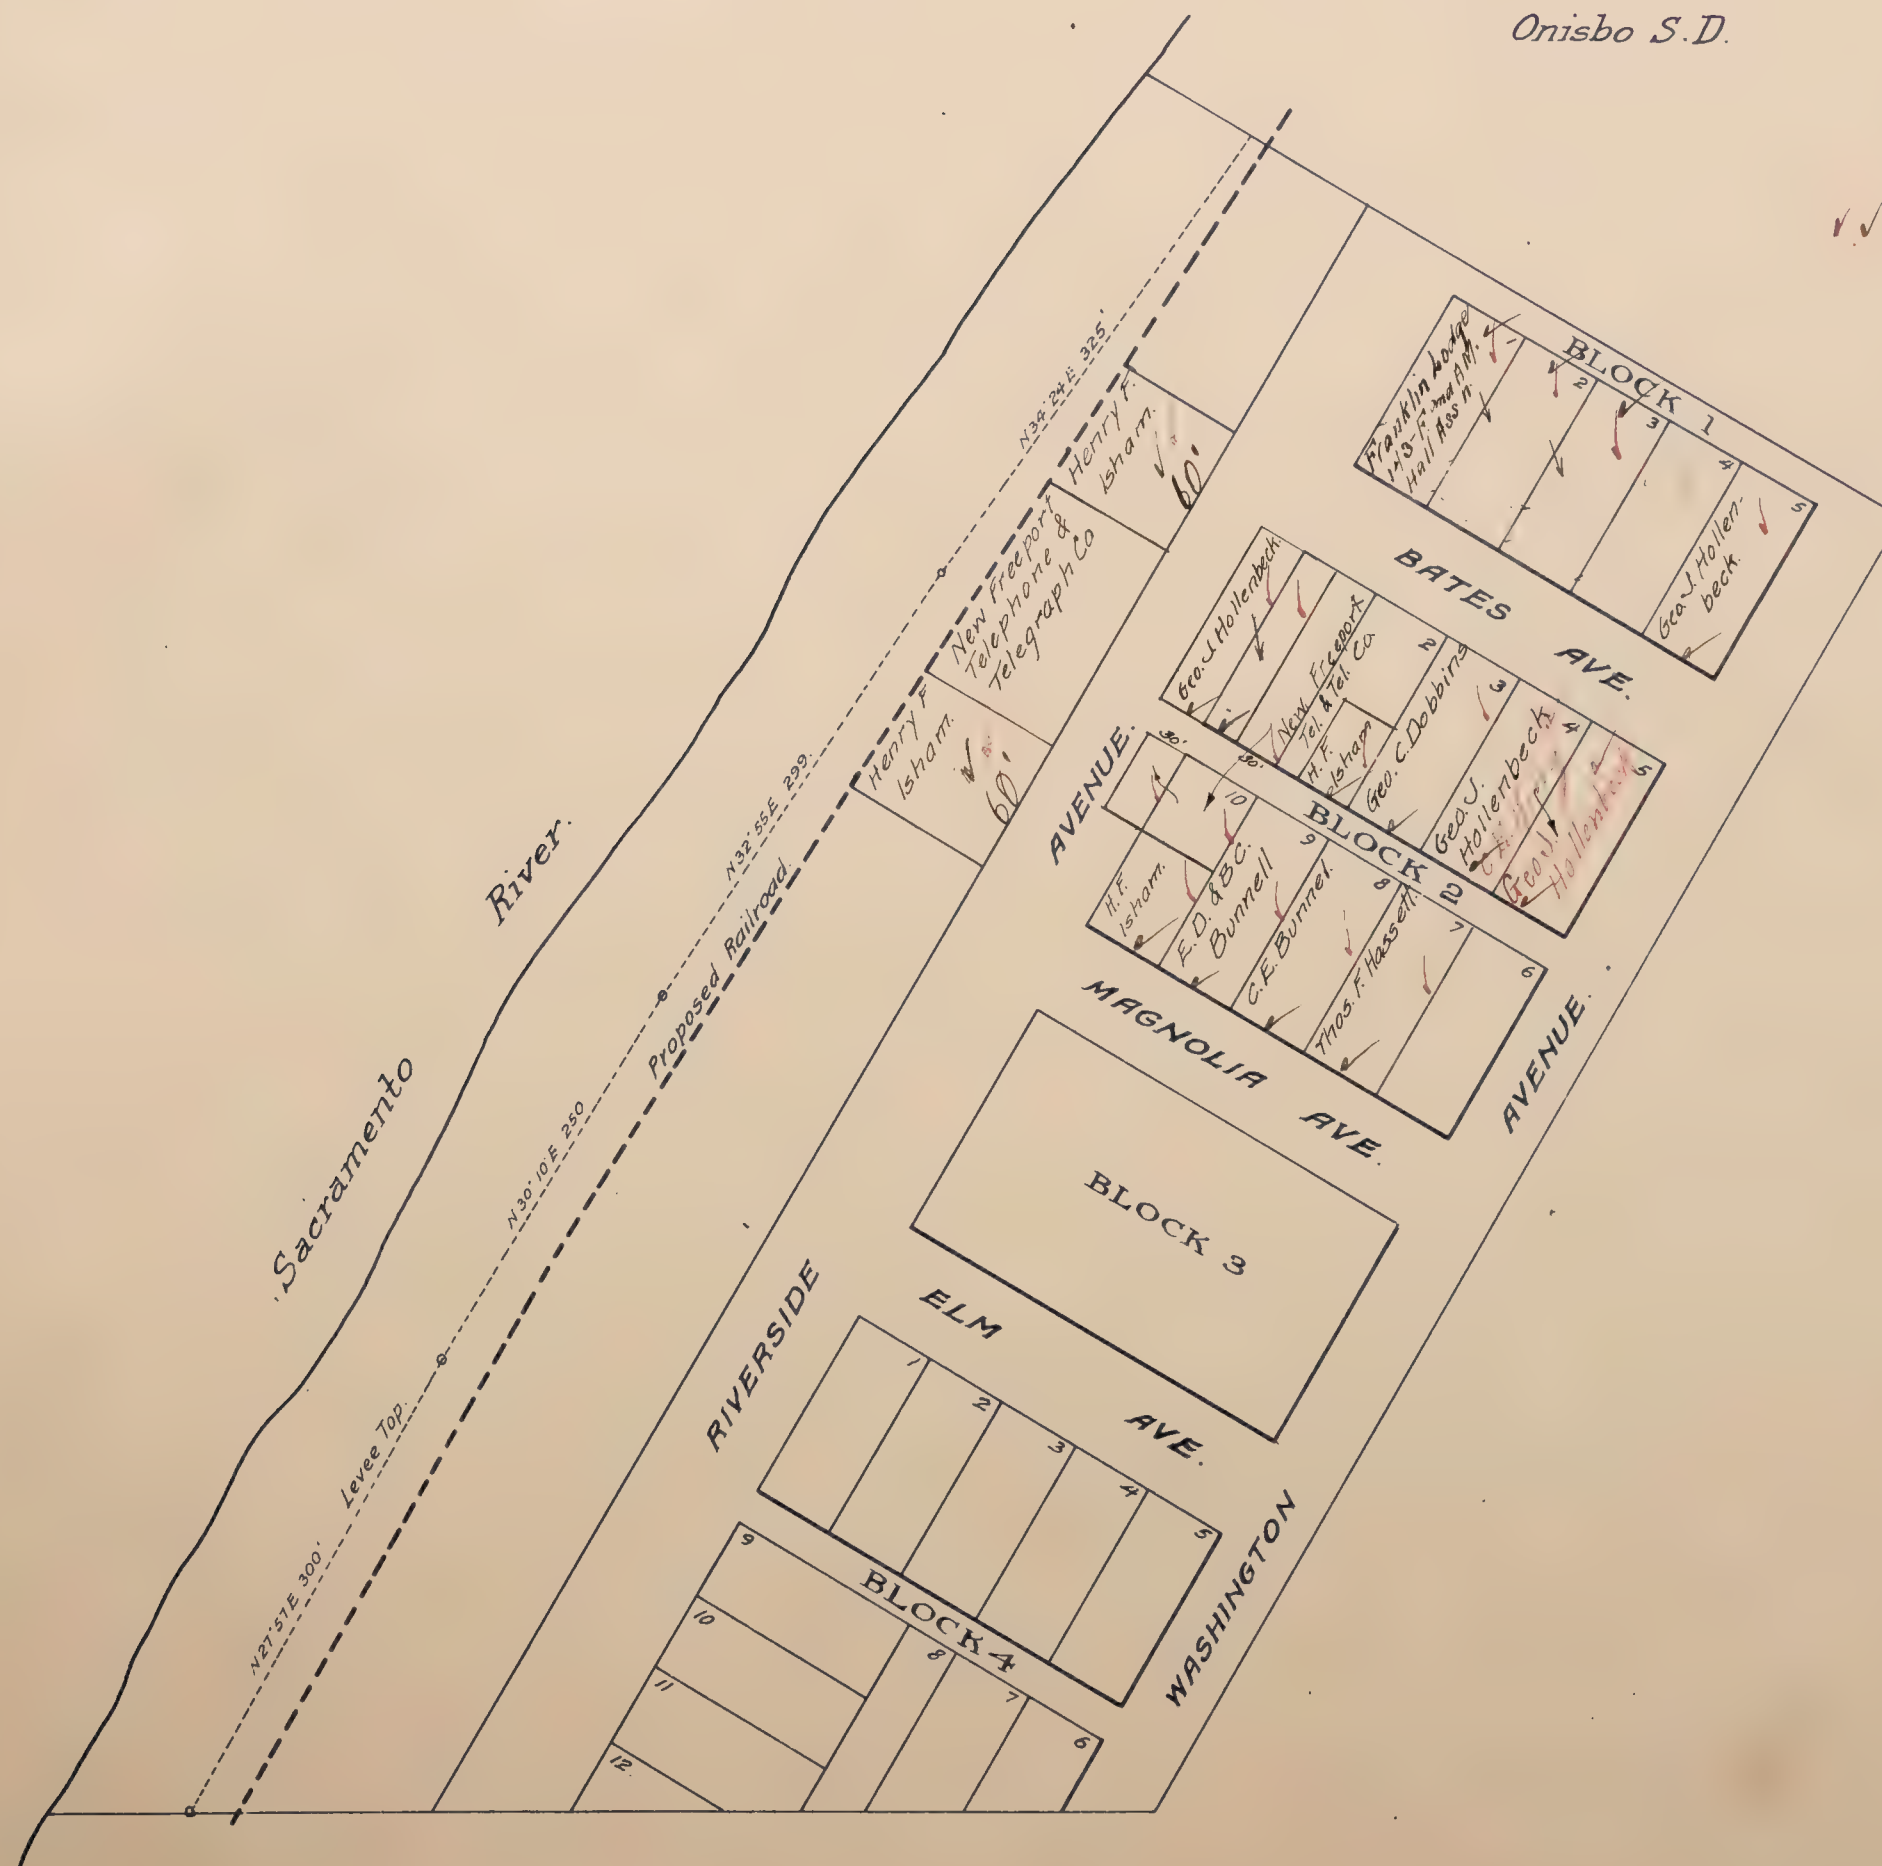

COURTLAND


Black Ink-1919 Ownership
Red Ink-1920 Ownership

J. F. CROSS SUBDIVISION

LOCATED IN SEC'S 20&21 T10N R6E.

Scale 10 chains = 1 inch.

Blanks to Cross Invest. Co. & W.E. & Ida Hyde. ✓ Dry Creek S.D.
All Lots 10 Acres unless otherwise noted.

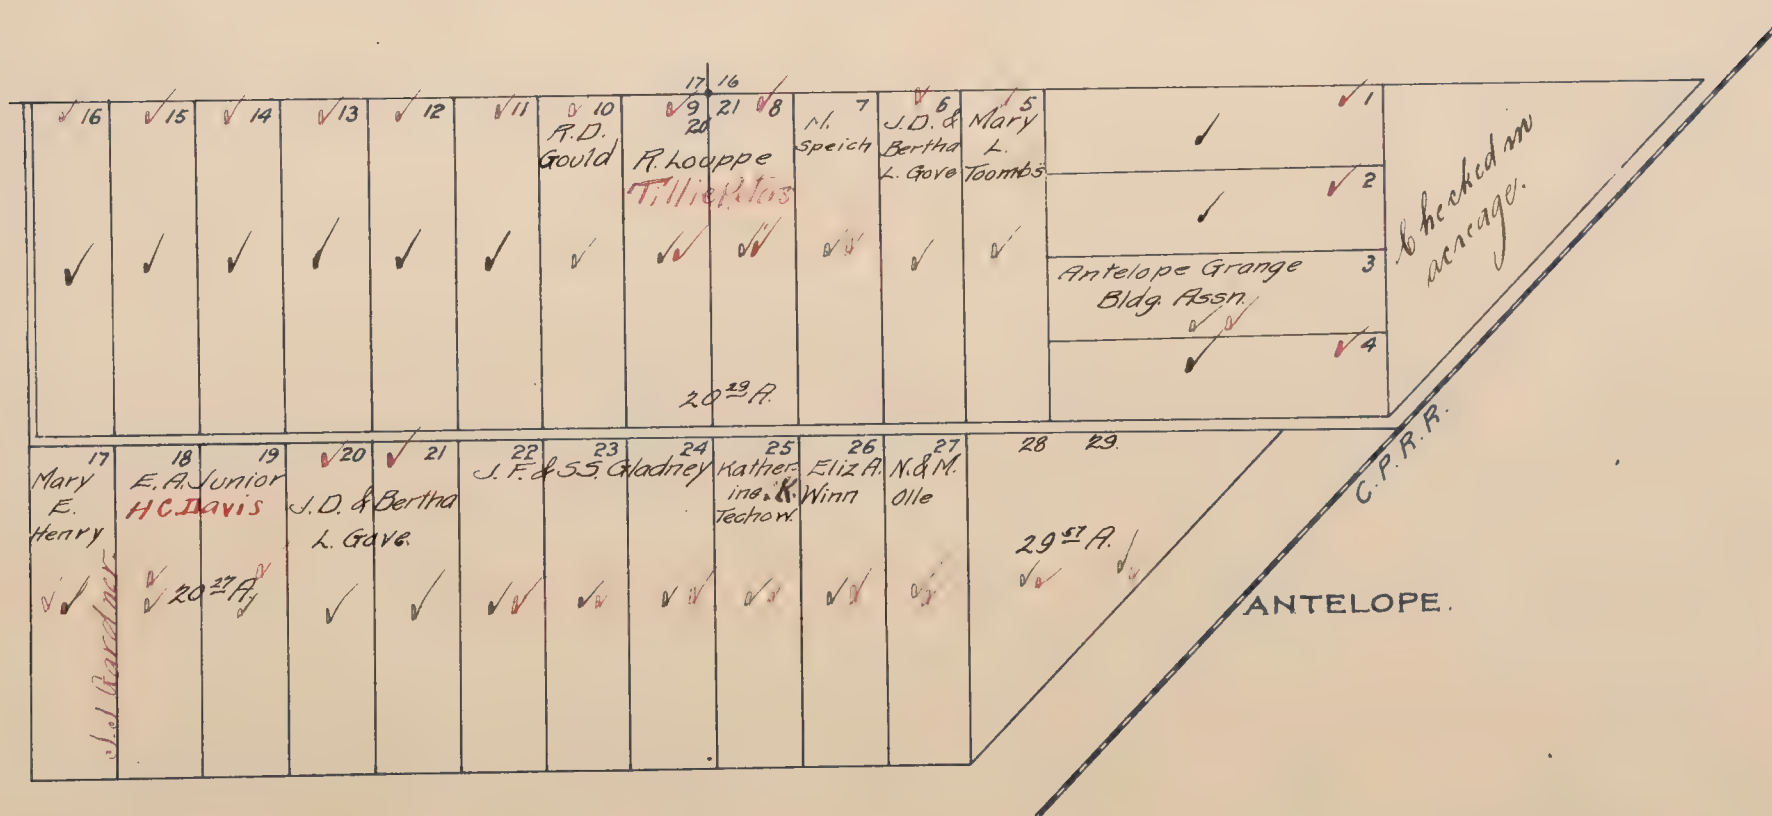

CROSS

